
PLAT OF SURVEY

LOT 4, MIRAMAR ADDITION NO. 2, BEING A SUBDIVISION OF THE NORTHEAST 1/4 OF SECTION 10 AND THE NORTHWEST 1/4 OF SECTION 11, TOWN 4 NORTH, RANGE 18 EAST, IN THE TOWN OF EAST TROY, WALWORTH COUNTY, WISCONSIN.

SURVEYED FOR: COLE MISCHKER

SURVEY ADDRESS: W928 HARMONY LANE

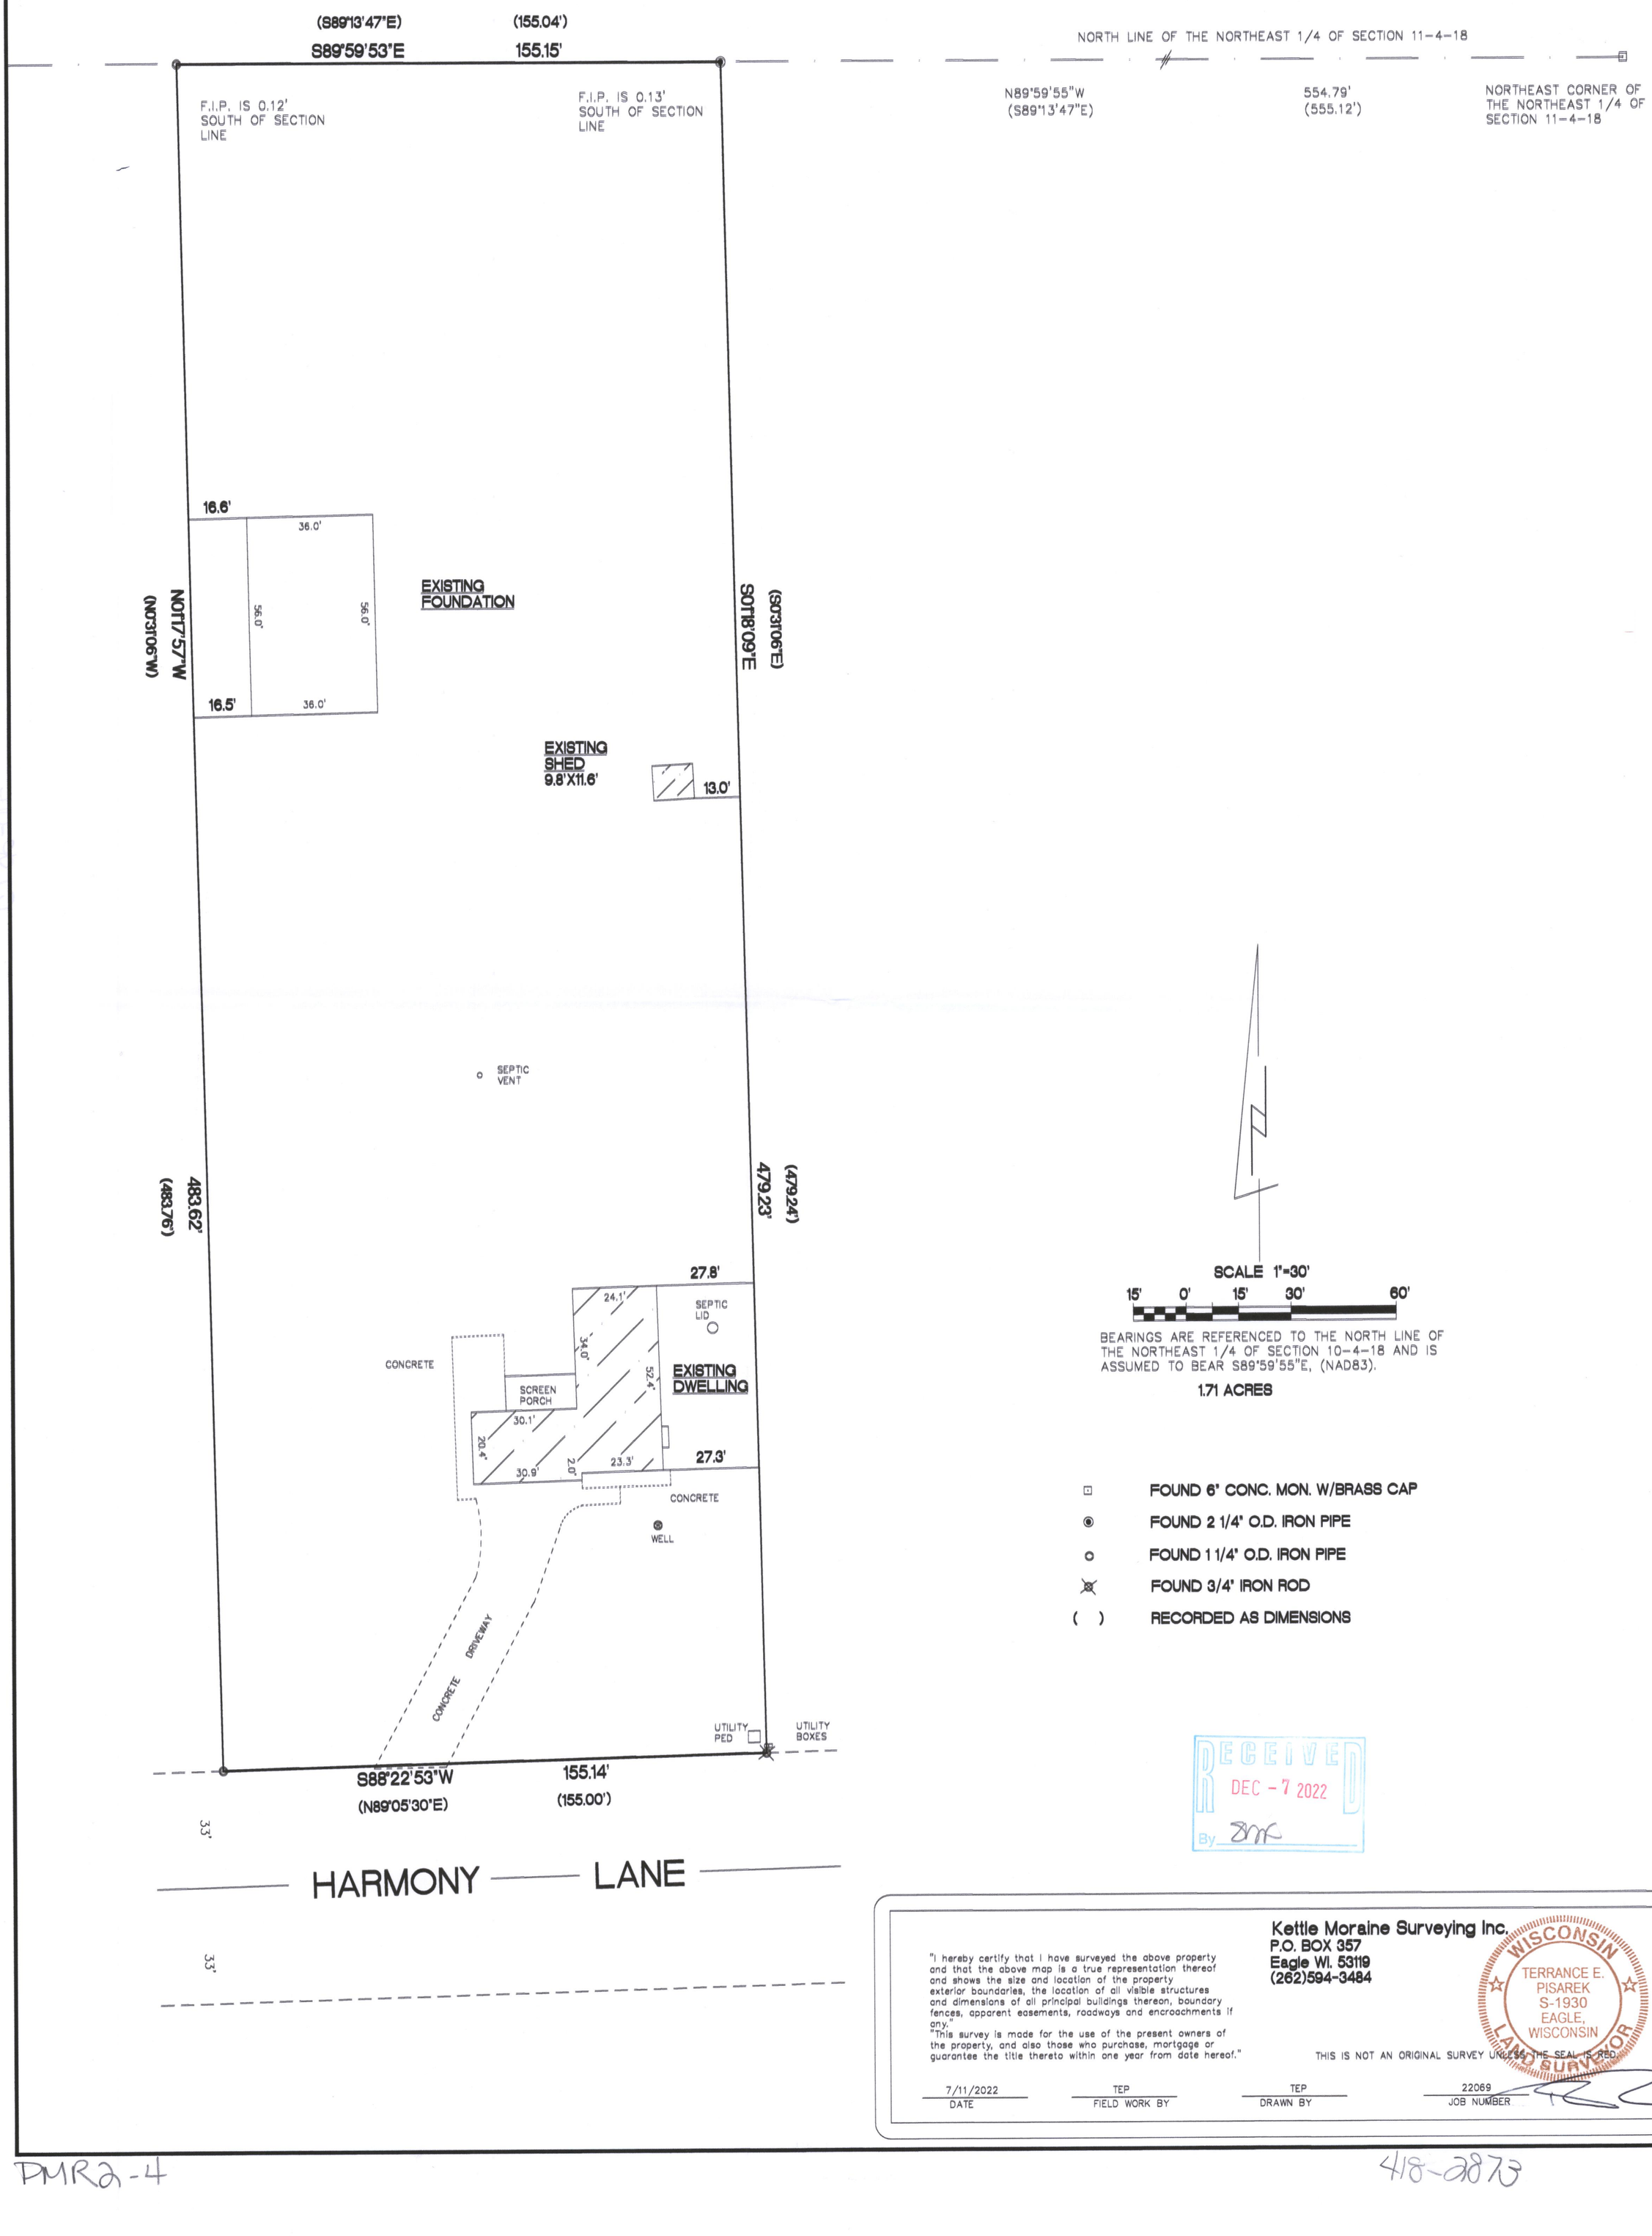

BEARINGS ARE REFERENCED TO THE NORTH LINE OF THE NORTHEAST 1/4 OF SECTION 10-4-18 AND IS ASSUMED TO BEAR S89°59'55"E, (NAD83).

1.71 ACRES

- ⊡ FOUND 6" CONC. MON. W/BRASS CAP
- ◉ FOUND 2 1/4" O.D. IRON PIPE
- ○ FOUND 1 1/4" O.D. IRON PIPE
- ⊗ FOUND 3/4" IRON ROD
- ( ) RECORDED AS DIMENSIONS

RECEIVED
DEC - 7 2022
By

"I hereby certify that I have surveyed the above property and that the above map is a true representation thereof and shows the size and location of the property exterior boundaries, the location of all visible structures and dimensions of all principal buildings thereon, boundary fences, apparent easements, roadways and encroachments if any."
"This survey is made for the use of the present owners of the property, and also those who purchase, mortgage or guarantee the title thereto within one year from date hereof."

Kettle Moraine Surveying Inc.
P.O. BOX 357
Eagle WI. 53119
(262)594-3484

WISCONSIN
TERRANCE E. PISAREK
S-1930
EAGLE, WISCONSIN
LAND SURVEYOR

THIS IS NOT AN ORIGINAL SURVEY UNLESS THE SEAL IS RED

7/11/2022	TEP	TEP	22069
DATE	FIELD WORK BY	DRAWN BY	JOB NUMBER

PMR2-4

418-2873