
PLAT OF SURVEY

LOTS 8 AND 9 BLOCK 13, MIRAMAR SUBDIVISION, BEING A PART OF SECTIONS 10 AND 11, TOWN 4 NORTH, RANGE 18 EAST, TOWN OF EAST TROY, WALWORTH COUNTY, WISCONSIN.

SURVEYED FOR: HOLLY WRAY
PROPERTY ADDRESS: N9170 HICKORY STREET

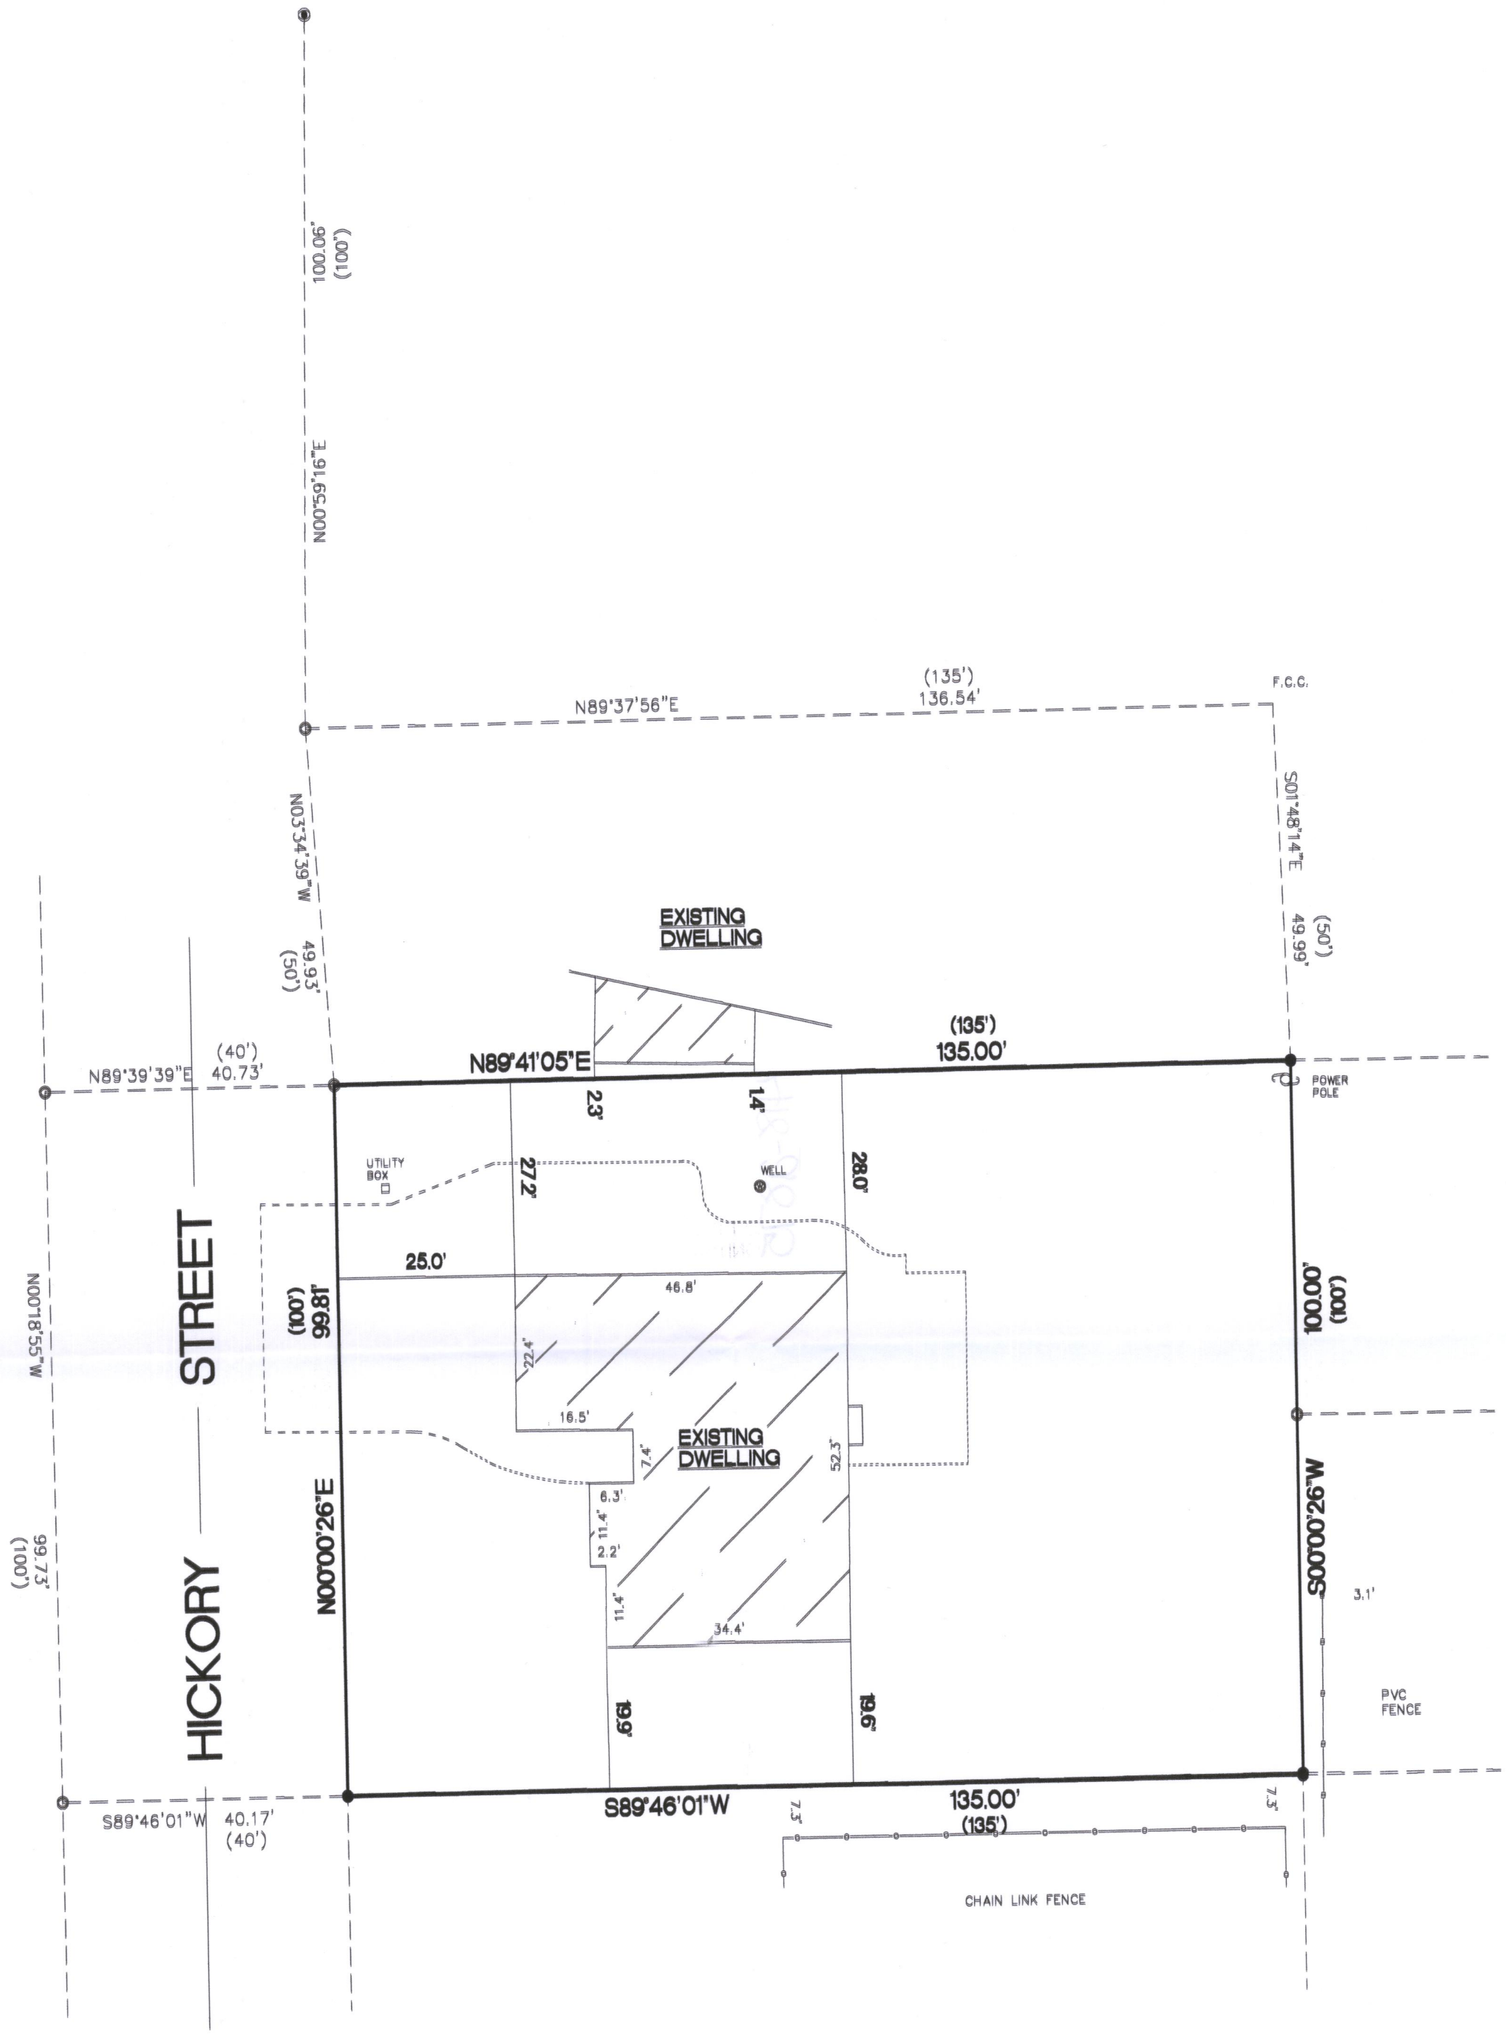

SCALE 1"=20'

10' 0' 10' 20' 40'

BEARINGS ARE REFERENCED TO THE EAST LINE OF THE NORTHEAST 1/4 OF SECTION 10-4-18 AND IS ASSUMED TO BEAR N00°15'42"W, (NAD83).

13487 SQ. FT.

o	FOUND 1 1/4" O.D. IRON PIPE
F.C.C.	FOUND CHISELED CROSS
◉	FOUND 'MAG' NAIL
●	SET 1 1/4" O.D. IRON PIPE
( )	RECORDED AS DIMENSIONS

RECEIVED
DEC - 7 2022
By SMF

"I hereby certify that I have surveyed the above property and that the above map is a true representation thereof and shows the size and location of the property, its exterior boundaries, the location of all visible structures and dimensions of all principal buildings thereon, boundary fences, apparent easements, roadways and encroachments if any."

"This survey is made for the use of the present owners of the property, and also those who purchase, mortgage or guarantee the title thereto within one year from date hereof."

Kettle Moraine Surveying Inc.
P.O. Box 357
Eagle WI. 53119
(262)594-3484
kettlemoralnesurvey.com

WISCONSIN
TERRANCE E. PISAREK
S-1930
EAGLE, WISCONSIN
LAND SURVEYOR

THIS IS NOT AN ORIGINAL SURVEY UNLESS THE SEAL IS RED.

5/19/2022	TEP	TEP	22042
DATE	FIELD WORK BY	DRAWN BY	JOB NUMBER

PMR - 147

4/8-2015