April 29, 2024

PLAT OF SURVEY
AS-BUILT SURVEY

Survey No. 21.5133

LOCATION: W1758 & W1762 South Shore Drive, East Troy, WI
PREPARED FOR: Dave Knecht
PROPERTY DESCRIPTION:


Lots 1 and 2 in Chamberlin's Subdivision, being sometimes known as Chamberlain's Subdivision, a subdivision located in the Northwest 1/4 of Section 9, Township 4 North, Range 18 East, Town of East Troy, Walworth County, Wisconsin.


Excepting therefrom all that portion of Lot 2 as is set forth in a Warranty Deed from Stewart C. Brown to Gerson C. Bernhard and Arlyne Sandra Bernhard recorded in Volume 247 of Records on Page 354 as Document No. 55688.

Excepting therefrom all that portion of Lot 1 as is set forth in a Warranty Deed from Timothy J. Kumbier and Margaret Kumbier Living Trust recorded as Document No. 1022509 in the Walworth County Register of Deeds.

CURRENT OWNER: Steve Menza
TAX ID: PCT00001

HOUSE DETAIL

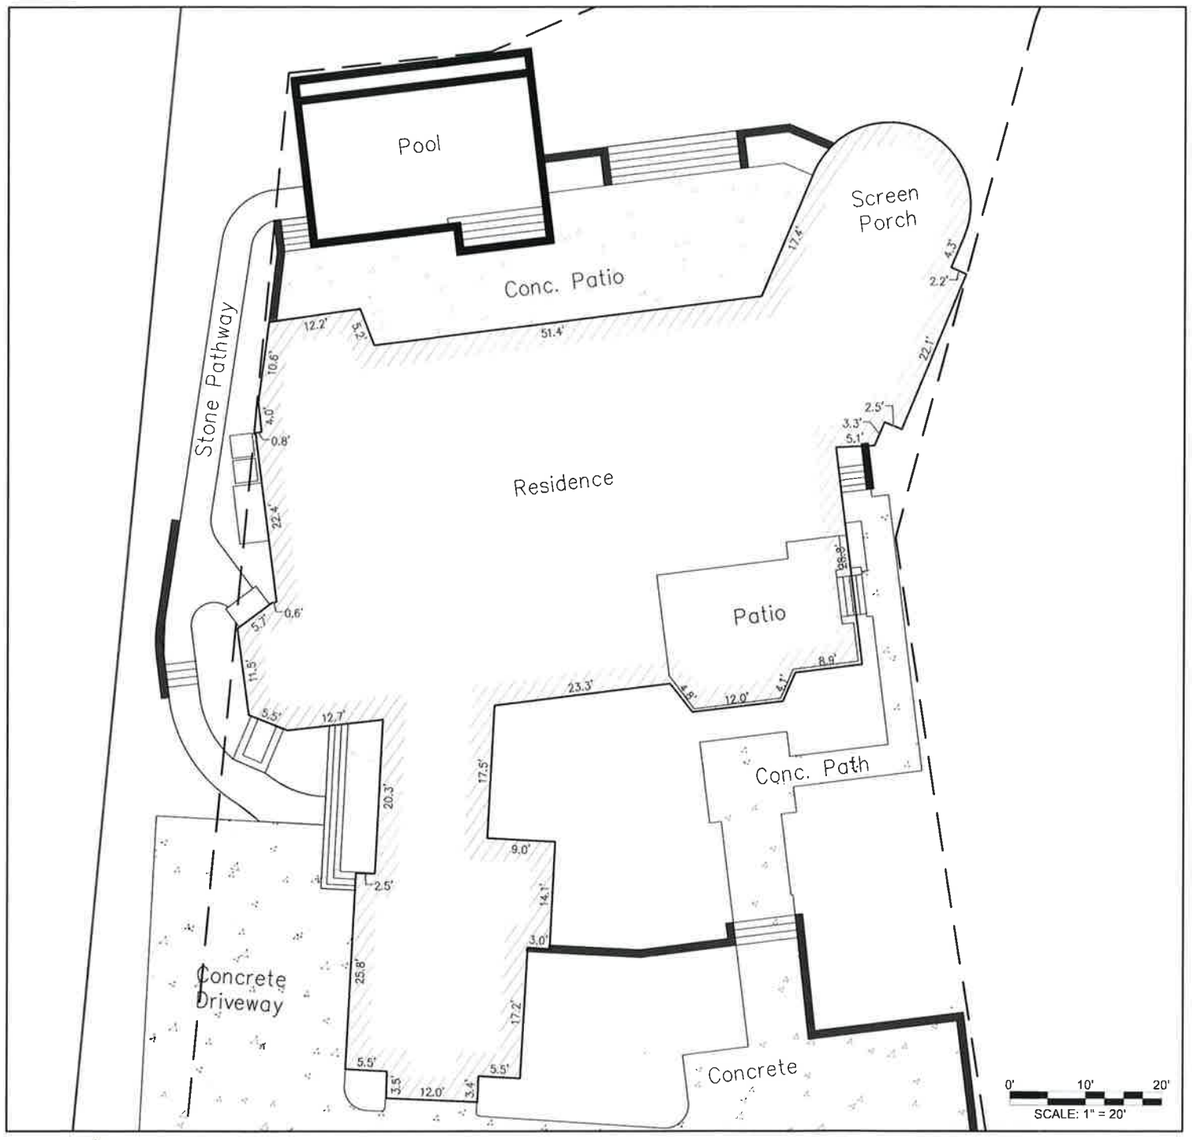

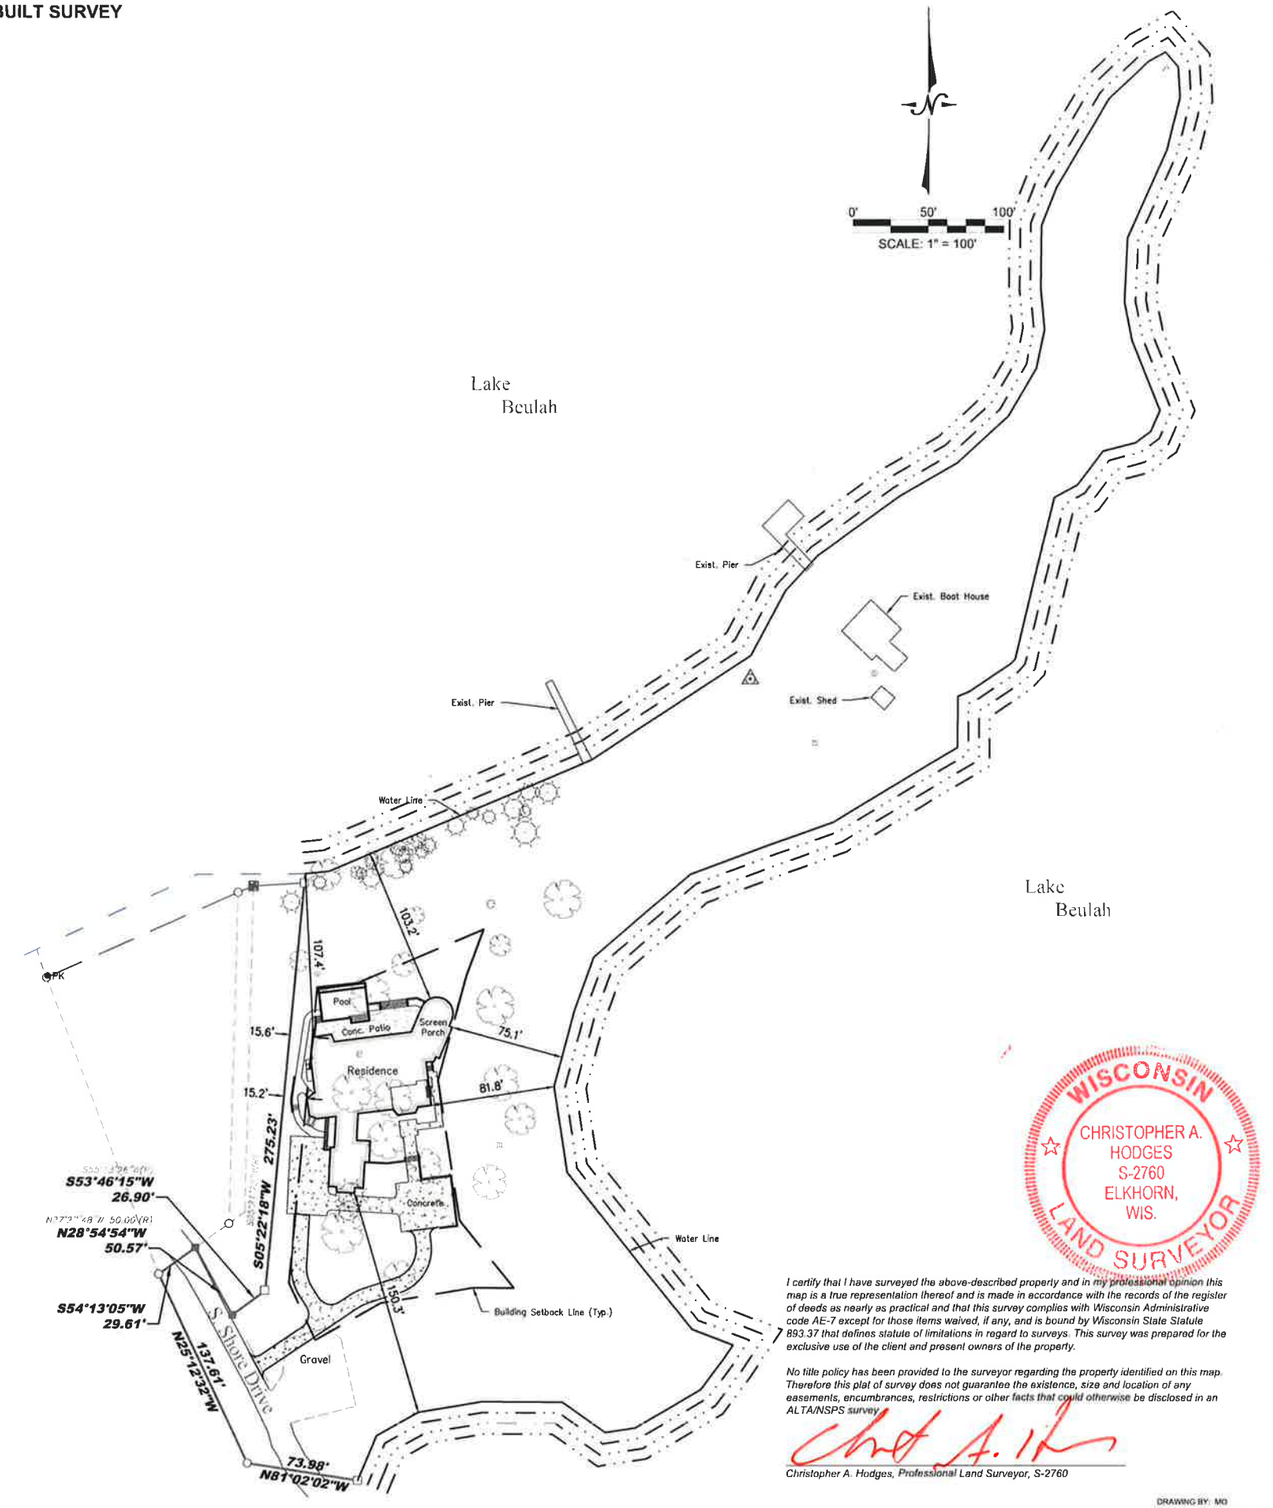

WISCONSIN
CHRISTOPHER A. HODGES
S-2760
ELKHORN, WIS.
LAND SURVEYOR

I certify that I have surveyed the above-described property and in my professional opinion this map is a true representation thereof and is made in accordance with the records of the register of deeds as nearly as practical and that this survey complies with Wisconsin Administrative code AE-7 except for those items waived, if any, and is bound by Wisconsin State Statute 893.37 that defines statute of limitations in regard to surveys. This survey was prepared for the exclusive use of the client and present owners of the property.

No title policy has been provided to the surveyor regarding the property identified on this map. Therefore this plat of survey does not guarantee the existence, size and location of any easements, encumbrances, restrictions or other facts that could otherwise be disclosed in an ALTA/NSPS survey.

Christopher A. Hodges, Professional Land Surveyor, S-2760

DRAWING BY: MD
FIELD WORK BY: LG 04-11-2024

LYNCH & ASSOCIATES
ENGINEERING CONSULTANTS, LLC
5482 S. WESTRIDGE DRIVE
NEW BERLIN, WI 53151
440 MILWAUKEE AVENUE
BURLINGTON, WI 53105
(262) 402-5040

© Lynch & Associates - Projects\2024\24-0133 - Dave Knecht - W1758 & W1762 South Shore Drive - East Troy - 11-0 W1758W1762 South Shore Drive - East Troy.dwg - 11-0 W1758W1762 South Shore Drive - East Troy - 4-11-2024 7:43:21 AM by