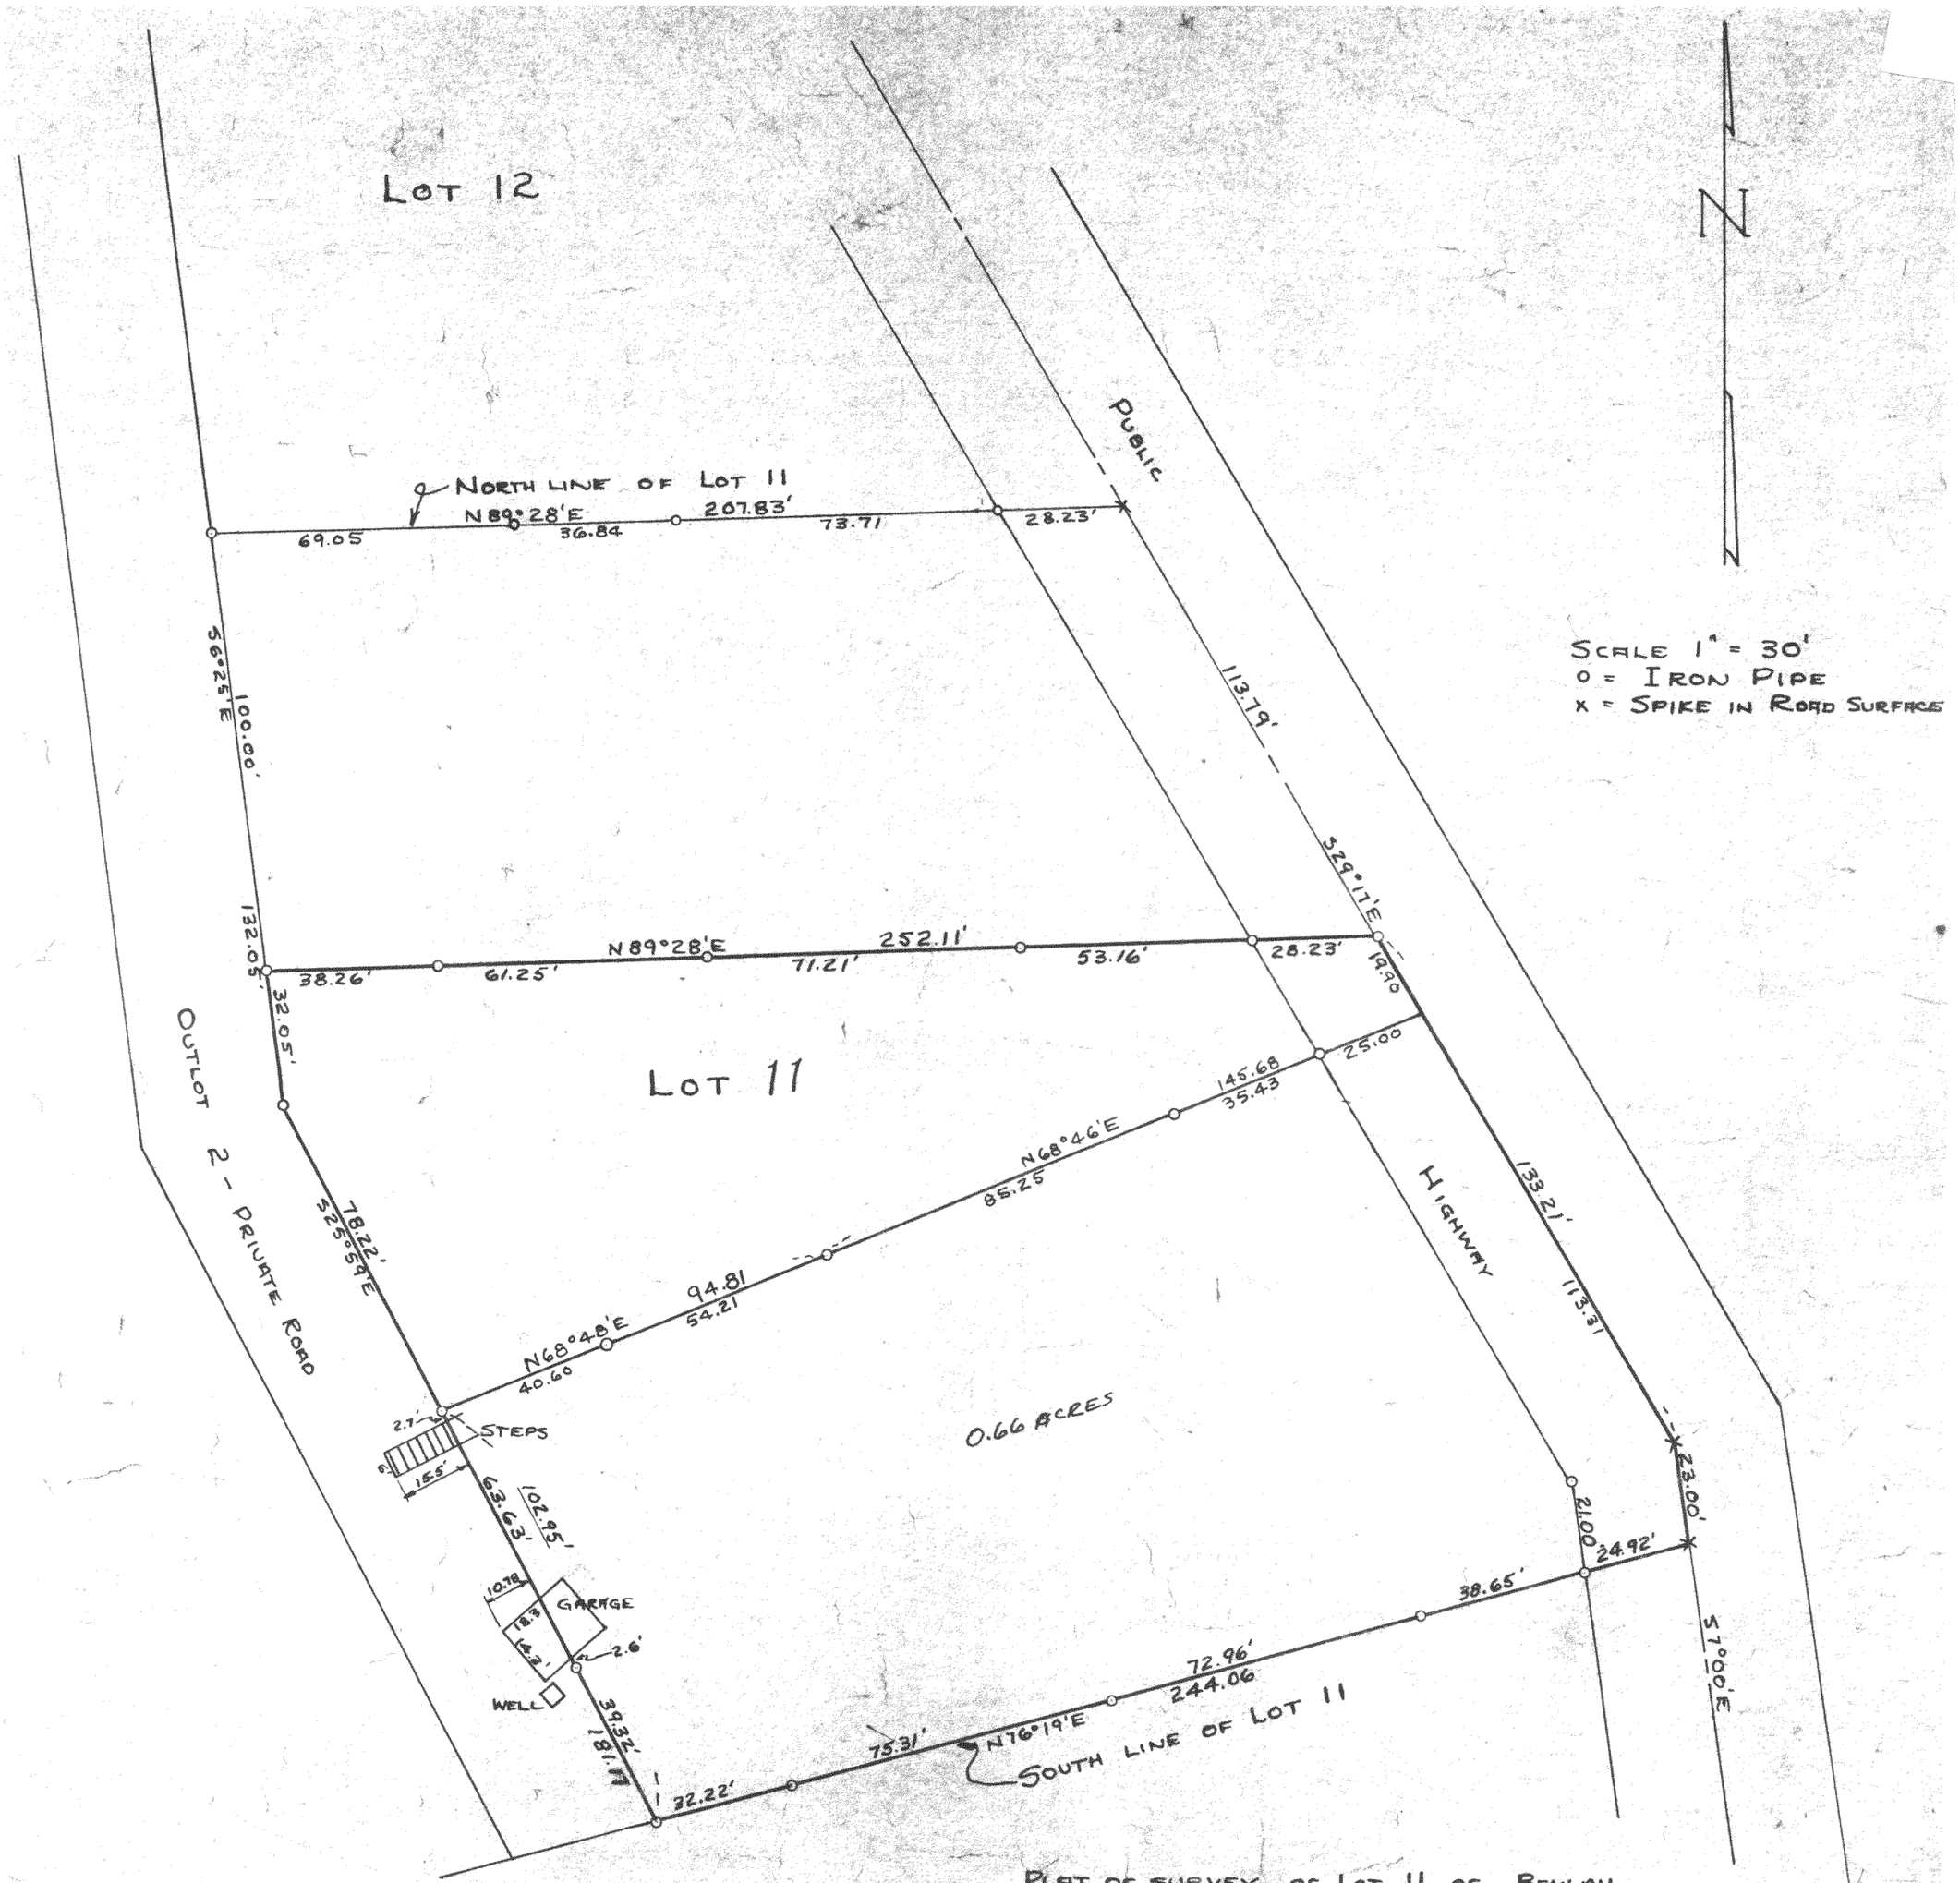

PLAT OF SURVEY OF LOT 11 OF BEULAH LAKE PARK LOCATED IN SECTION 4, T4NR18E, WALWORTH COUNTY, WISCONSIN

Lloyd R. Jensen
COUNTY SURVEYOR

JULY 1949
SEPT. 1950
APRIL 1951

Pd PBL-10

418-30 J