418-359

HOFFMANN, POLZIN & ASSOC., CONSULTANTS
Post Office Box 182
W246 S3145 Industrial Lane
Waukesha, Wisconsin 53186
414-542-0436


PLANNING
SURVEYING
ENGINEERING
ARCHITECTURE

PLAT OF SURVEY

FOR: Ralph Chapman

SCALE 1" = 40'

Lot 15 and the West One-Half of Lot 14, Freuck's Subdivsion in the Northwest One-Quarter of Section 18, Town 4 North, Range 18 East, Town of East Troy, Walworth County, Wisconsin.

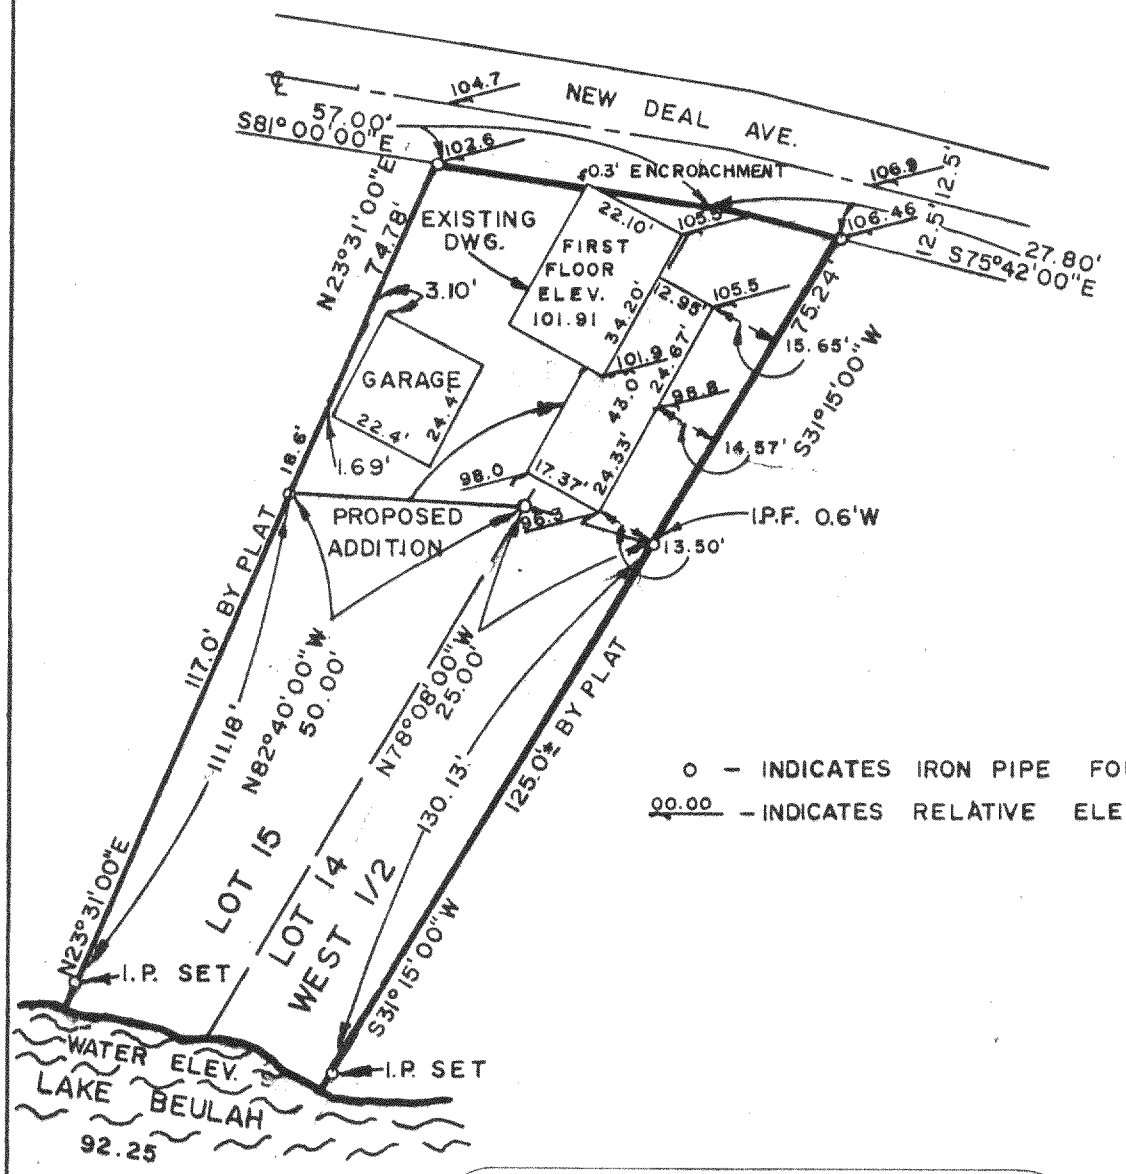

o — INDICATES IRON PIPE FOUND.
00.00 — INDICATES RELATIVE ELEVATION.

SURVEYING PLANNING ENGINEERING ARCHITECTURE

CERTIFICATION

"I HAVE SURVEYED THE ABOVE DESCRIBED PROPERTY, AND THE ABOVE MAP IS A TRUE REPRESENTATION THEREOF AND SHOWS THE SIZE AND LOCATION OF THE PROPERTY, ITS EXTERIOR BOUNDARIES, THE LOCATION AND DIMENSIONS OF ALL STRUCTURES THEREON, FENCES, APPARENT EASEMENTS AND ROADWAYS AND VISIBLE ENCROACHMENTS, IF ANY.

THIS SURVEY IS MADE FOR THE EXCLUSIVE USE OF THE PRESENT OWNERS OF THE PROPERTY, AND ALSO THOSE WHO PURCHASE, MORTGAGE, OR GUARANTEE THE TITLE THERETO, WITHIN ONE (1) YEAR FROM DATE HEREOF; AND AS TO THEM I HEREBY CERTIFY THAT SAID SURVEY AND THE ABOVE MAP WERE MADE IN ACCORDANCE WITH ACCEPTABLE PROFESSIONAL STANDARDS AND THAT THE INFORMATION CONTAINED THEREON IS, TO THE BEST OF MY KNOWLEDGE, INFORMATION AND BELIEF A TRUE AND ACCURATE REPRESENTATION THEREOF."

DATED AT WAUKESHA, THIS 12 DAY OF May, 19 77

Claude C. Johnson, Jr.

REGISTERED LAND SURVEYOR

WISCONSIN
CLAUDE C. JOHNSON, JR.
S-0765
NEW BERLIN
WIS.
LAND SURVEYOR

LAND SURVEYOR NO.

PFS-129

DRAFTED BY Don Mules PFS - 124

418-360

JOB NO 1673