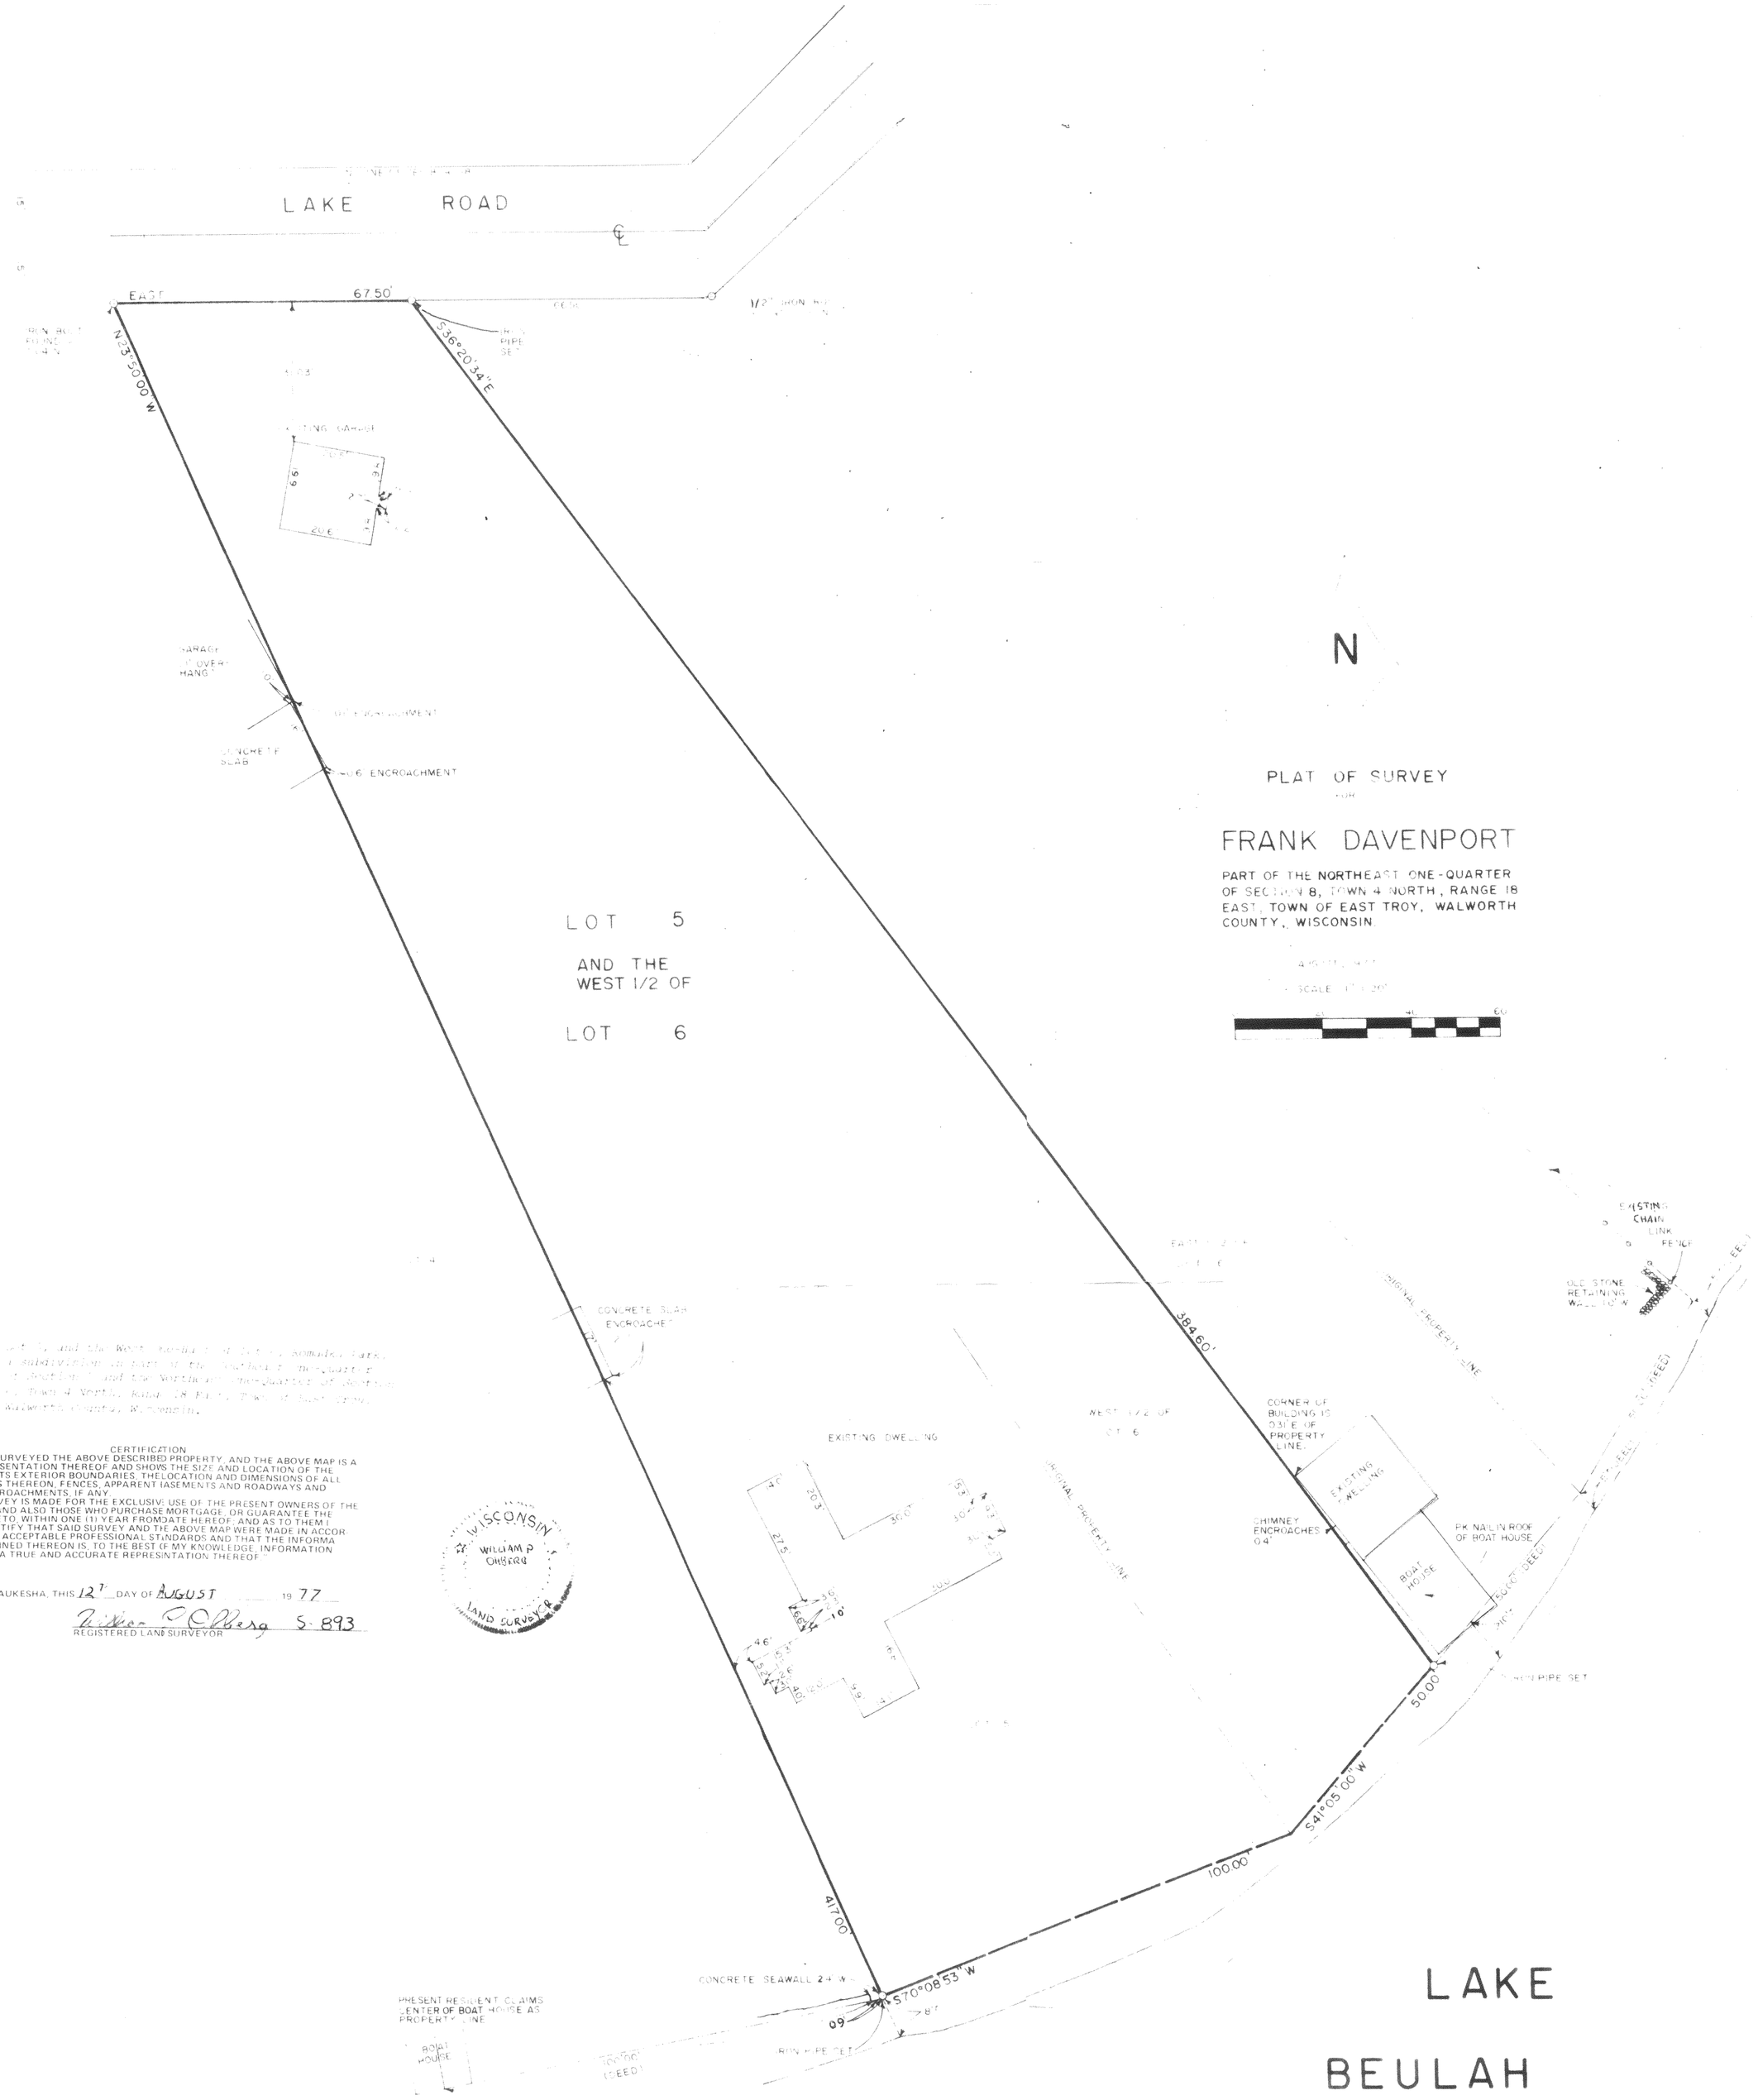


PLAT OF SURVEY

FOR

FRANK DAVENPORT

PART OF THE NORTHEAST ONE-QUARTER OF SECTION 8, TOWN 4 NORTH, RANGE 18 EAST, TOWN OF EAST TROY, WALWORTH COUNTY, WISCONSIN.

AUGUST, 1977



...and the West Half of Lot 6, according to Bate's Subdivision on part of the Northeast One-Quarter of Section 8 and the Northwest One-Quarter of Section 9, Town 4 North, Range 18 East, Town of East Troy, Walworth County, Wisconsin.

CERTIFICATION

"I HAVE SURVEYED THE ABOVE DESCRIBED PROPERTY, AND THE ABOVE MAP IS A TRUE REPRESENTATION THEREOF AND SHOWS THE SIZE AND LOCATION OF THE PROPERTY, ITS EXTERIOR BOUNDARIES, THE LOCATION AND DIMENSIONS OF ALL STRUCTURES THEREON, FENCES, APPARENT EASEMENTS AND ROADWAYS AND VISIBLE ENCROACHMENTS, IF ANY.

THIS SURVEY IS MADE FOR THE EXCLUSIVE USE OF THE PRESENT OWNERS OF THE PROPERTY, AND ALSO THOSE WHO PURCHASE MORTGAGE OR GUARANTEE THE TITLE THERETO, WITHIN ONE (1) YEAR FROM DATE HEREOF, AND AS TO THEM I HEREBY CERTIFY THAT SAID SURVEY AND THE ABOVE MAP WERE MADE IN ACCORDANCE WITH ACCEPTABLE PROFESSIONAL STANDARDS AND THAT THE INFORMATION CONTAINED THEREON IS, TO THE BEST OF MY KNOWLEDGE, INFORMATION AND BELIEF A TRUE AND ACCURATE REPRESENTATION THEREOF."

DATED AT WAUKESHA, THIS 12TH DAY OF AUGUST, 1977

William P Olberg S-893

REGISTERED LAND SURVEYOR

WISCONSIN WILLIAM P OLBERG LAND SURVEYOR

THIS INSTRUMENT WAS DRAFTED BY FRAN HROVATIN

PROJECT NUMBER 1742

EXP-6

4118-364