
HAROLD H. KOLB

REGISTERED PROFESSIONAL LAND SURVEYOR
LAKE GENEVA, WISCONSIN

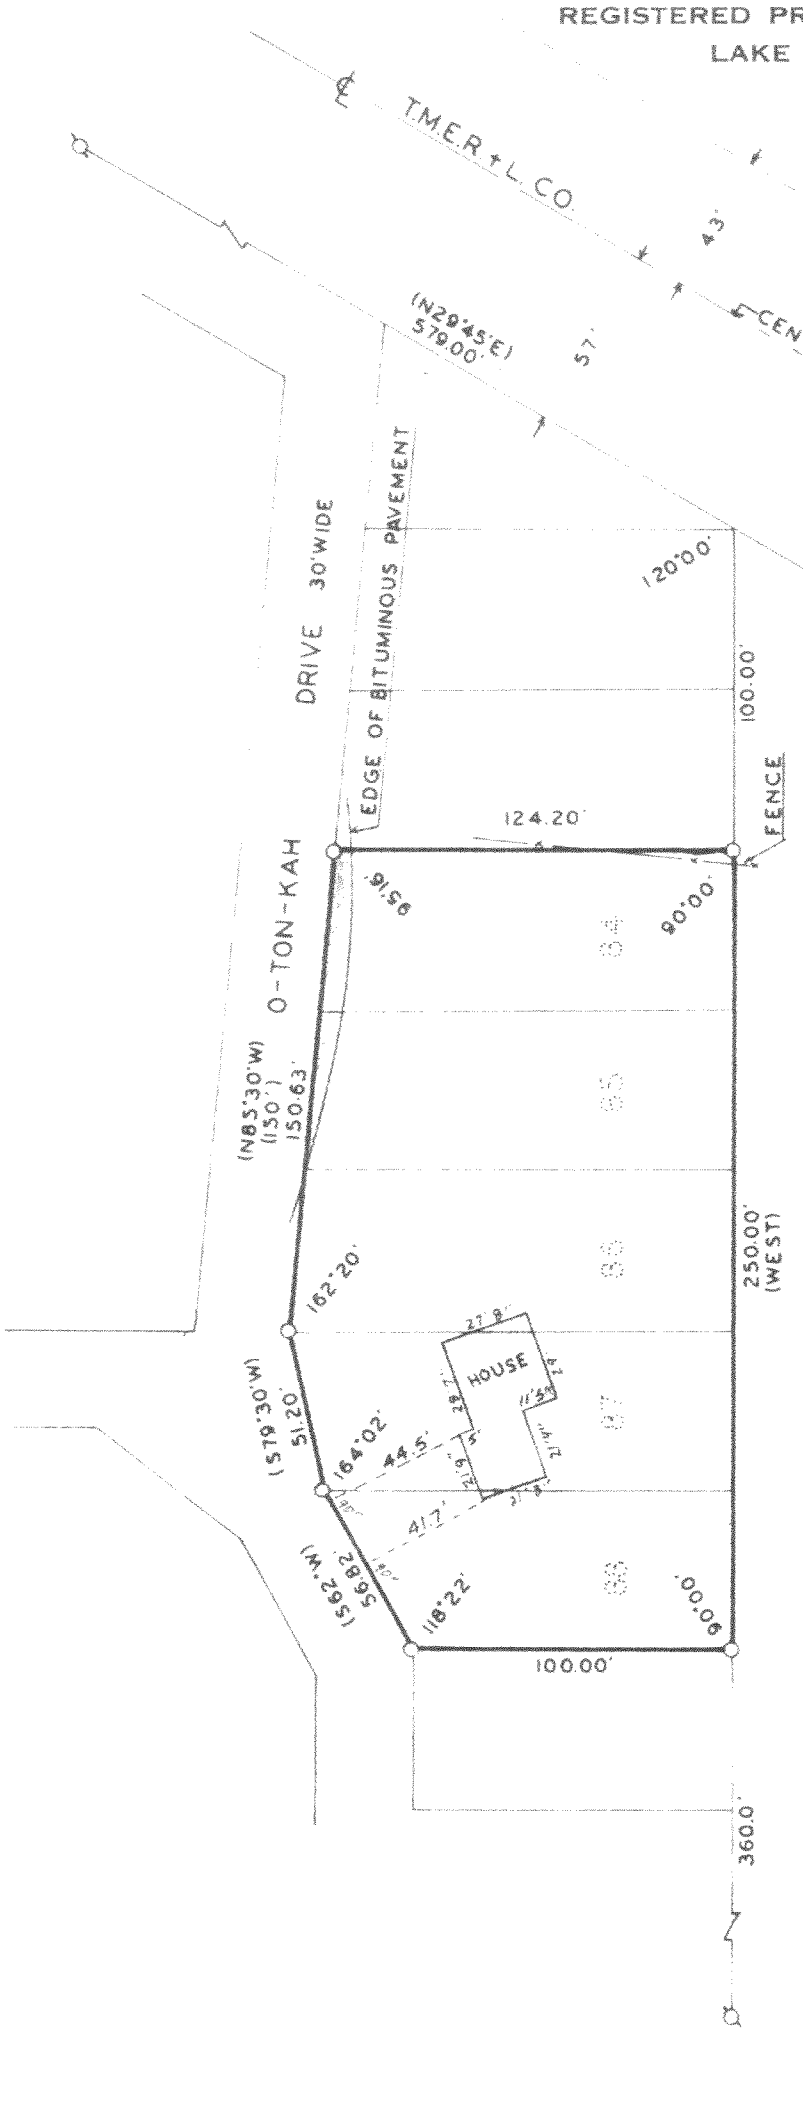

PLAT OF SURVEY OF

LOTS 84, 85, 86, 87 AND 88, O-TON-KAH SUBDIVISION, LOCATED IN THE NW¼ OF SECTION 10, T4N, R18E, WALWORTH COUNTY, WISCONSIN.

OWNER: JAMES FILBER

SCALE: 1"=60'

LEGEND

- ϕ — IRON PIPE FOUND
- O — IRON PIPE PLACED
- ● — CONCRETE MONUMENT
- x — SPIKE
- ( ) - AS PLATTED

I. HAROLD H. KOLB, DO HEREBY CERTIFY THAT I HAVE SURVEYED THE PROPERTY HEREON DESCRIBED ACCORDING TO THE OFFICIAL RECORDS AND THAT THE PLAT HEREON IS A CORRECT REPRESENTATION OF THE LOT LINES.

Harold H. Kolb

HAROLD H. KOLB
WISCONSIN REGISTERED LAND SURVEYOR, S-187
DATE Dec. 20, 1977

REVISED DATE: MARCH 15, 1978

P&T-33

415-370

BRUNING 40-105 500-6-71