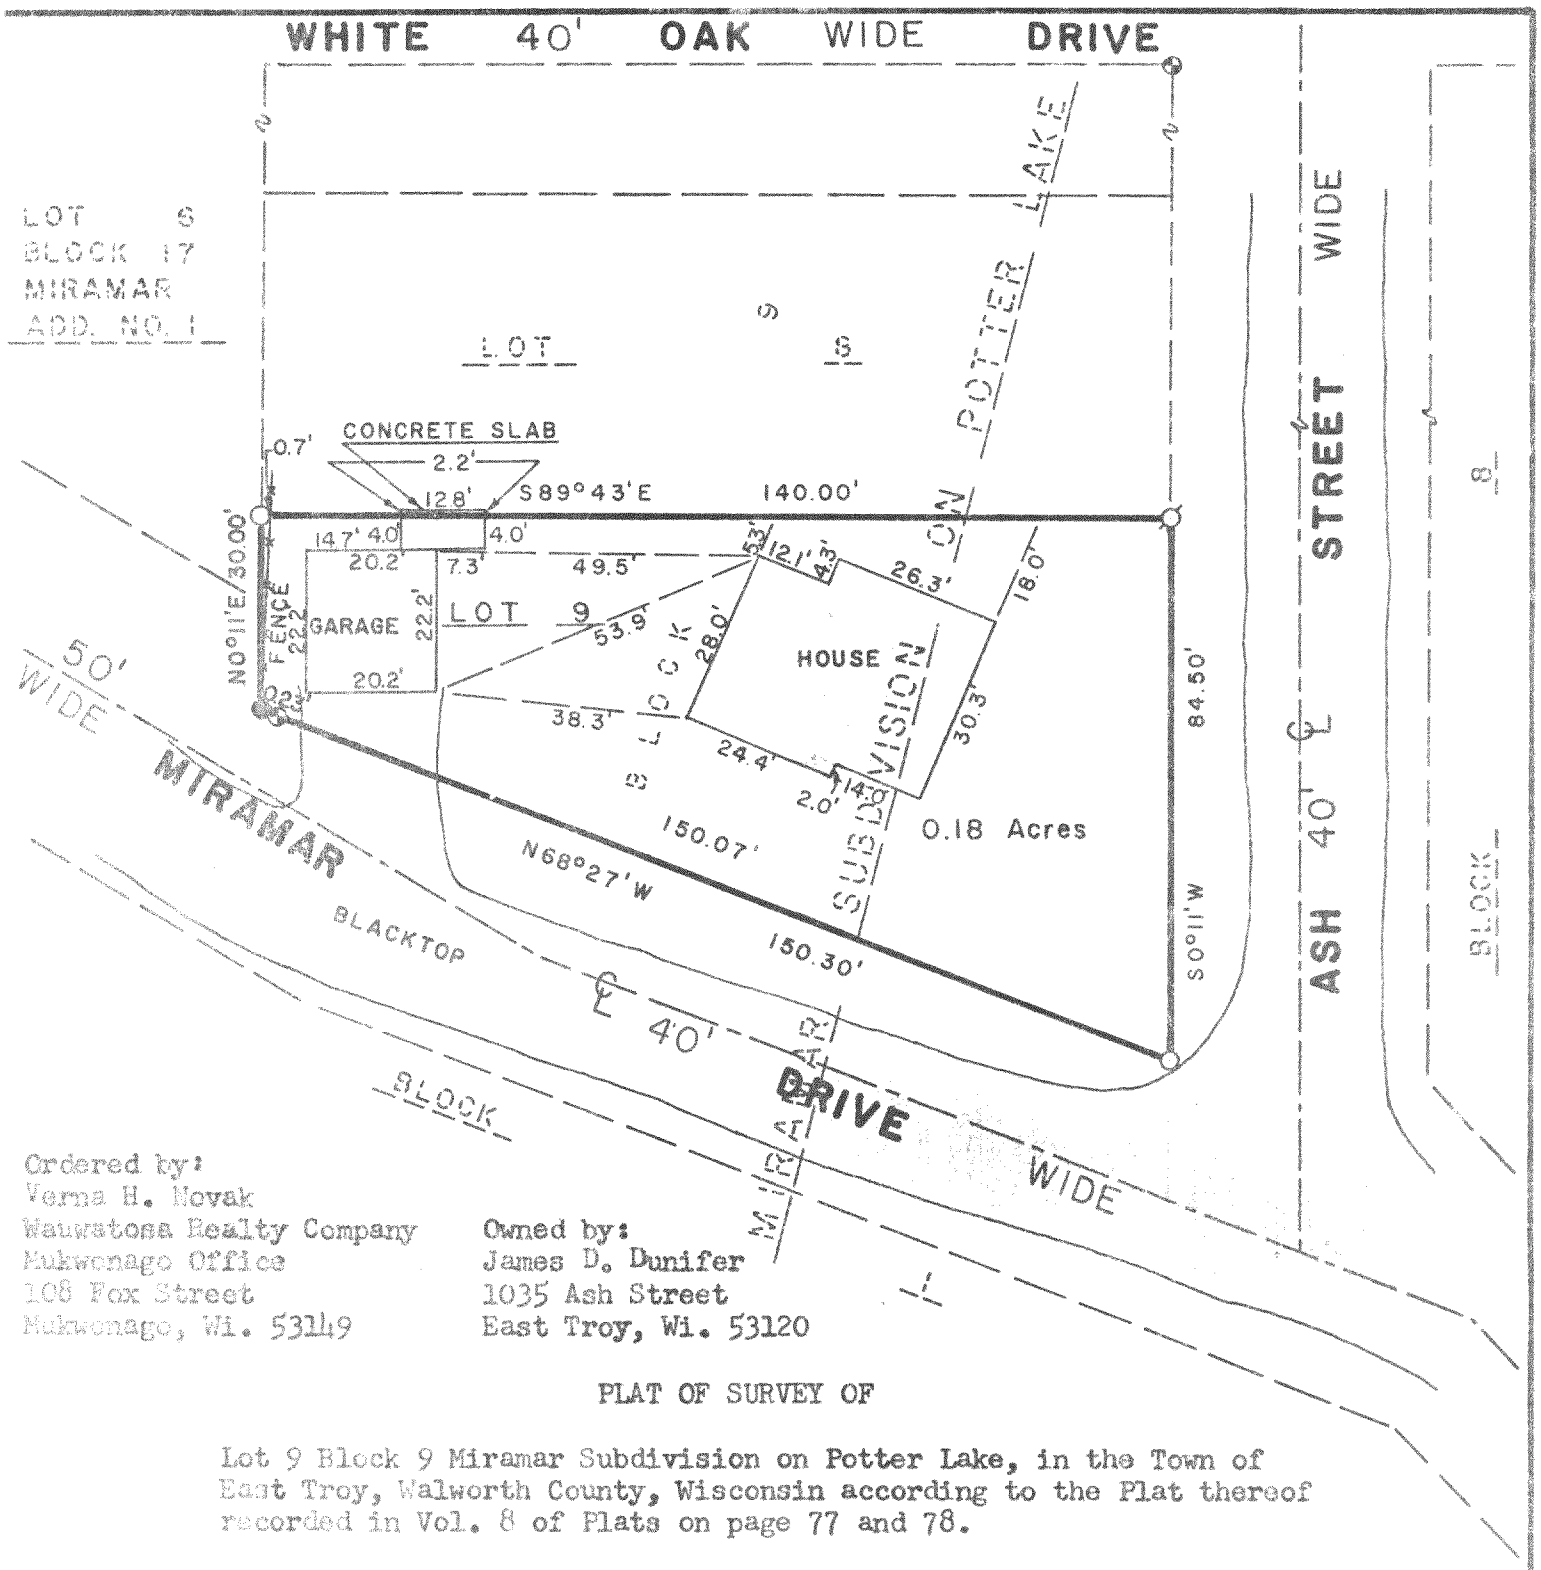

Ordered by:
Verna H. Novak
Wauwatosa Realty Company
Mukwonago Office
108 Fox Street
Mukwonago, Wi. 53149

Owned by:
James D. Dunifer
1035 Ash Street
East Troy, Wi. 53120

PLAT OF SURVEY OF

Lot 9 Block 9 Miramar Subdivision on Potter Lake, in the Town of East Troy, Walworth County, Wisconsin according to the Plat thereof recorded in Vol. 8 of Plats on page 77 and 78.

Note: Bearings based on previous survey records

SURVEYOR'S CERTIFICATE

I have surveyed the above described property and the above map is a true representation thereof and shows the size and location of the property, its exterior boundaries, the location and dimensions of all visible structures thereon, fences, apparent easements and roadways and visible encroachments. This survey is made for the exclusive use of the present owners of the property, and also those who purchase, mortgage, or guarantee the title thereto within one (1) year from date hereof and as to them I warrant the accuracy of said survey and map.

Date January 13, 1980

Jim E. Yankee
Jim E. Yankee, RLS 1540

LEGEND

- Power Pole
- Found Iron Pipe
- Found Iron Stake
- Iron Stake Placed

N

Scale 1" - 30'

WISCONSIN
JIM E. YANKEE
LAND SURVEYOR

PMR-1070

418-397