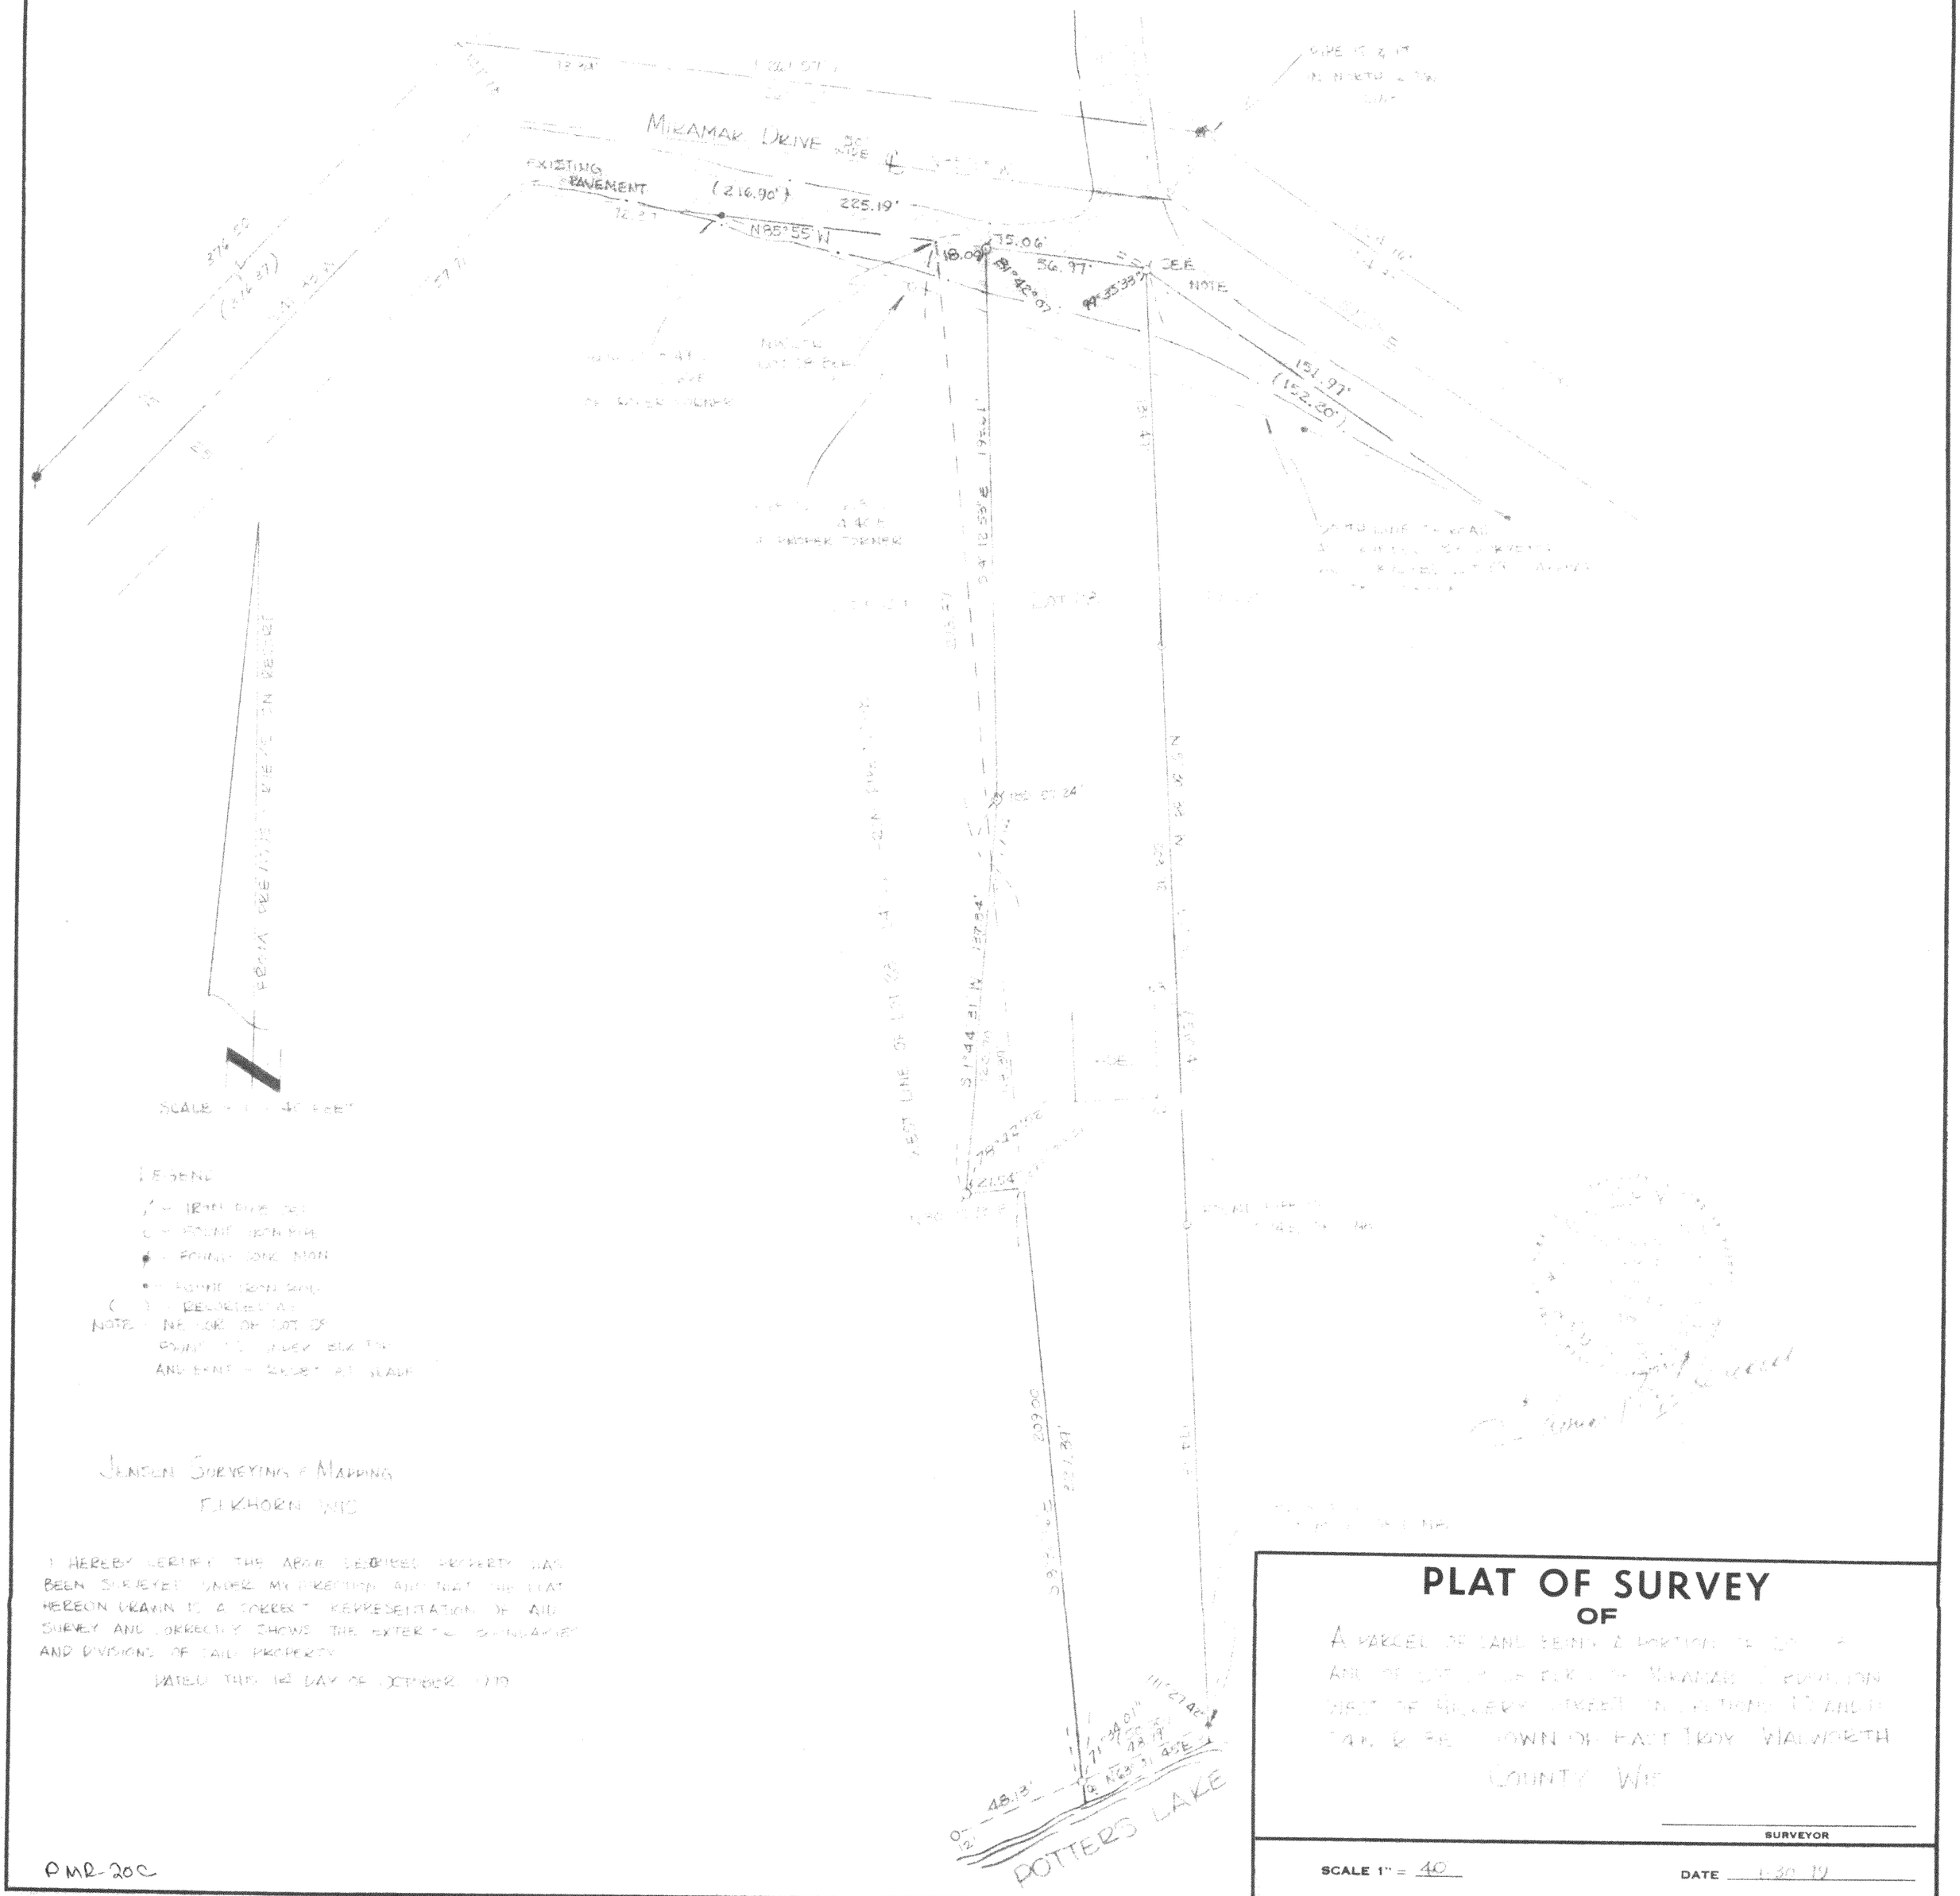

JENSEN SURVEYING & MAPPING
ELKHORN WIS

I HEREBY CERTIFY THAT THE ABOVE DESCRIBED PROPERTY HAS BEEN SURVEYED UNDER MY DIRECTION AND THAT THE PLAT HEREON DRAWN IS A CORRECT REPRESENTATION OF AND SURVEY AND CORRECTLY SHOWS THE EXTERIOR BOUNDARIES AND DIVISIONS OF SAID PROPERTY

DATED THIS 1st DAY OF OCTOBER, 1979

PLAT OF SURVEY
OF

A PARCEL OF LAND BEING A PORTION OF LOT 12 AND OUTLOT 1 OF ELK [illegible] MIKAMAK [illegible] WEST OF MULBERRY STREET IN SECTIONS 13 AND 14, T4N, R18E, TOWN OF EAST TROY, WALWORTH COUNTY, WIS

SURVEYOR

SCALE 1" = 40

DATE 1-30-79

PMR-20C

NO. 17SH 300 9-68

1979-061