
KOLB LAND CONSULTING, INC.

LAND SURVEYING · SUBDIVIDING · LAND PLANNING

LAKE GENEVA, WISCONSIN 53147

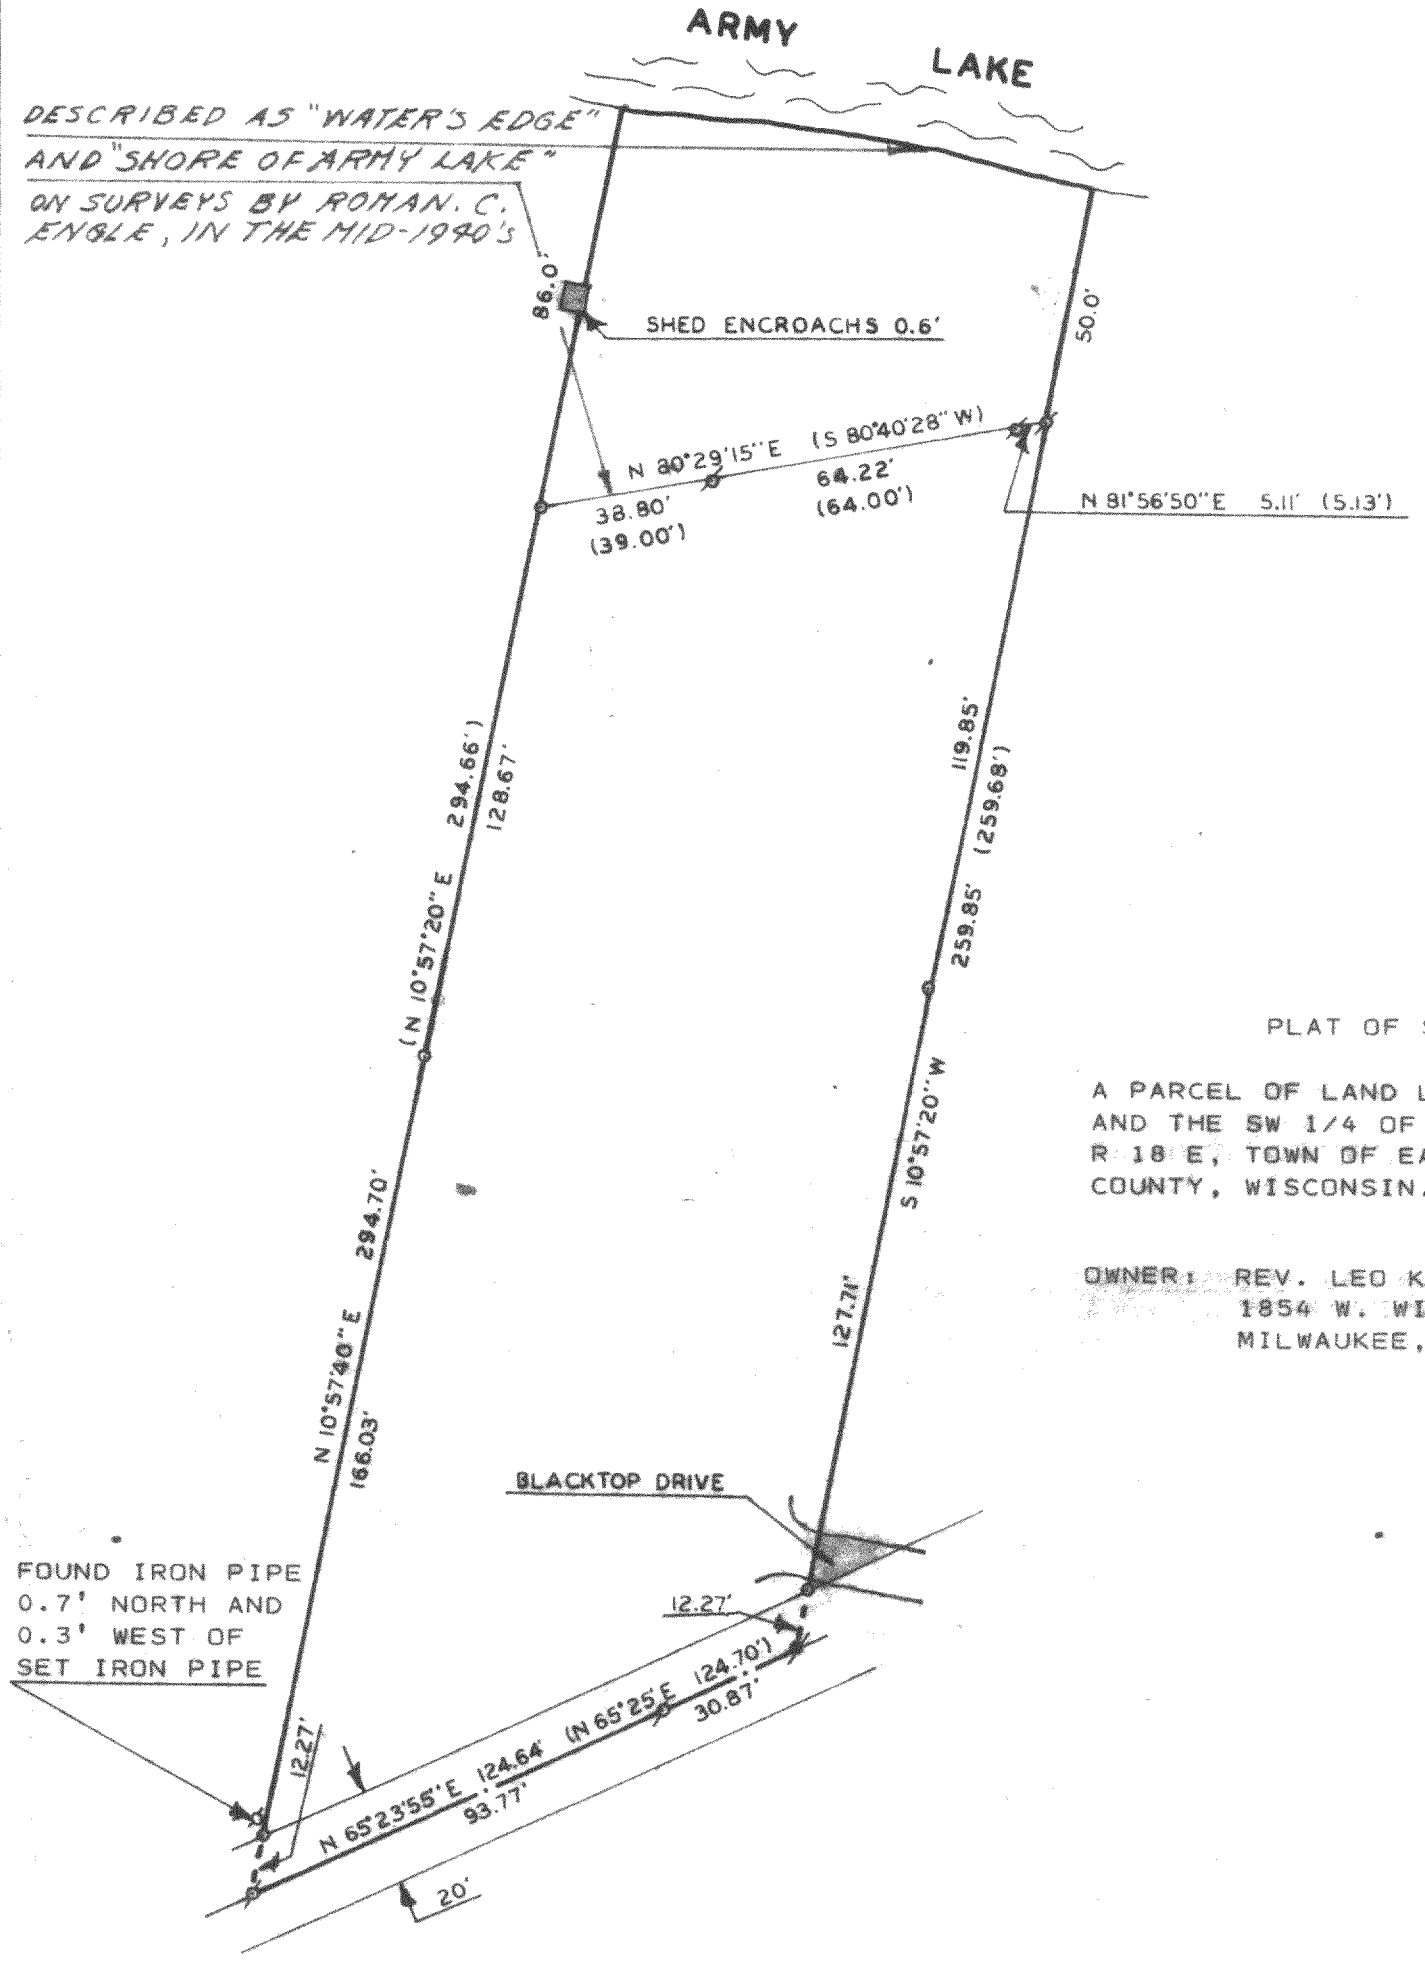

PLAT OF SURVEY OF

A PARCEL OF LAND LOCATED IN THE NW 1/4 AND THE SW 1/4 OF SECTION 16, T 4 N, R 18 E, TOWN OF EAST TROY, WALWORTH COUNTY, WISCONSIN.

OWNER: REV. LEO KOWALSKI
1854 W. WINDLAKE AVE.
MILWAUKEE, WI 53215

SCALE - 1"=40'

LEGEND

- IRON PIPE FOUND
- IRON PIPE SET
- SPIKE FOUND
- ( ) RECORDED AS

WISCONSIN HAROLD H. KOLB S-187 LAKE GENEVA, WIS. LAND SURVEYOR

I, HAROLD H. KOLB, DO HEREBY CERTIFY THAT I HAVE SURVEYED THE PROPERTY HEREON DESCRIBED ACCORDING TO THE OFFICIAL RECORDS, AND THAT THE PLAT HEREON IS A CORRECT REPRESENTATION OF THE LOT LINES TO THE BEST OF MY KNOWLEDGE AND BELIEF.

Harold H. Kolb

HAROLD H. KOLB

WISCONSIN REGISTERED LAND SURVEYOR, S-187

DATE NOVEMBER 8, 1984

Rec'd Oak Ck. 15-4-18

418-465-K

4-18-68