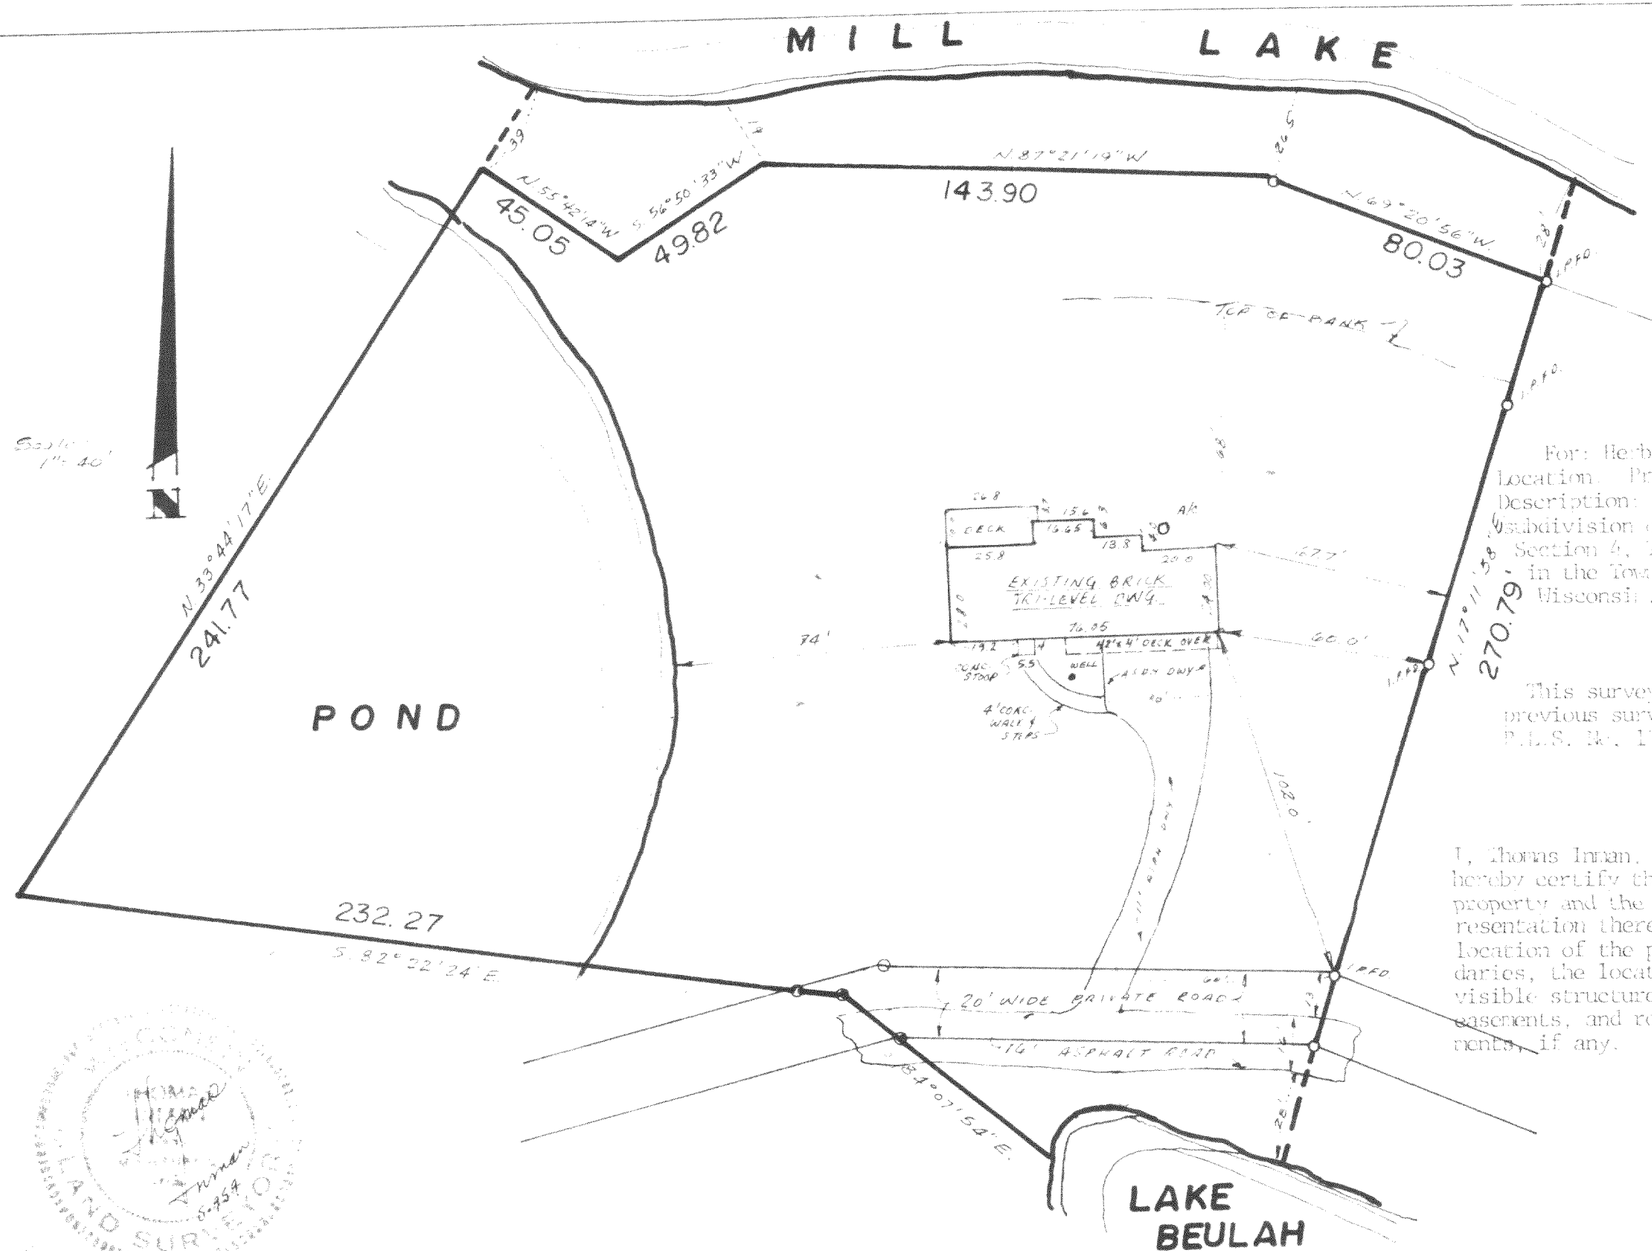


PLAT OF SURVEY

For: Herb Hackbarth
Location: Private Road
Description: LOT 14 ISLAND CLUB Subdivision of a part of the S.W. 1/4 of Section 4, Town 4 North, Range 18 East, in the Town of East Troy, Walworth Co., Wisconsin.

This survey is a re-enactment of a previous survey prepared by W. Shoarman, R.L.S. No. 1378, done in Sept., 1977.

I, Thomas Inman, Registered Land Surveyor, do hereby certify that the above described property and the above map is a true representation thereof, and shows the size and location of the property, its exterior boundaries, the location and dimensions of all visible structures thereon, fences, apparent easements, and roadways, and visible encroachments, if any.

JOB NO. 11374
AUG 8TH 1984

P1-14

418-468