
PLAT OF SURVEY

FOR: WM. & JANET KAISKA
LOCATION: 1116 HUMPHREY LA.
LEGAL DESCRIPTION: LOT 6 IN THE PLAT OF BEULAH MANOR [illegible] OF PART OF THE WEST 1/2 OF SECTION [illegible] TOWN OF EAST TROY, WALWORTH CO., WIS.

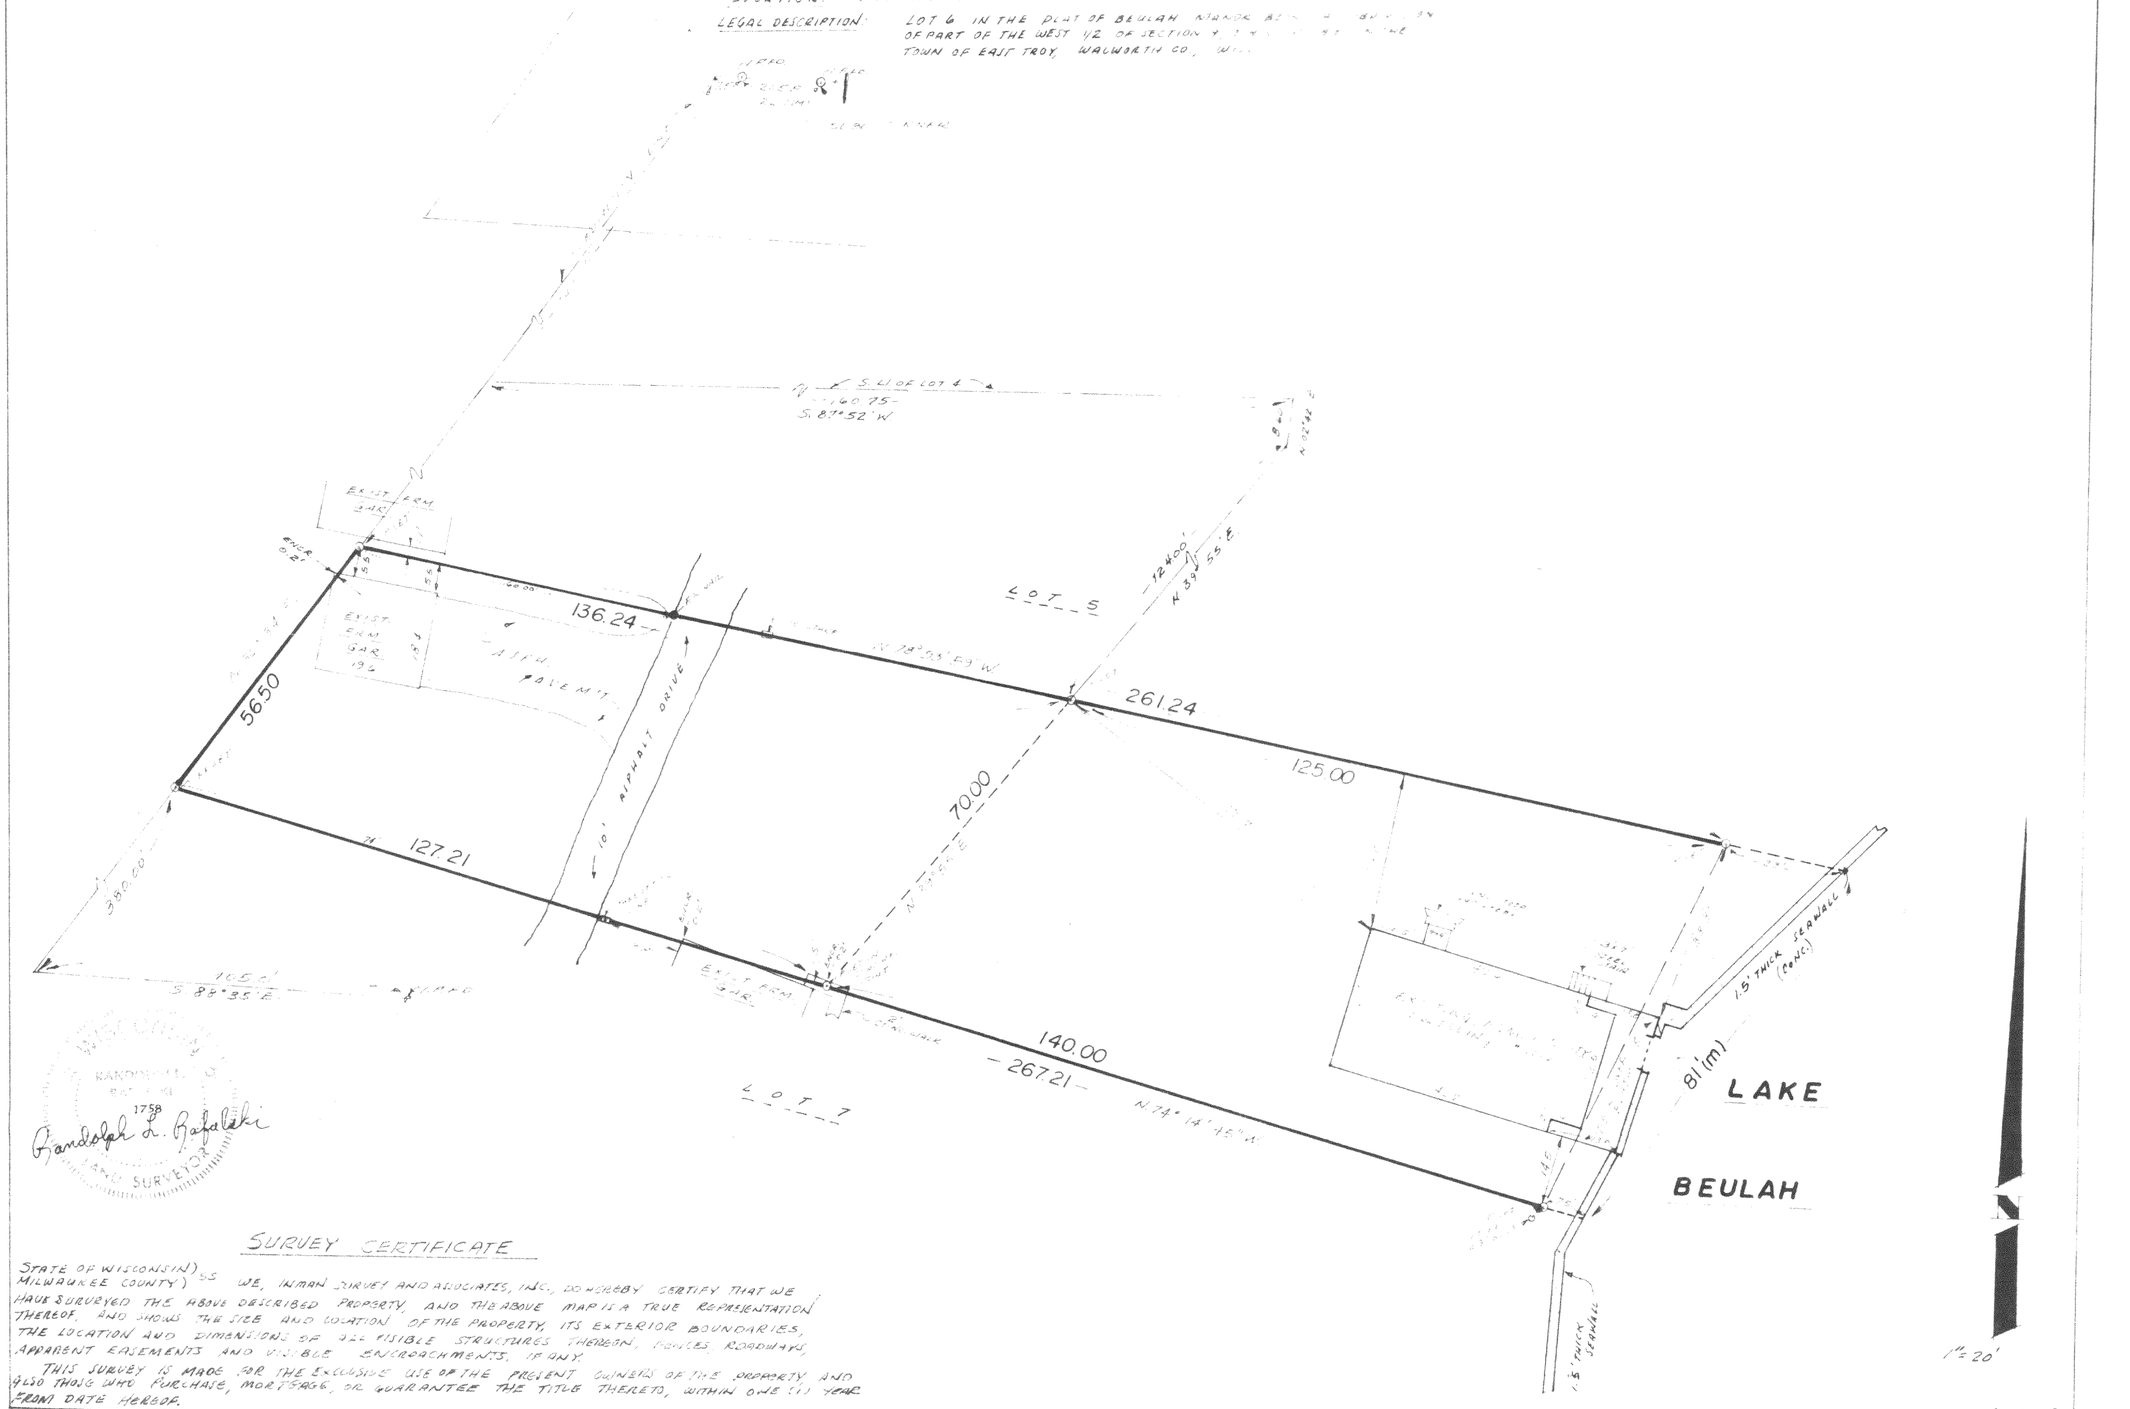

SURVEY CERTIFICATE

STATE OF WISCONSIN) SS
MILWAUKEE COUNTY)

WE, INMAN SURVEY AND ASSOCIATES, INC., DO HEREBY CERTIFY THAT WE HAVE SURVEYED THE ABOVE DESCRIBED PROPERTY, AND THE ABOVE MAP IS A TRUE REPRESENTATION THEREOF, AND SHOWS THE SIZE AND LOCATION OF THE PROPERTY, ITS EXTERIOR BOUNDARIES, THE LOCATION AND DIMENSIONS OF ALL VISIBLE STRUCTURES THEREON, VISIBLE ROADWAYS, APPARENT EASEMENTS AND VISIBLE ENCROACHMENTS, IF ANY.

THIS SURVEY IS MADE FOR THE EXCLUSIVE USE OF THE PRESENT OWNERS OF THE PROPERTY, AND ALSO THOSE WHO PURCHASE, MORTGAGE, OR GUARANTEE THE TITLE THERETO, WITHIN ONE (1) YEAR FROM DATE HEREOF.

INMAN SURVEY AND ASSOCIATES, INC. KARDONG LA BAHN 1758 Randolph L. Rafalski LAND SURVEYOR

PBM-5.6

DATED 8-23-84
JOB NO. 11411