
AUTHORIZATION CERTIFICATE

I hereby certify that I have been authorized, under the direction of the Bureau of Aeronautics, Wisconsin Department of Transportation through an agency agreement with the Village of East Troy to survey, map and describe the property as shown on this plat.

BEING A PART OF THE SE 1/4 OF SECTION 16, T.4N., R.18E., IN THE TOWN OF EAST TROY, WALWORTH COUNTY, WISCONSIN

RECEIVED
AUG 29 1985

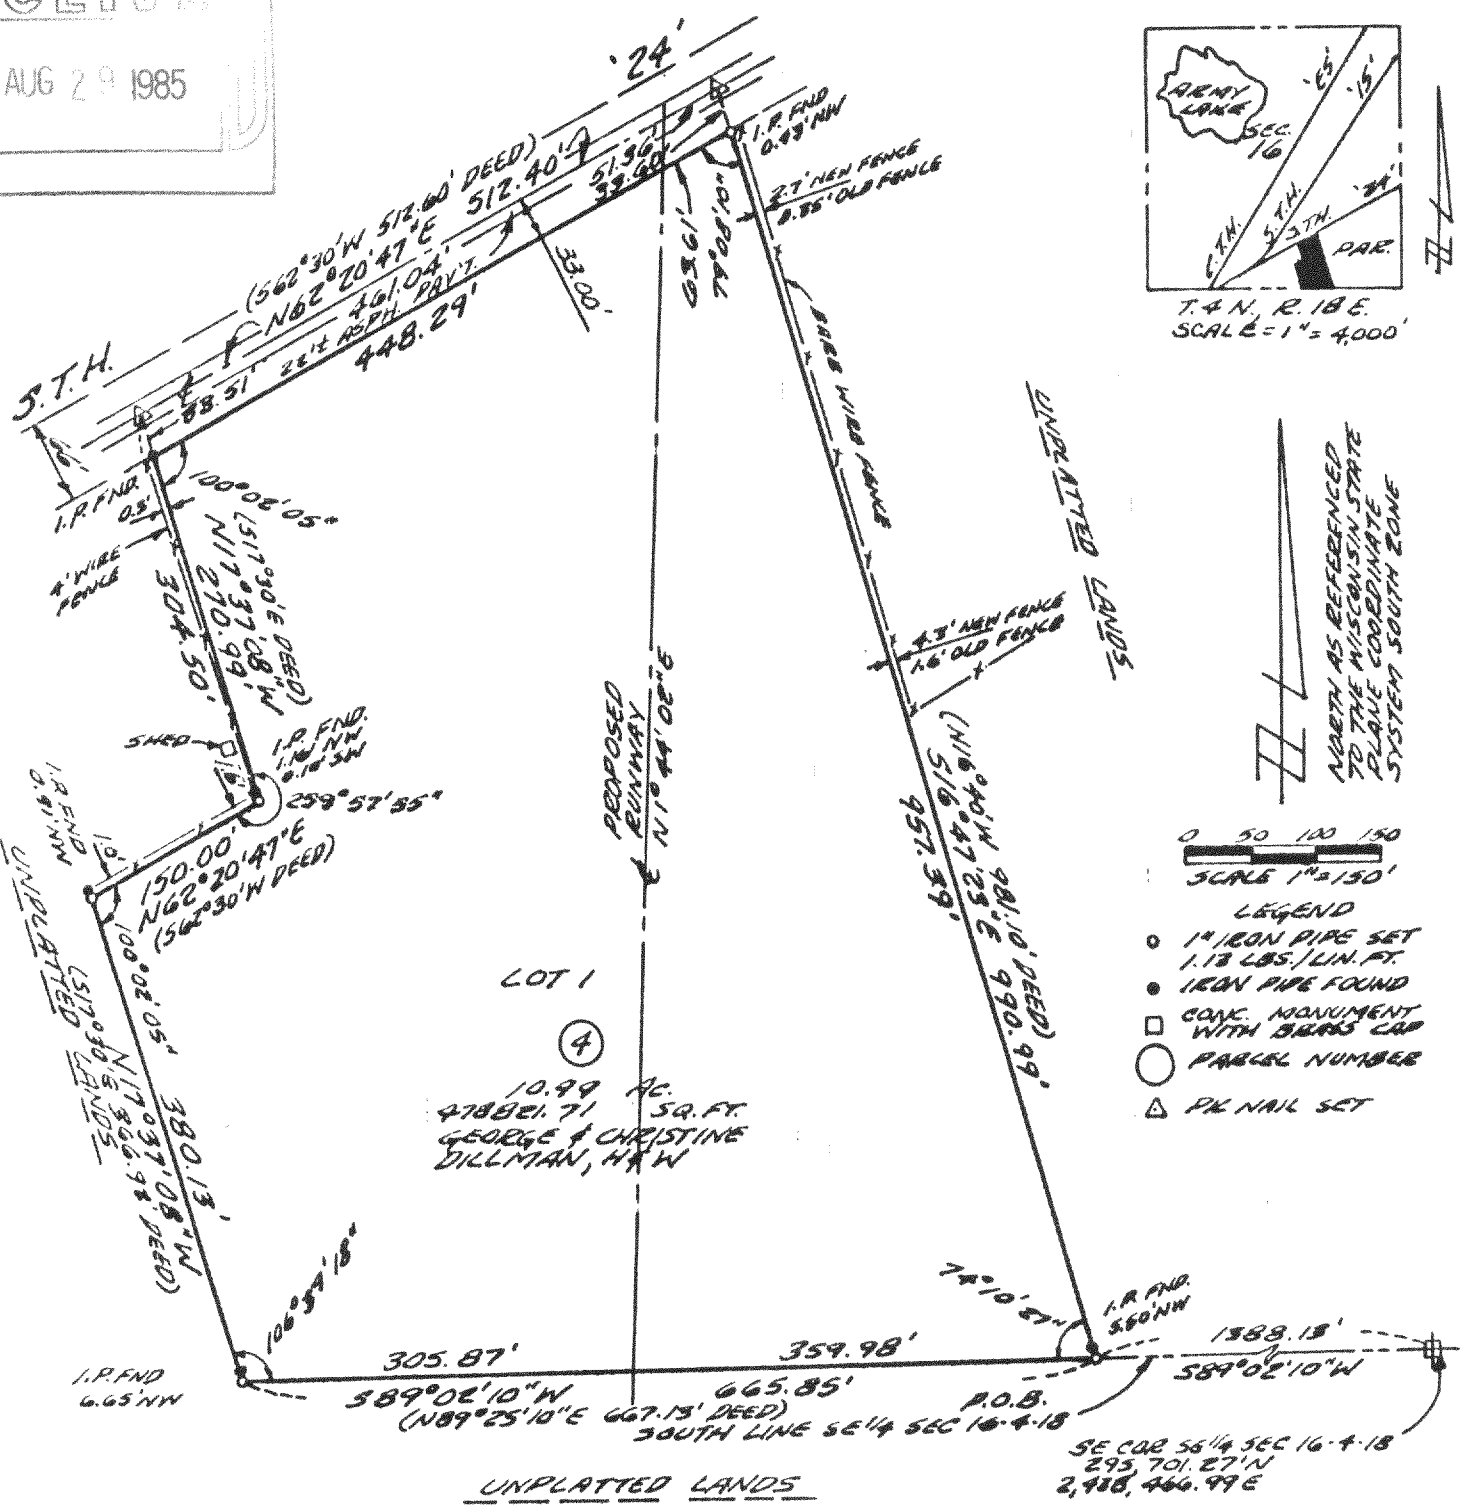

RECORDED UTILITY EASEMENTS

VOL.	PAGE	DOC. NO.
492	267	470726

WISCONSIN
RODALE F. FORMELLA
S-0916
LAKE GENEVA, WISC.
LAND SURVEYOR

4/29/85

ZIMMERMAN ENGINEERING CORP.
5200 West Loomis Road Greendale, Wisconsin 53129

ET-16-7E - Now annexed to Village

418-472-Z