
PLAT OF SURVEY OF LOT 11 - BLOCK 1, MIRAMAR SUBDIVISION

LOCATED IN SECTIONS 10 AND 11, T4N, R18E, WALWORTH COUNTY, WISCONSIN.

JENSEN SURVEYING & MAPPING, S.C.
45. SOUTH WIS. ST. - P.O. BOX 322
ELKHORN, WISCONSIN 53121
(414) 723-3434

OWNERS: DEAN & JANENE VOPAL
1205 MIRAMAR DR.
MUKWONAGO, WIS 53149

RECEIVED
NOV 14 1985

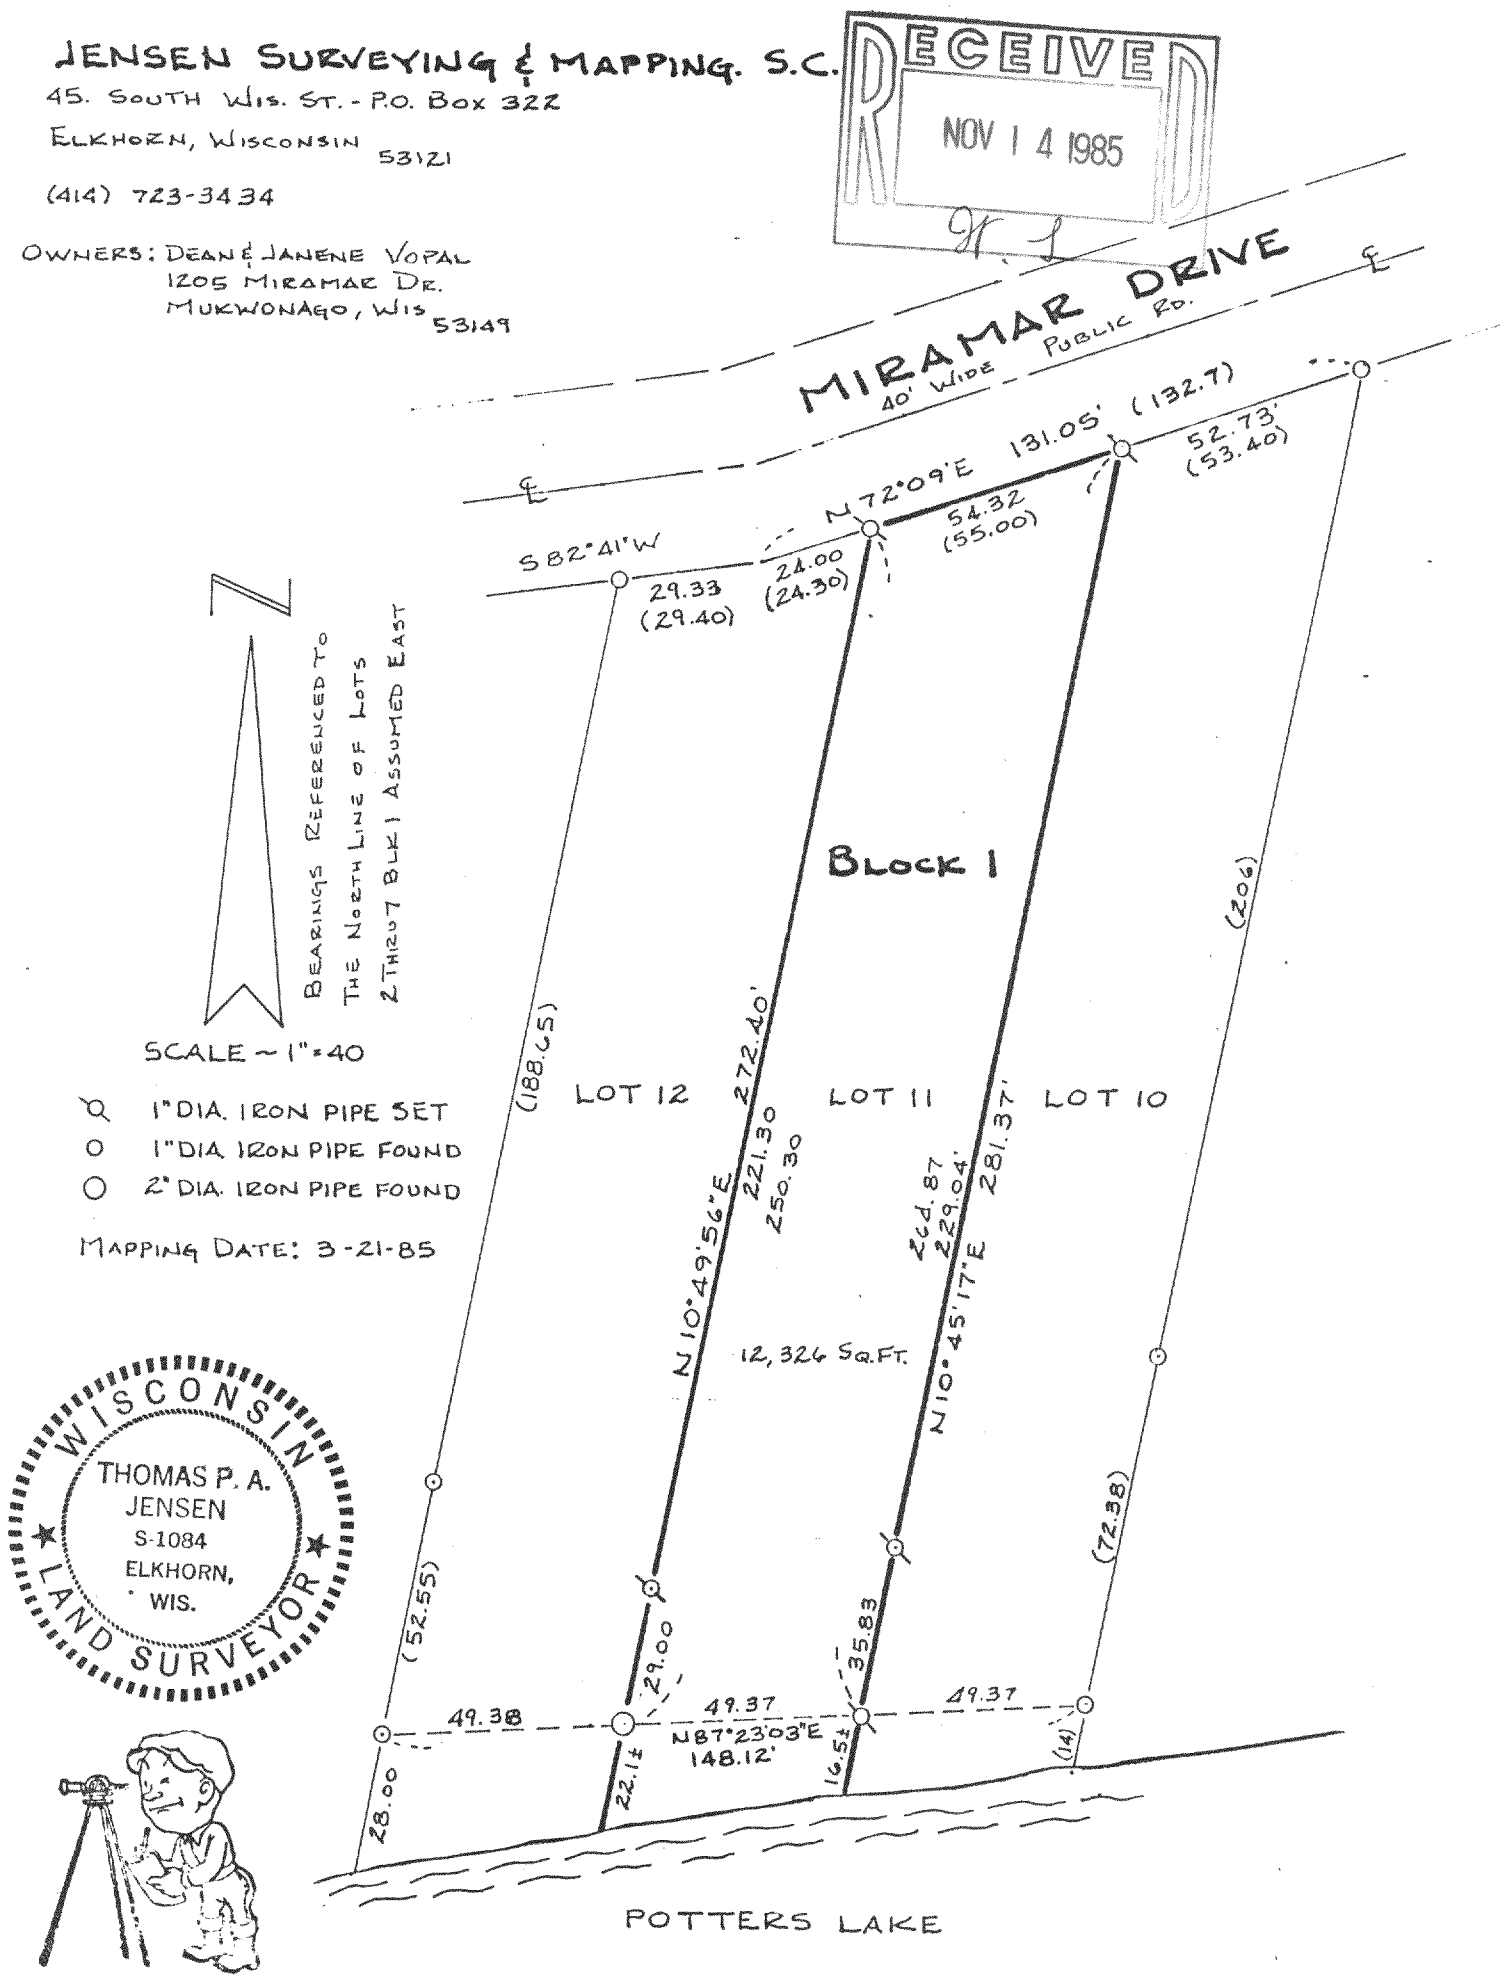

WISCONSIN
THOMAS P. A. JENSEN
S-1084
ELKHORN, WIS.
LAND SURVEYOR

I, THOMAS P.A. JENSEN, WISCONSIN REGISTERED LAND SURVEYOR DO HEREBY CERTIFY THAT THIS SURVEY WAS PERFORMED BY ME OR UNDER MY DIRECTION, IN FULL COMPLIANCE WITH THE OWNER'S/AGENT'S INSTRUCTIONS AND CHAPTER A-E 5 OF THE WISCONSIN ADMINISTRATIVE CODE "MINIMUM STANDARDS FOR PROPERTY SURVEYS"; AND THAT THIS MAP IS AN ACCURATE REPRESENTATION THEREOF TO THE BEST OF MY KNOWLEDGE AND BELIEF.

Thomas P.A. Jensen

THOMAS P.A. JENSEN RLS #1084

418-493

PMR-10

1985.016