
Plat of Survey

RECEIVED
JAN 16 19

FOR: WISCONSIN MORTGAGE - LLOYD WARNER
PROPERTY ADDRESS: 1156 Miramar Road; East Troy, Wisconsin

DESCRIPTION: Lot 18, MARAMAR ADDITION NO. 2, Being a Subdivision of a part of the Northeast 1/4 of Section 10 and the Northwest 1/4 of Section 11, Township 4 North, Range 18 East, in the Town of East Troy Walworth County, Wisconsin.

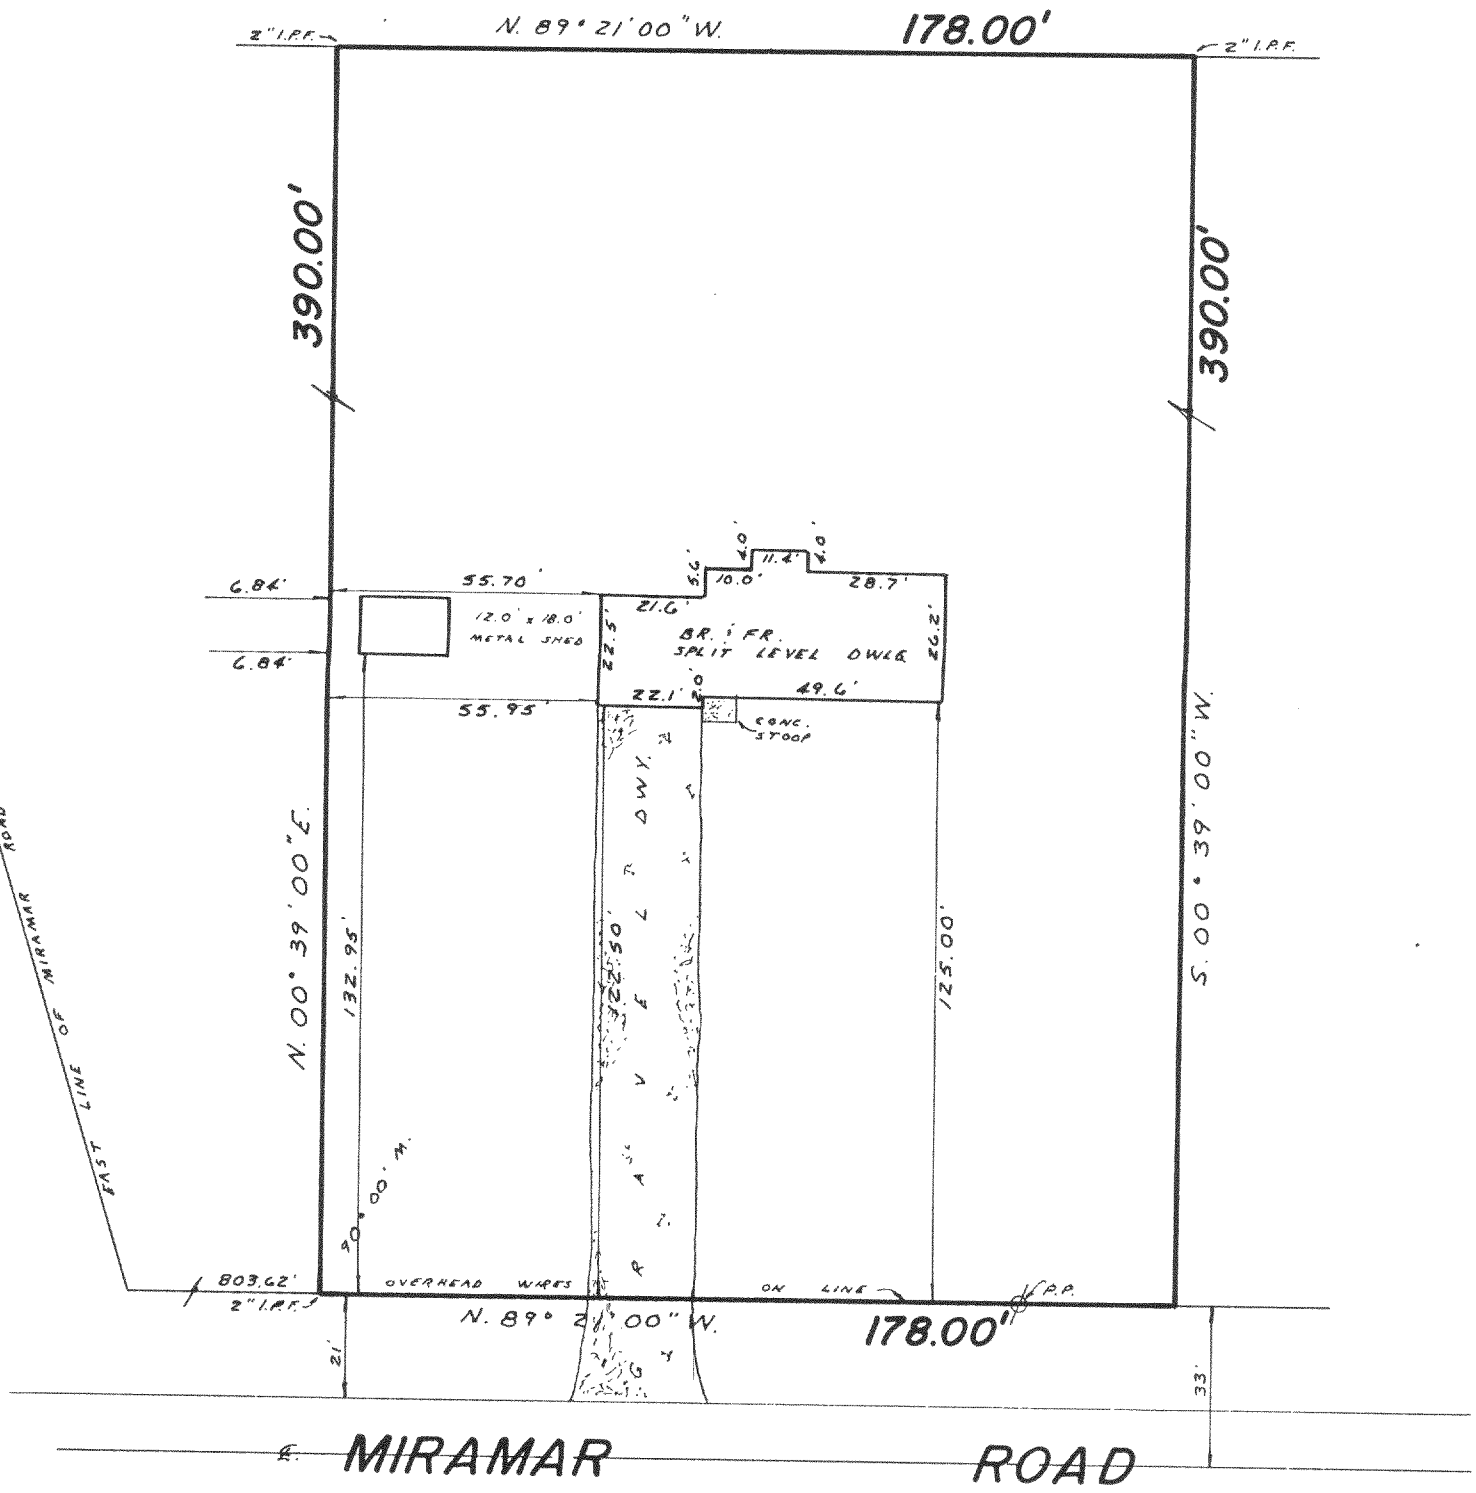

CERTIFICATE

STATE OF WISCONSIN) SS
WAUKESHA COUNTY)

I CERTIFY THAT I HAVE SURVEYED THE ABOVE DESCRIBED PROPERTY, AND THE ABOVE MAP IS A TRUE REPRESENTATION THEREOF AND SHOWS THE SIZE AND LOCATION OF THE PROPERTY, ITS EXTERIOR BOUNDARIES, THE LOCATION AND DIMENSIONS OF ALL STRUCTURES THEREON, FENCES, APPARENT EASEMENTS AND ROADWAYS AND VISIBLE ENCROACHMENTS, IF ANY.

THIS SURVEY IS MADE FOR THE EXCLUSIVE USE OF THE PRESENT OWNERS OF THE PROPERTY, AND ALSO THOSE WHO PURCHASE, MORTGAGE, OR GUARANTEE THE TITLE THERETO, WITHIN ONE (1) YEAR FROM DATE HEREOF.

THIS SURVEY IS COPYRIGHTED AND THE REPRODUCTION THEREOF, IS PROHIBITED.

MONUMENTATION OF MISSING BOUNDARY CORNERS HAS (~~NOT~~) BEEN WAIVED BY THE ABOVE CLIENT AS PER CHAPTER A-E-6.01(b) OF THE WISCONSIN ADMINISTRATIVE CODE.

Donald C. Chaput 12/8/93
REGISTERED LAND SURVEYOR — DATE

WISCONSIN
DONALD C. CHAPUT
S-1316
WAUKESHA, W.S.
LAND SURVEYOR

TERRA TECHnology, Inc.
Land Surveyors - Land Planners
909 Blackstone Avenue
Waukesha, WI 53186
(414) 549-1111

JOB NUMBER: 3929

N

SCALE: 1" = 40'

PMR 2-12

418-548