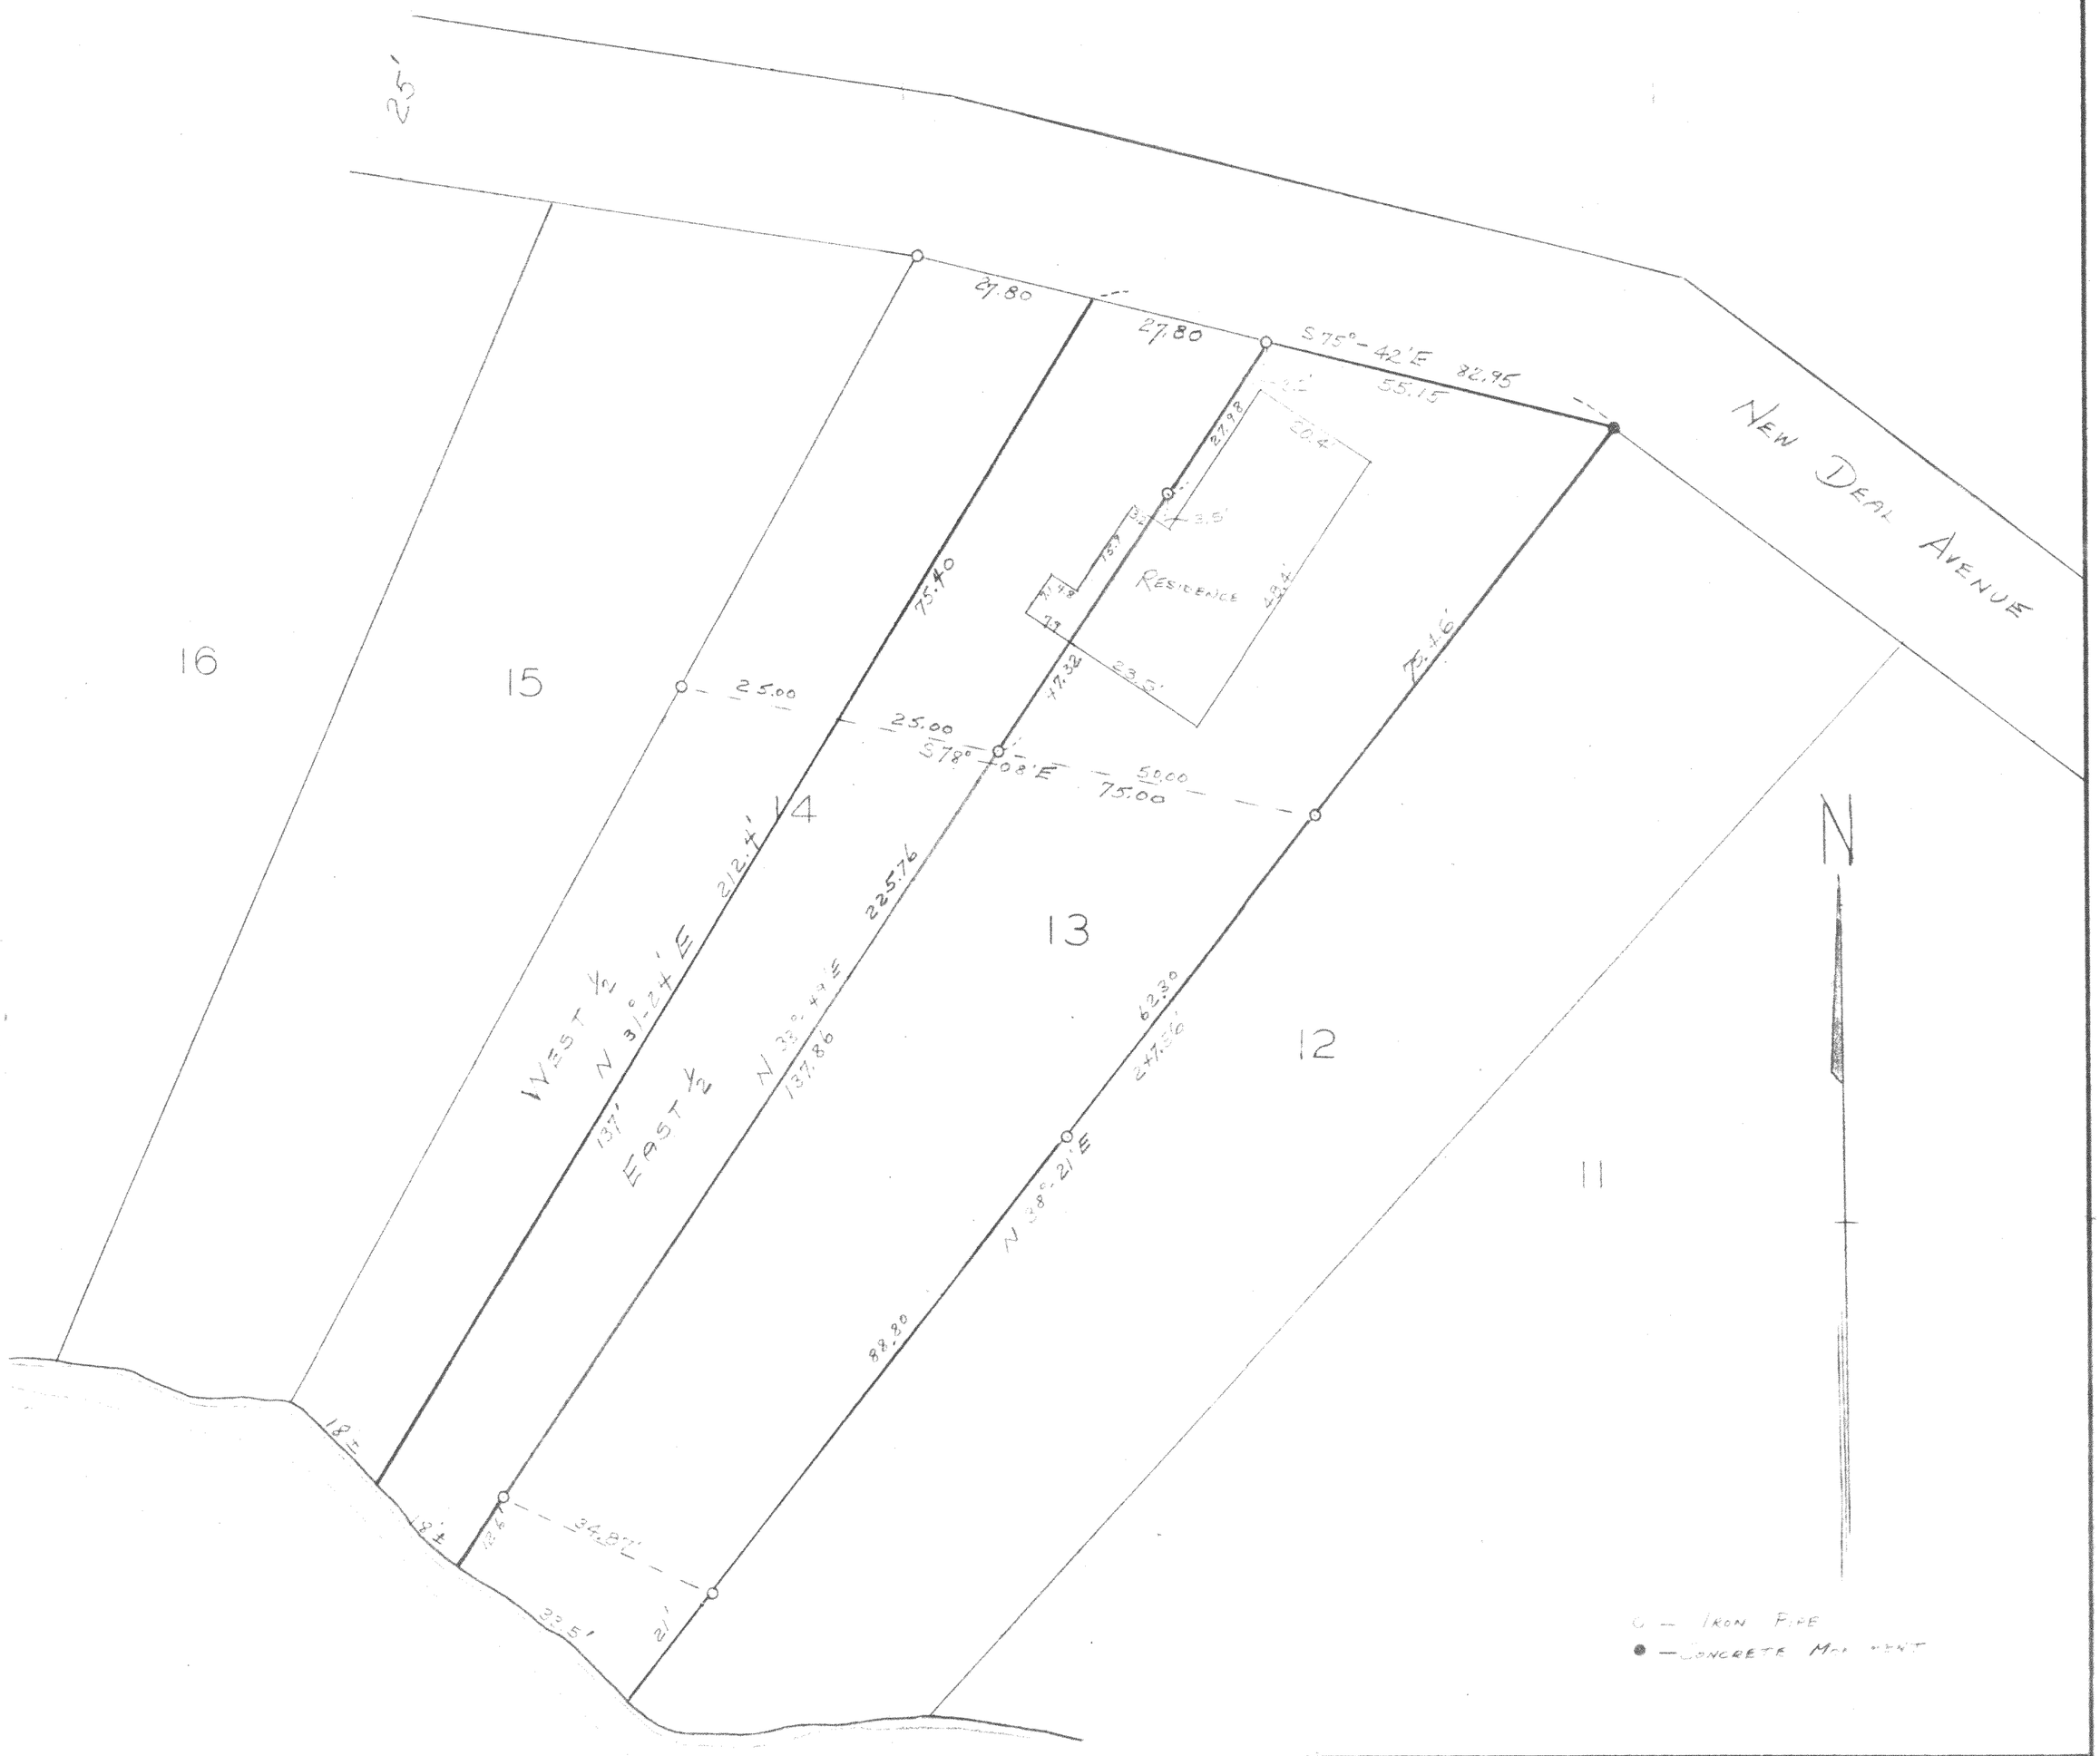

PLAT OF SURVEY
OF
LOTS 13 & 14 OF FREUCK'S SUBDIVISION
LOCATED IN
T4N R18E, WALWORTH COUNTY,
WISCONSIN

Floyd L. Jensen
SURVEYOR

SCALE 1" = 20'

DATE JANUARY 1956
REVISED MARCH 1956

418-64J

NO. 177H—400—3-10-53

Key No. PFS.-12