
FARRIS, HANSEN & ASSOCIATES, INC.

7 RIDGEWAY COURT, P.O. BOX 437
ELKHORN, WISCONSIN 53121

PHONE: (414) 723-2098
FAX: (414) 723-5886

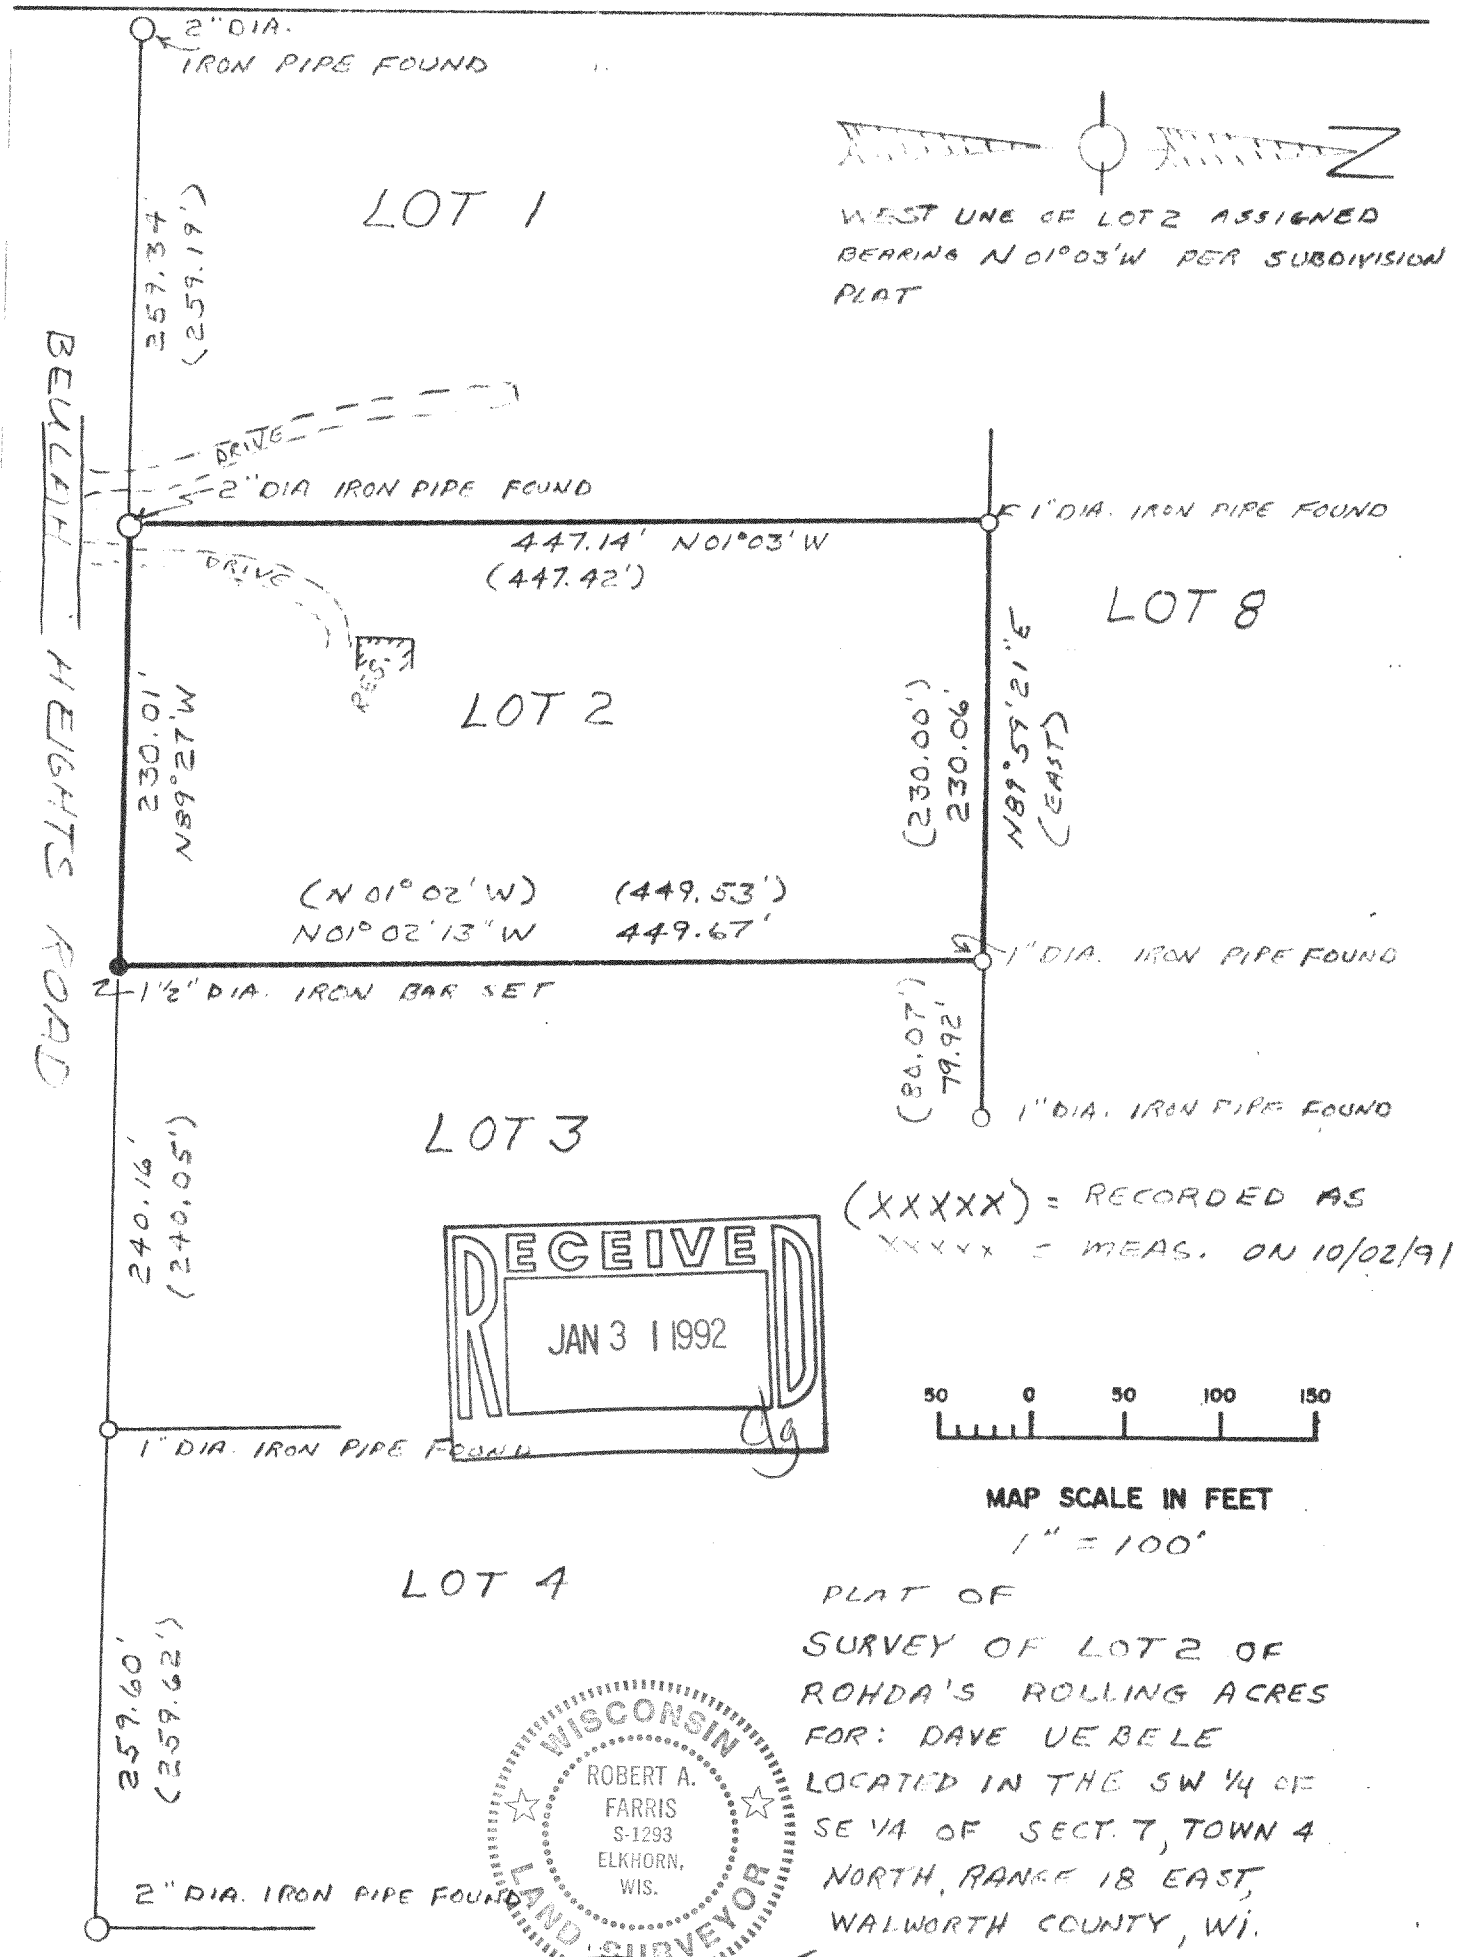

RECEIVED
JAN 3 1 1992

PLAT OF
SURVEY OF LOT 2 OF
ROHDA'S ROLLING ACRES
FOR: DAVE UEBELE
LOCATED IN THE SW ¼ OF
SE ¼ OF SECT. 7, TOWN 4
NORTH, RANGE 18 EAST,
WALWORTH COUNTY, WI.

WISCONSIN
ROBERT A. FARRIS
S-1293
ELKHORN, WIS.
LAND SURVEYOR

DATED: 10/02/91

PROJECT NO. 1329.LT2

I HEREBY CERTIFY THAT THE ABOVE DESCRIBED PROPERTY HAS BEEN SURVEYED UNDER MY DIRECTION AND THAT THE ABOVE MAP IS A TRUE REPRESENTATION THEREOF AND SHOWS THE SIZE AND LOCATION OF THE PROPERTY AND ITS EXTERIOR BOUNDARIES. THIS SURVEY IS MADE FOR THE USE OF THE PRESENT OWNERS OF THE PROPERTY, AND ALSO THOSE WHO PURCHASE, MORTGAGE, OR GUARANTEE THE TITLE THERETO WITHIN ONE YEAR FROM THE DATE HEREOF.

PRP-2
PRP-3

11-18-823