
Plat of Survey

Survey For. CICERO BUILDERS — MILLER
Location: 1075 Spleas Skoney Road

Description. LOTS 8 & 9 SPLEAS SUBDIVISION, being a Subdivision in the South East 1/4 of Section 10, Town 1 North, Range 18 East, in the Township of East Troy, Walworth County, Wisconsin.

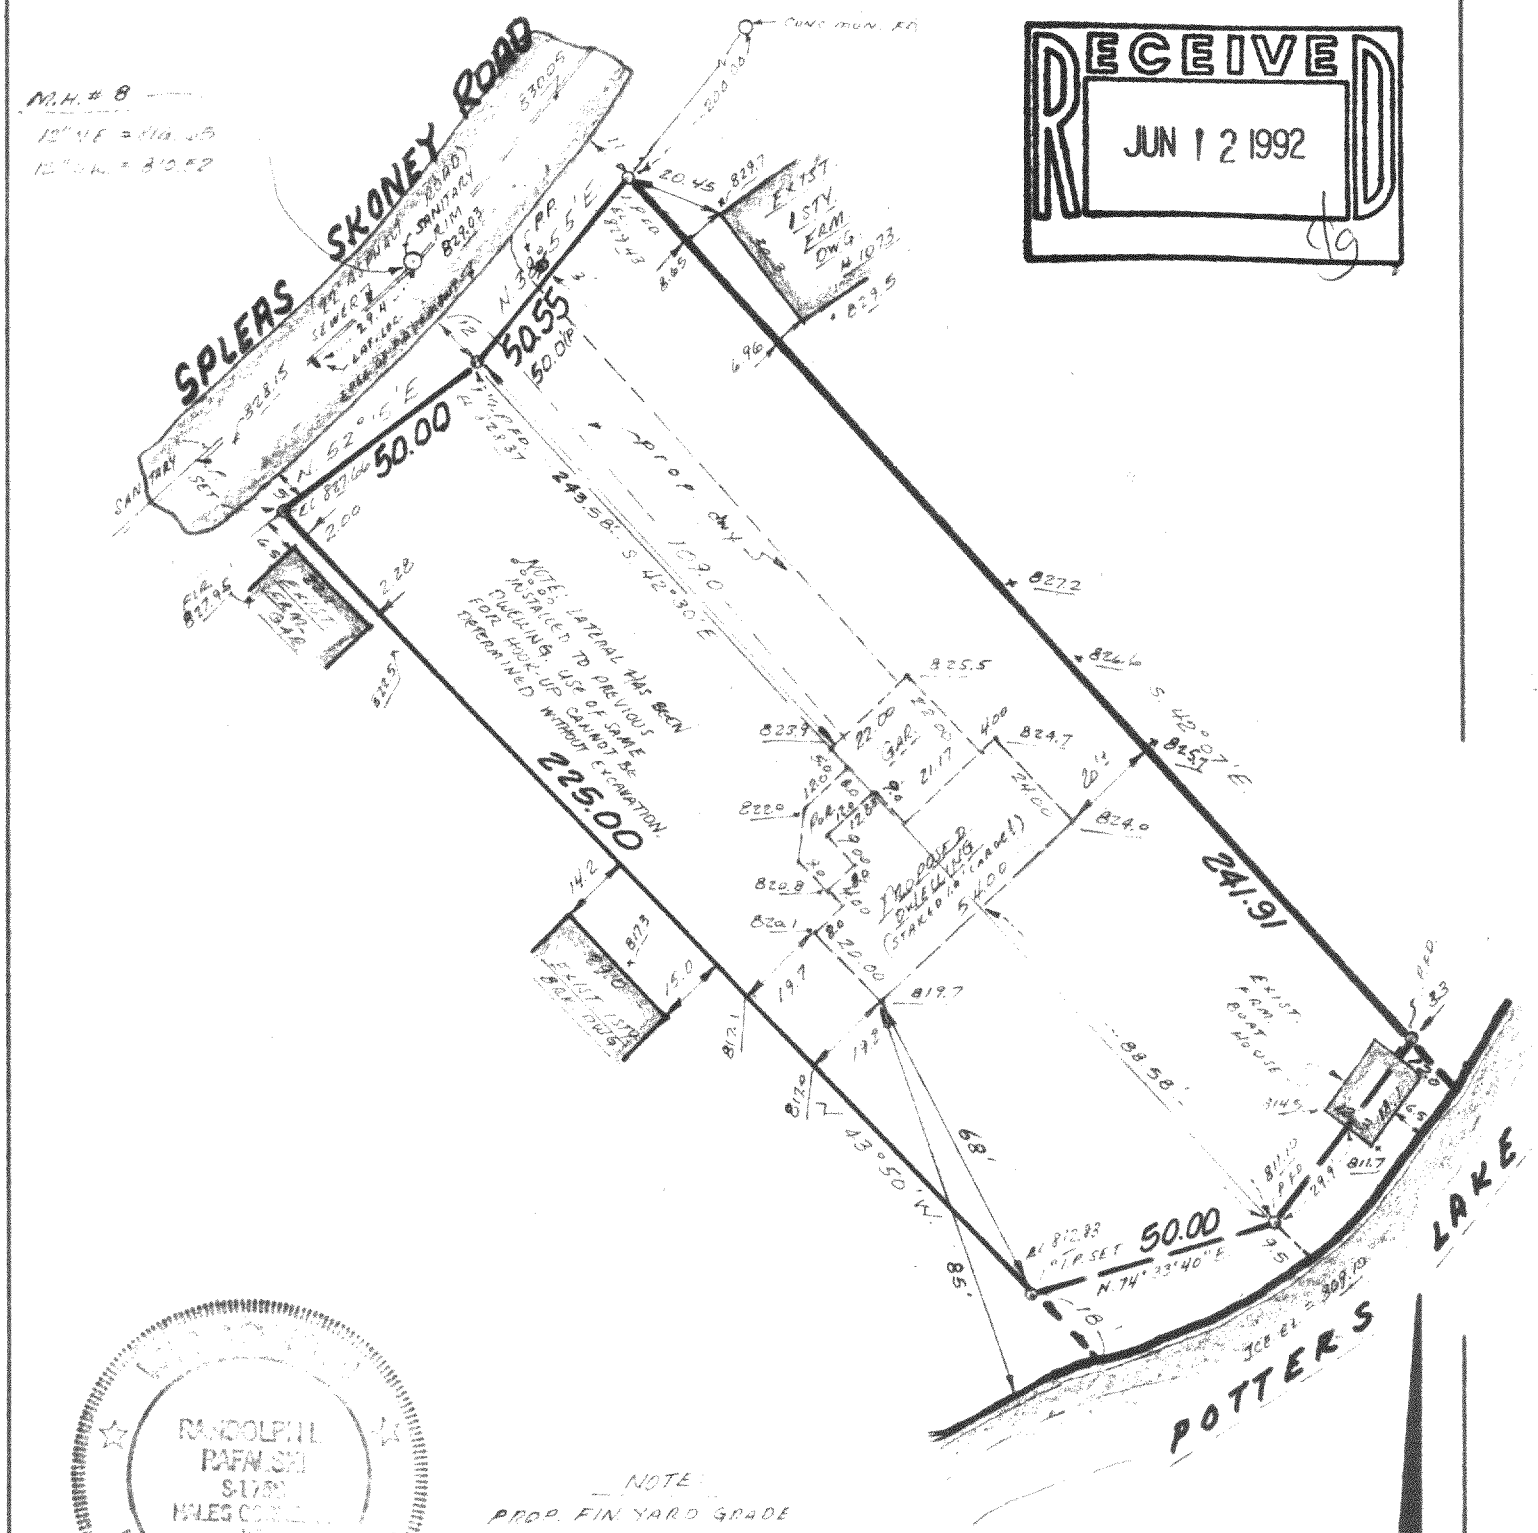

RECEIVED
JUN 12 1992

NOTE:
PROP. FIN YARD GRADE
= EL 826.00

PROP BASEMENT FLOOR = EL 819.25

RANDOLPH L. PARNELL
S-1789
HALES CORNERS
WI
LAND SURVEYOR

INTERLINE SURVEY SERVICES, INC.
11221 W. FOREST HOME AVE
HALES CORNERS, WISCONSIN 53130
PHONE 425-2060

State of Wisconsin)
Milwaukee County ss

SURVEY CERTIFICATE

Scale: 1" = 40'

We, Interline Survey Services, Inc., certify that we have surveyed the above described property and the above map is a true representation thereof, and shows the size and location of the property, its exterior boundaries, the location and dimensions of all visible structures thereon, fences, apparent easements and roadways and visible encroachments, if any.

This survey is made for the exclusive use of the present owners of the Property, and also those who purchase, mortgage, or guarantee the title thereto, within one (1) year from date hereof.

Randolph L. Parnell
Wisconsin Registered Land Surveyor

Date: 2/25/92
Job No.: 20403

418-829

PSP-6