ABERNATHY and ASSOCIATES
Kenneth B. Abernathy Jr.
Wisconsin Registered Land Surveyor S-1594

Rt. 3, Box 273
Elkhorn, Wisconsin 53121
Phone: (414) 723-4260 (office)
(414) 723-4813 (residence)

PLAT OF SURVEY

LOT 2 OF KING'S PARK SUBDIVISION, ACCORDING TO THE OFFICIAL PLAT THEREOF AS RECORDED IN VOL. 9 OF WALWORTH COUNTY PLATS ON PAGE 43 AS DOCUMENT NO. 252349 LOCATED IN SECTION 17, TOWN 4 NORTH, RANGE 18 EAST, TOWN OF EAST TROY, WALWORTH COUNTY, WISCONSIN.

NOTE:


SUBDIVISION PLAT LOCATED IN CABINET 2 ON SLIDE 20

ORDERED BY: B.J. SULLIVAN AND ASSOCIATES
79 WEST MONROE SUITE 905
CHICAGO, IL. 60603-4907

CURRENT OWNER: EDWARD L. KALEITA
P.O. BOX 823
EAST TROY, WI. 53120

ADDRESS OF PROPERTY: 1503 KINGS PARKWAY
EAST TROY, WIS. 53120

TAX KEY NO. PKP 00001A

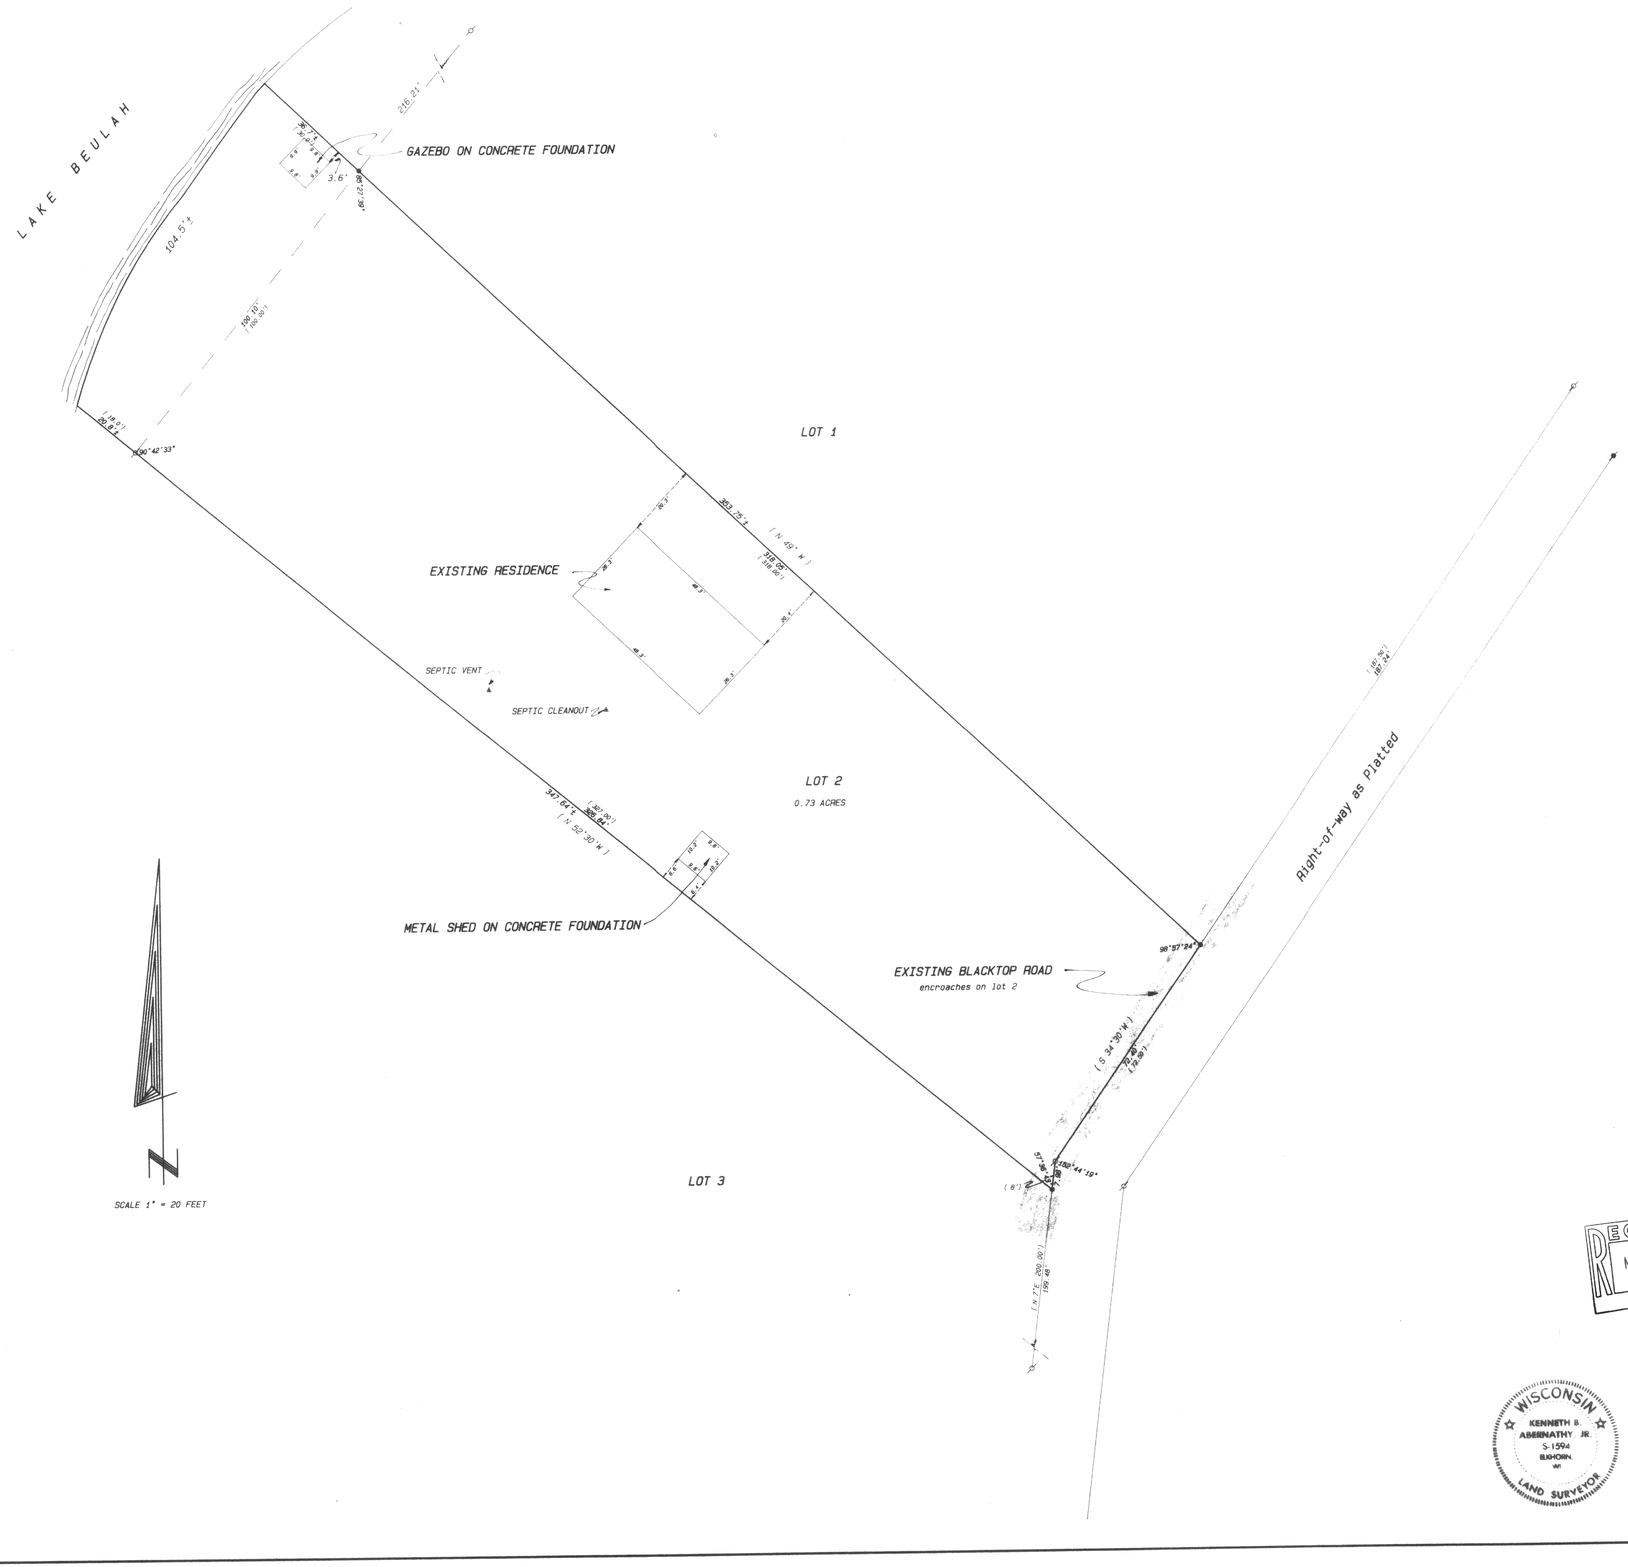

Legend

- FOUND IRON PIPE
- FOUND IRON ROD
- FOUND BRASS CAPPED MONUMENT
- FOUND CONCRETE MONUMENT
- CHISEL CUT IN CONCRETE
- SET IRON ROD, 24" LONG, WEIGHING 1.5 LBS./LINEAL FT., 3/4" DIA.
- SET IRON ROD, 30" LONG, WEIGHING 4.5 LBS./LINEAL FT., 1-13/16" DIA.
- (xx) RECORDED AS DIMENSION
- —x—x— EXISTING FENCE

RECEIVED
MAY 1 2 1992

SCALE: 1"= 20 FEET

"I hereby certify that I have surveyed the above described property and that the above map is a true representation thereof and shows the size and location of the property, its exterior boundaries, the location of all visible structures and dimensions of all principal buildings thereon, boundary fences, apparent easements, roadways and visible encroachments, if any."

"This survey is made for the use of the present owners of the property, and also those who purchase, mortgage, or guarantee the title thereto within one year from date hereof."

WISCONSIN KENNETH B. ABERNATHY JR. S-1594 ELKHORN, WI LAND SURVEYOR

Kenneth B. Abernathy Jr.

KENNETH B. ABERNATHY, JR.
WISCONSIN REGISTERED LAND SURVEYOR,
S-1594

Date: DECEMBER 6, 1991 Job No. 91.1113

418-839

PKP-1A