

PLAT OF SURVEY

Lot 2 of Dutchland Acres Subdivision, located in part of the Southeast 1/4 of the Northeast 1/4 of Section 21, Town 4 North, Range 18 East, Town of East Troy, County of Walworth, State of Wisconsin.

Lot 3

Lot 2
1.03 Acres +

Lot 1



Owner: Ruth Dussault
N8333 Greenwald Court
East Troy, Wisconsin 53120

Greenwald Court

66' Wide

Legend

- FOUND IRON PIPE
 - FOUND IRON ROD
 - FOUND BRASS CAPPED MONUMENT
 - FOUND CONCRETE MONUMENT
 - CHISEL CUT IN CONCRETE
 - SET IRON PIPE, 24" LONG, WEIGHING 1.13 LBS./LINEAL FT., 1" DIA.
 - SET IRON ROD, 30" LONG, WEIGHING 4.5 LBS./LINEAL FT., 1-11/16" DIA.
- (xx) RECORDED AS DIMENSION
- x — x —
EXISTING FENCE

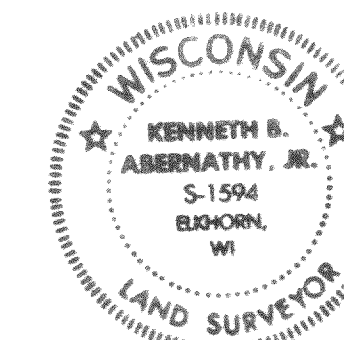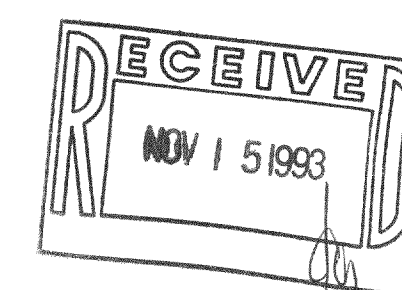

SCALE: 1" = 20 FEET

"I hereby certify that the above described property has been surveyed by me or under my direction and that the above map is a true representation thereof and shows the size and location of the property, its exterior boundaries, the location of all visible structures and dimensions of all principal buildings thereon, boundary fences, appurtenant easements, roadways and visible encroachments, if any."

"This survey is made for the use of the present owners of the property; and also those who purchase, mortgage, or guarantee the title thereto within one year from date hereof."

Kenneth B. Abernathy, Jr.
KENNETH B. ABERNATHY, JR.
WISCONSIN REGISTERED LAND SURVEYOR
S-1594

Date: September 22, 1993 Job No. 1993.914