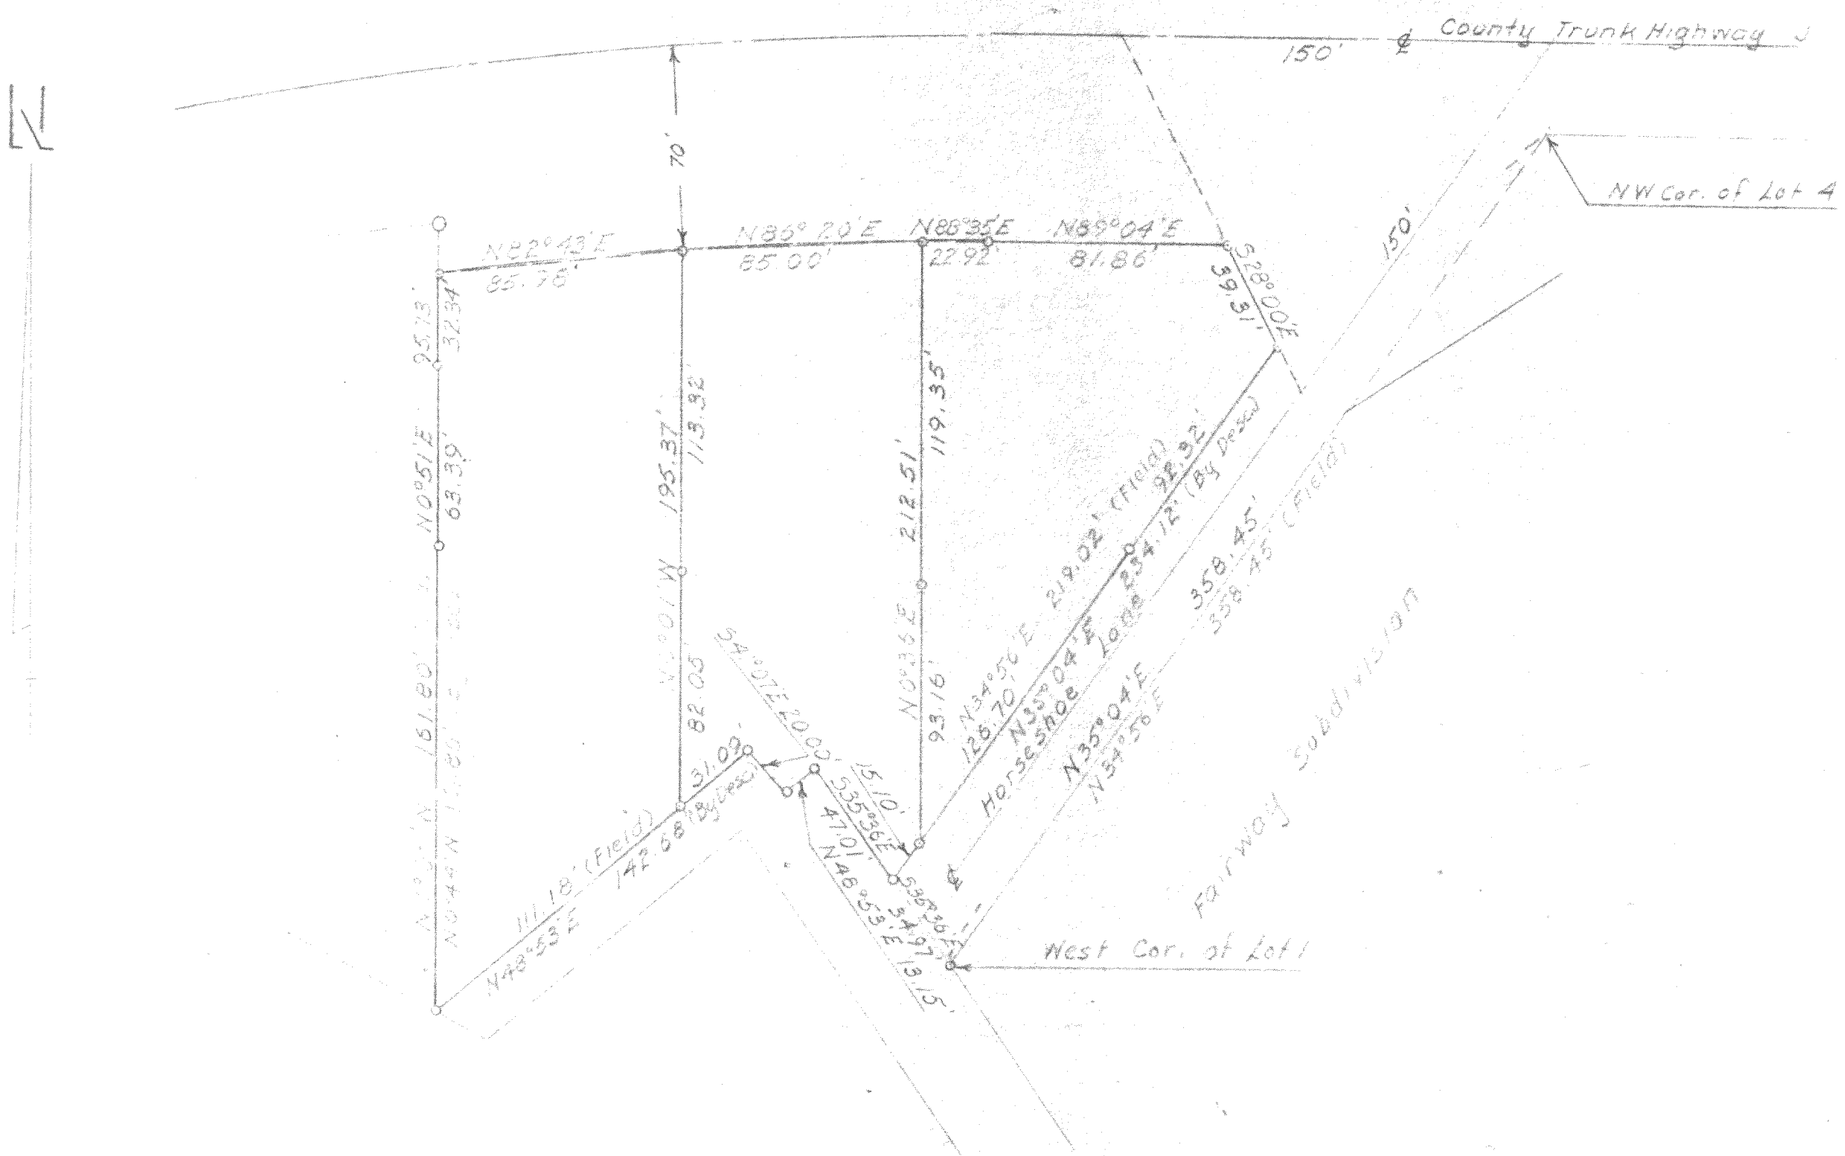

PLAT OF SURVEY
OF


SURVEYOR

SCALE 1" = 50'

DATE November 12

418-94 J

TP-15-A4 RVD
" A5 "
" A6 "