
PLAT OF SURVEY

Sundberg, Carlson and Associates, Inc.
Architects * Engineers * Land Surveyors * Planners
545 BAY VIEW ROAD, MUKWONAGO, WISCONSIN 53149 (414) 363-2004

DATE: 4/8/94

FOR: JAY BULAW

DESCRIPTION: LOT 1 OF ROMADKA PARK BEING A SUBDIVISION IN PART OF THE NW1/4 OF THE NE1/4 OF SECTION 8, TOWN 4 NORTH, RANGE 18E, TOWN OF EAST TROY, WALWORTH COUNTY, WISCONSIN.

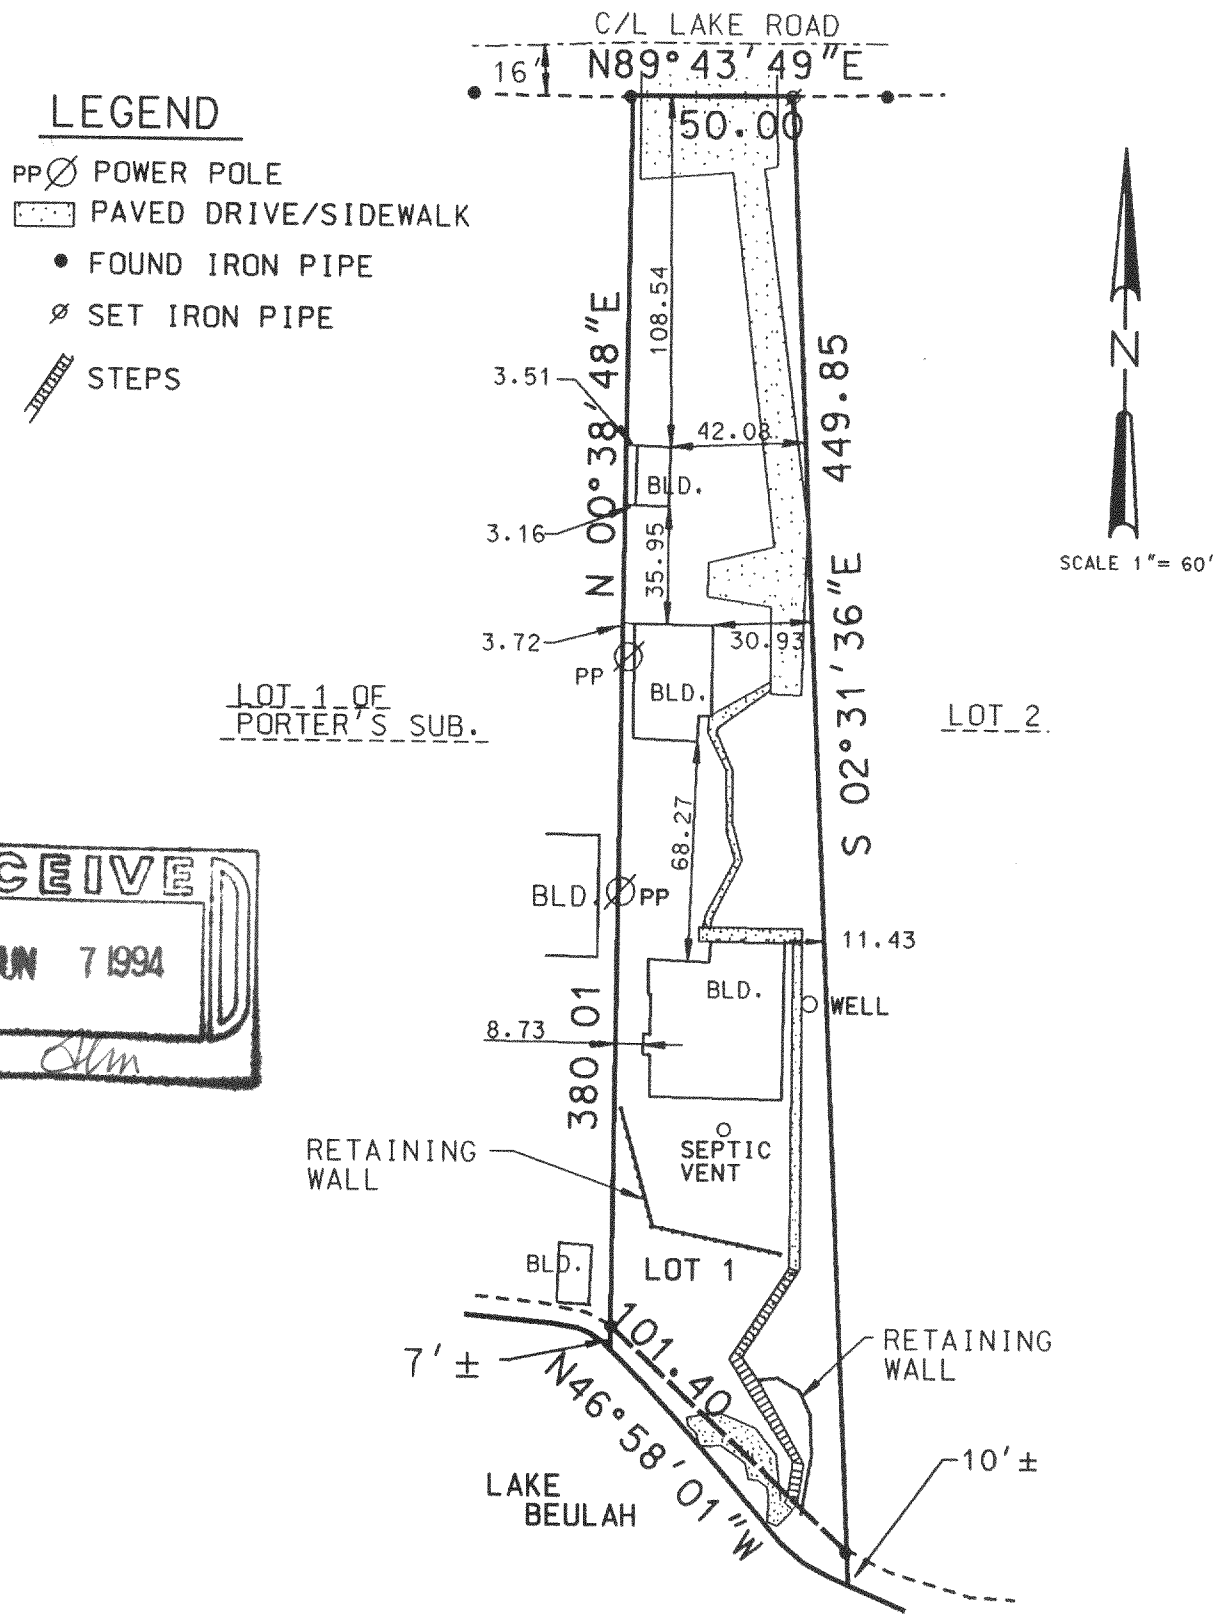

RECEIVED
JUN 7 1994

THE ABOVE MAP IS A TRUE REPRESENTATION THEREOF AND SHOWS THE SIZE AND LOCATION OF ALL THE PROPERTY, EXTERIOR BOUNDARIES, THE LOCATION OF ALL VISIBLE BOUNDARY FENCES, APPARENT EASEMENTS, ROADWAYS AND VISIBLE ENCROACHMENTS, IF ANY.

THIS SURVEY IS MADE FOR THE USE OF THE PRESENT OWNERS OF THE PROPERTY, AND ALSO THOSE WHO PURCHASE, MORTGAGE OR GUARANTEE TITLE THERETO WITHIN ONE (1) YEAR FROM DATE HERETO.

BRADFORD L. SPENCER, R.L.S. 2069

94124.DGN PRP-1

THIS IS ORIGINAL PRINT ONLY IF SEAL IS IMPRINTED IN RED

WISCONSIN
BRADFORD L. SPENCER
S-2069
MUKWONAGO, WIS.
LAND SURVEYOR

418-988