
Record of Survey.

Township 1N, North of Range 16E of 4 Principal Meridian as presented by the courses and distances on the following plat, and annexed field-notes of survey:

Established the center of the section at the point of intersection of STRAIGHT quarter lines.

Established all quarter-quarter corners upon the section boundary at proportional distances between known section and quarter section corners, according to the original field-notes of the Government survey.

Established all lost corners at proportionate distances between known corners, according to the original field notes of the Government survey.

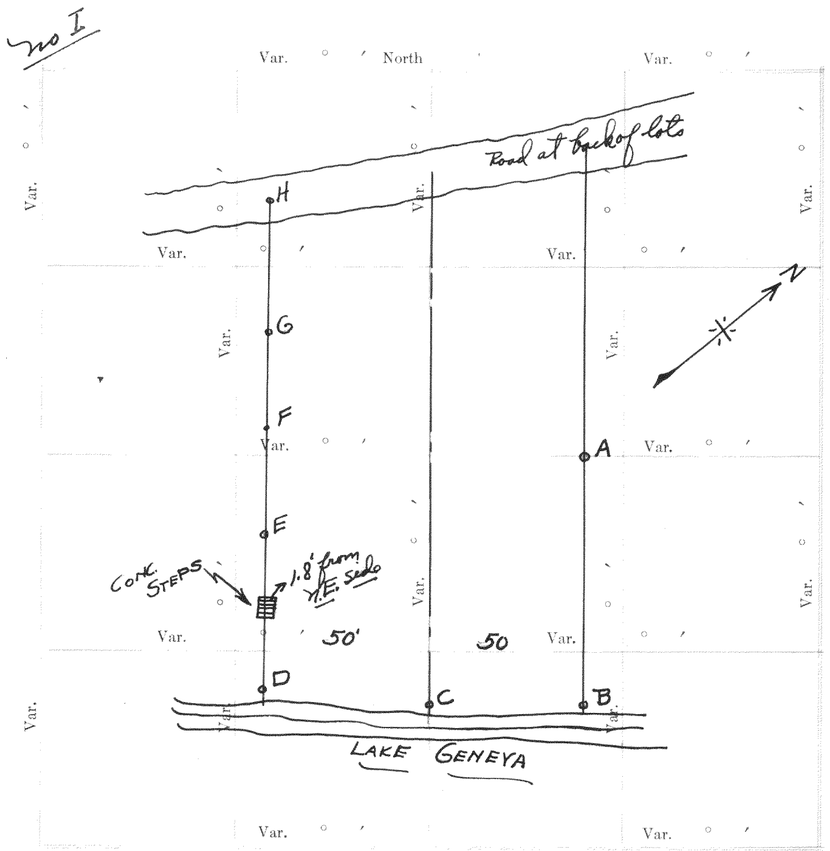

Plat of Section NE 1/4 11, Township 1N North, Range 16E of 4 Principal Meridian Scale 80 chains to 6 inches. The figures in red ink are the lengths of the lines as stated in the field-notes of the Government survey.

Declination of the Magnetic Meridian from the True Meridian —

Surveyed and sub-divided — A. D. 1 , in accordance with the State Laws and Instructions of the Commissioner of the General Land office, and recorded on pages of Register in the County Clerk's office.

Witness my hand this July 6 day of 1932 A. D. 1

Lloyd L. Jensen SURVEYOR.

Revised Feb. 18, 1933

DESCRIPTION

OF SECTION, QUARTER SECTION AND QUARTER QUARTER SECTION CORNERS

I

H. C. MILLER CO., MFG. STATIONERS, MILWAUKEE X15000

GOVERNMENT CORNERS	Bearing Trees	In. Dia.	Courses they bear	Links Distant	Bearing Trees	In. Dia.	Courses they bear	Links Distant	Bearing Trees	In. Dia.	Courses they bear	Links Distant	Bearing Trees	In. Dia.	Courses they bear	Links Distant
No.																
1. N. W. Sec. Cor. indentified,																
2. N. E. Sec. Cor. indentified,																
3. S. E. Sec. Cor. indentified,																
4. S. W. Sec. Cor. indentified,																
5. N. ¼ Sec. Cor. indentified,																
6. E. ¼ Sec. Cor. indentified,																
7. S. ¼ Sec. Cor. indentified,																
8. W. ¼ Sec. Cor. indentified,																
Subdivision Corners																
No.																
1. Center ¼ Sec. Cor.																
2. North ¼-¼s N. W. qr.,																
3. East ¼-¼s N. W. qr.,																
4. South ¼-¼s N. W. qr.,																
5. West ¼-¼s N. W. qr.,																
6. Center ¼-¼s N. W. qr.,																
7. North ¼-¼s N. E. qr.,																
8. East ¼-¼s N. E. qr.,																
9. South ¼-¼s N. E. qr.,																
10. Center ¼-¼s N. E. qr.,																
11. East ¼-¼s S. E. qr.,																
12. South ¼-¼s S. E. qr.,																
13. West ¼-¼s S. E. qr.,																
14. Center ¼-¼s S. E. qr.,																
15. South ¼-¼s S. W. qr.,																
16. West ¼-¼s S. W. qr.,																
17. Center ¼-¼s S. W. qr.																

NAMES OF SWORN ASSISTANTS

CHAINMEN	FLAGMEN	AXMEN

No. I Resurvey of Chas. McCormicks lot on Geneva Lake


Location – Part of lots 142 of Roberts' Sub. in NE¼ of 11. T 1 N, R 16 E.

Monuments – 4 iron pipes at "A", "B", & E as placed by former Surveyor, Set iron stakes at C "D" "F" "G" & "H"

Procedure – Measured 50' & 100' perpendicular to line A-B. Set stakes C & D on the lot lines about 2 feet from the shore.

Ran line DH parallel to AB & 100 feet distant from it. Line crosses steps 1.8' from NE side and divides the side walk leaving most of it on Mrs. McCormick's lot.

No. II

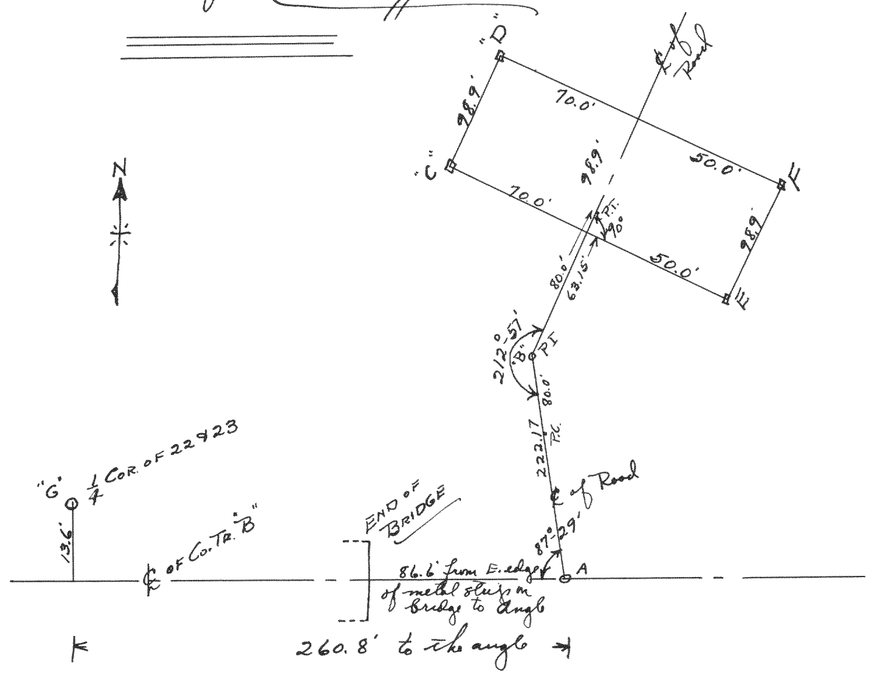

Survey of Property for A. B. Jensen


Location – South Country Club Estates entrance Sec. 23, T 1 N, R 16 E

Monuments – Found iron pipe marking ¼ sec. cor between 22 & 23

Procedure – Started at ¼ sec. cor. thence to Ø of "B" thence down Ø of road 260.80'. Then turned an angle and ran a line up the entrance to the country club estates, turning one angle and keeping as near the Ø of the entrance as possible.

Recorded Feb 18, 1933 — Aug 2, 1932 — Lloyd L. Jensen – Surveyor

No. III

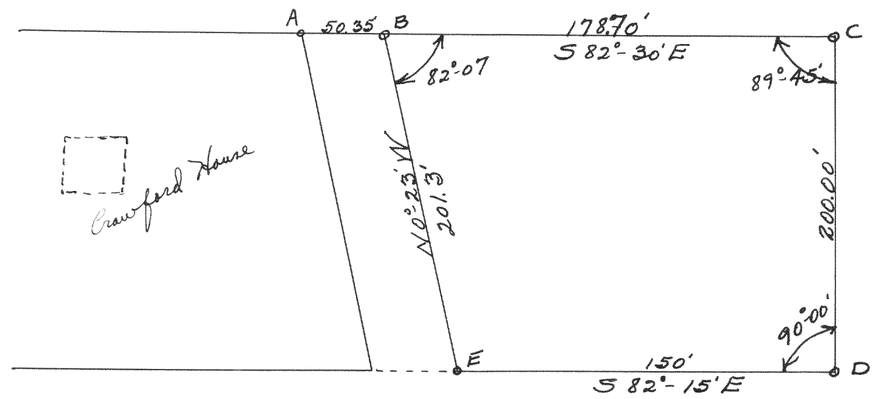

Survey of a small piece for R. N. Crawford

Location – Across the road from R. N. Crawford's residence on Delavan Lake in the NE ¼ sec. 27, T 2 N, R 16 E

Monuments – Found iron pipe at "A"
Set iron pipes at "B", "C" "D" "E"

Procedure – Measured and set iron pipes as shown on sketch, the property being located directly east of R. N. Crawford's lake shore property.

Recorded Feb. 18, 1933

Lloyd L. Jensen Co. Surveyor.