Record of Survey.


Township....., North of Range.....of 4 Principal Meridian as presented by the courses and distances on the following plat, and annexed field-notes of survey:

Established the center of the section at the point of intersection of STRAIGHT quarter lines.

Established all quarter-quarter corners upon the section boundary at proportional distances between known section and quarter section corners, according to the original field-notes of the Government survey.

Established all lost corners at proportionate distances between known corners, according to the original field notes of the Government survey.

No. 22

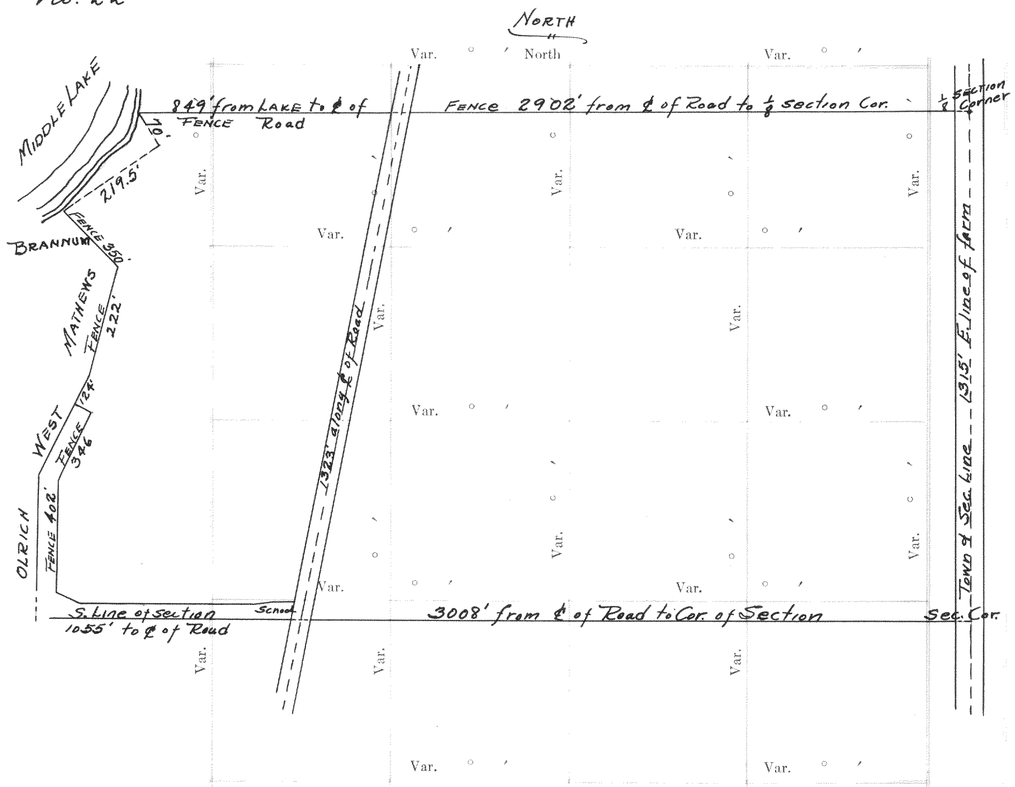

Plat of Section....., Township.....North, Range.....of 4 Principal Meridian Scale 80 chains to 6 inches. The figures in red ink are the lengths of the lines as stated in the field-notes of the Government survey.

Declination of the Magnetic Meridian from the True Meridian.....

Surveyed and sub-divided.....A. D. 1 , in accordance with the State Laws and Instructions of the Commissioner of the General Land office, and recorded on pages .....of Register in the County Clerk's office.

Witness my hand this.....day of.....A. D. 1

.....SURVEYOR.

DESCRIPTION

OF SECTION, QUARTER SECTION AND QUARTER QUARTER SECTION CORNERS

H. C. MILLER CO., MFG. STATIONERS, MILWAUKEE X15000

GOVERNMENT CORNERS	Bearing Trees	In. Dia.	Courses they bear	Links Distant	Bearing Trees	In. Dia.	Courses they bear	Links Distant	Bearing Trees	In. Dia.	Courses they bear	Links Distant	Bearing Trees	In. Dia.	Courses they bear	Links Distant
No.																
1. N. W. Sec. Cor. indentified,																
2. N. E. Sec. Cor. indentified,																
3. S. E. Sec. Cor. indentified,																
4. S. W. Sec. Cor. indentified,																
5. N. ¼ Sec. Cor. indentified,																
6. E. ¼ Sec. Cor. indentified,																
7. S. ¼ Sec. Cor. indentified,																
8. W. ¼ Sec. Cor. indentified,																
Subdivision Corners																
No.																
1. Center ¼ Sec. Cor.																
2. North ¼-⅛s N. W. qr.,																
3. East ¼-⅛s N. W. qr.,																
4. South ¼-⅛s N. W. qr.,																
5. West ¼-⅛s N. W. qr.,																
6. Center ¼-⅛s N. W. qr.,																
7. North ¼-⅛s N. E. qr.,																
8. East ¼-⅛s N. E. qr.,																
9. South ¼-⅛s N. E. qr.,																
10. Center ¼-⅛s N. E. qr.,																
11. East ¼-⅛s S. E. qr.,																
12. South ¼-⅛s S. E. qr.,																
13. West ¼-⅛s S. E. qr.,																
14. Center ¼-⅛s S. E. qr.,																
15. South ¼-⅛s S. W. qr.,																
16. West ¼-⅛s S. W. qr.,																
17. Center ¼-⅛s S. W. qr.																

Location - S½, S½ sec 25, T4N, R16E

Plat of a survey made by the direction of F. M. Porter and O. W. Leach of Elkhorn, Wisconsin to show the length of the lines and the number of acres contained in the farm owned and occupied by R. B. Wilcox. Which farm is the east end of the South half of the South half of section No. 25, Town No. 4 North Range 16 East being the Town of La-Grange, Walworth County, Wisconsin. The lines shown on the West of the plat are the lines of the different owners. And I find there is 117.25 Acres of land enclosed within the lines as shown on the Plat.

Scale of Plat. 1" = 150' Elkhorn Aug. 1st 1925


Wm Child
County Surveyor
Walworth Co. Wisconsin

Recorded Feb. 21, 1933 by
Lloyd S. Jensen
County Surveyor

NAMES OF SWORN ASSISTANTS

CHAINMEN	FLAGMEN	AXMEN

No 23

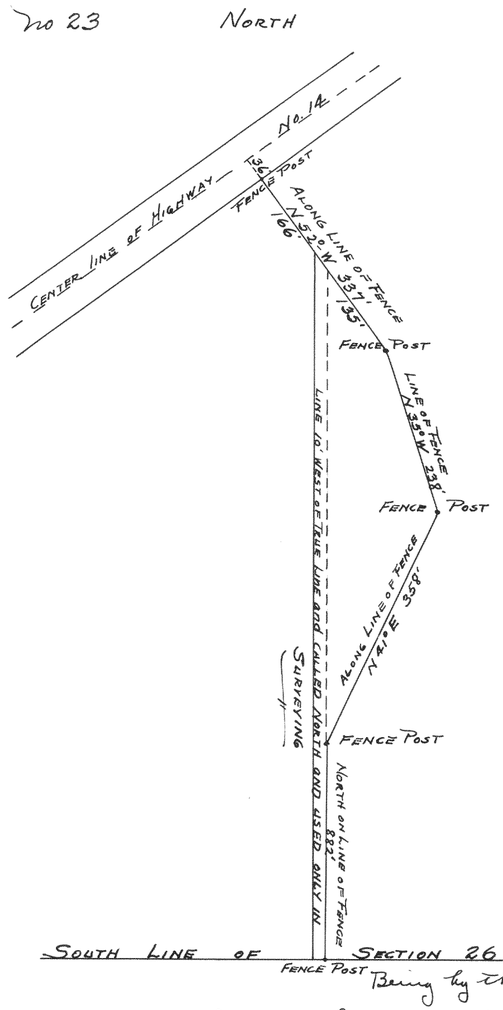

Plat of a survey made to more definitely locate and describe the boundary line between the land conveyed to Michael and Mary Parkinson as shown by Deed Recorded in the Registers of Deeds office in and for Walworth County Wisconsin in Volume 101 of Deeds on Page 43, and the land conveyed to Charles Sodawasser as show by Deed Recorded in the above mentioned office in Volume 130 of Deed's on page 301 a description of which is as follows to wit:- Beginning at a fence post on the South line of section 26, Township 4 North, Range 17 East being the town of Troy, Walworth County, Wisconsin. Thence northerly along the line of the fence 882 feet to a fence post. Thence N 41° E being along the line of fence 358 feet to a fence post. Thence N 35° W being along the line of fence 238 feet to a fence post. Thence N 52° W being along the line of fence 301 feet to a fence post on the south easterly line of the road formerly known as the Milwaukee and Beloit Road now known as Highway 14, and continueing on the same course and line 36 feet to the center of the said Road or highway.

Elkhorn June 11, 1929

Wm Child


County Surveyor

Recorded Feb. 21, 1933 by Lloyd S. Jensen, County Surveyor.

No. 24

46 rods = 759 feet for the place of beginning and 6.73 chains = 444.18 feet the width of the Parkinson land, equalling in all 1203.18 feet west of the South East Corner of section No. 26, Township 4 North Range 17 East being the town of Troy, Walworth County, Wisconsin.

Being by the said Deed

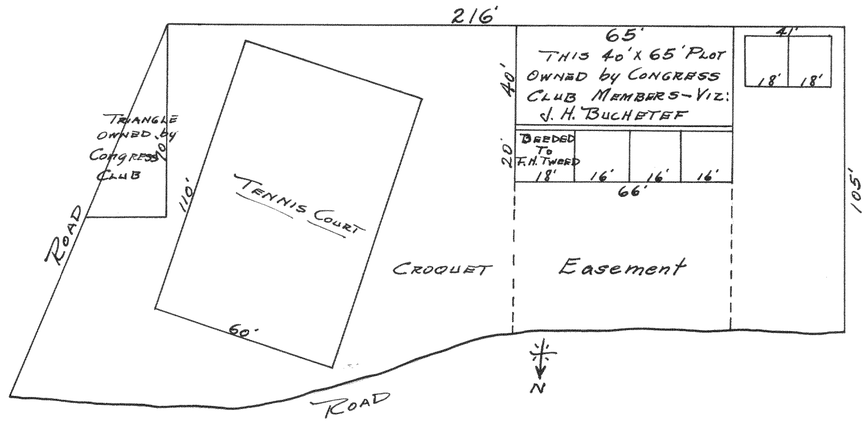

Survey of Tennis Court & Garage Lots of Lock Vista Club.
Location - SW 1/4 sec 1, T 1N, R 16E
Tennis Court & Garage Lots - Property of Lock Vista Club,
Williams Bay, Wisconsin
Arlington Engineering Corporation
111 W. Jackson Boulevard
Chicago Illinois
Recorded Feb. 21, 1933 by Lloyd S. Jensen, County Surveyor.