Record of Survey.

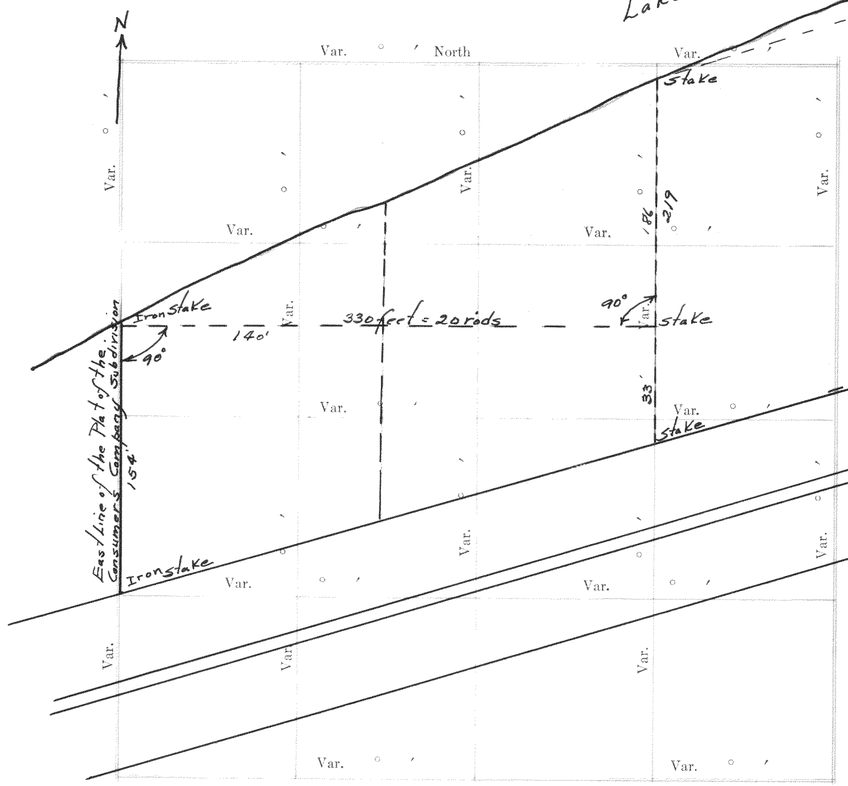
No 317

Township....., North of Range.....of 4 Principal Meridian as presented by the courses and distances on the following plat, and annexed field-notes of survey:

Established the center of the section at the point of intersection of STRAIGHT quarter lines.

Established all quarter-quarter corners upon the section boundary at proportional distances between known section and quarter section corners, according to the original field-notes of the Government survey.

Established all lost corners at proportionate distances between known corners, according to the original field notes of the Government survey.


N
Var.
North
Var.
Var.
Var.

No 318

Plat of a survey made on the East half of section No 34 in the Town of Geneva and the Northeast quarter of section No. 3 in the Town of Linn, Walworth County, Wisconsin

Elkhorn July 22nd 1912

Wm Child
County Surveyor

Recorded by Lloyd S. Jensen C.S.
March 2, 1934