Record of Survey.

5-3-17

No 323

Township ..., North of Range ...of 4 Principal Meridian as presented by the courses and distances on the following plat, and annexed field-notes of survey:

Declination from Survey

Established the center of the section at the point of intersection of STRAIGHT quarter lines.

Established all quarter-quarter corners upon the section boundary at proportional distances between known section and quarter section corners, according to the original field-notes of the Government survey.

Established all lost corners at proportionate distances between known corners, according to the original field notes of the Government survey.

Beginning at the Southwest corner of the South west quarter of Section 5, Town of Fayette, Walworth, County, Wisconsin, Thence North on the West line of said Section 330 feet to a point in the center of the road as now fenced, Thence Northeasterly along the center of said road 165 feet, Thence Southeasterly 410 feet on a line to an iron stake on the South line of said quarter Section 287 feet East of the place of beginning, ~~Thence West on said line 287 feet~~

Excepting and reserving from the above described piece so much thereof as would lie between the above mentioned line running Southeasterly on the Northeasterly side of said piece and the following described line,- Beginning at the above mentioned iron stake on the South line of said Quarter section, Thence Northwesterly 80' along the line of one certain fence to a point that shall be two feet and four inches Southwesterly from said line and being the Southeasterly corner of an open shed, Thence Northwesterly along the Northeasterly side of said shed 63 feet to the Northeast corner thereof and said corner being three feet Southwesterly of said line, Thence Northwesterly along one certain fence 35 feet to the southeast corner of a wagon shed and corn crib and which corner is three feet and six inches Southwesterly from said line, Thence Northwesterly along the Northeasterly side of said crib or wagon shed 34 feet to the Northeast corner thereof, and which point is three feet and six inches Southwesterly from said line, Thence Northwesterly along the line of one certain fence 68 feet to the center of a burr oak tree, which point is one foot and nine inches Southwesterly from said line, Thence Northwesterly along the line of one certain fence 105.3 feet to a fence post on the Southeasterly line of the above mentioned road and being also on the Northeasterly line of the above described piece.

Surveyed by W^m Child C.S.

Recorded by Lloyd S. James C.S. March 3, 1934

Plat of Section ..., Township ...North, Range ...of 4 Principal Meridian Scale 80 chains to 6 inches. The figures in red ink are the lengths of the lines as stated in the field-notes of the Government survey.

Declination of the Magnetic Meridian from the True Meridian .....

Surveyed and sub-divided ...A. D. 1 , in accordance with the State Laws and Instructions of the Commissioner of the General Land office, and recorded on pages ...of Register in the County Clerk's office.

Witness my hand this ...day of ...A. D. 1

...SURVEYOR.

DESCRIPTION

OF SECTION, QUARTER SECTION AND QUARTER QUARTER SECTION CORNERS

N. C. MILLER CO., MFG. STATIONERS, MILWAUKEE X15000

GOVERNMENT CORNERS	Bearing Trees	In. Dia.	Courses they bear	Links Distant	Bearing Trees	In. Dia.	Courses they bear	Links Distant	Bearing Trees	In. Dia.	Courses they bear	Links Distant	Bearing Trees	In. Dia.	Courses they bear	Links Distant
No.																
1. N. W. Sec. Cor. indentified,																
2. N. E. Sec. Cor. indentified,																
3. S. E. Sec. Cor. indentified,																
4. S. Sec. Cor. indentified,																
5. N. ¼ Sec. Cor. indentified,																
6. E. ¼ Sec. Cor. indentified,																
7. S. ¼ Sec. Cor. indentified,																
8. W. ¼ Sec. Cor. indentified,																
Subdivision Corners																
No.																
1. Center ¼ Sec. Cor.																
2. North ¼-⅛s N. W. qr.,																
3. East ¼-⅛s N. W. qr.,																
4. South ¼-⅛s N. W. qr.,																
5. West ¼-⅛s N. W. qr.,																
6. Center ¼-⅛s N. W. qr.,																
7. North ¼-⅛s N. E. qr.,																
8. East ¼-⅛s N. E. qr.,																
9. South ¼-⅛s N. E. qr.,																
10. Center ¼-⅛s N. E. qr.,																
11. East ¼-⅛s S. E. qr.,																
12. South ¼-⅛s S. E. qr.,																
13. West ¼-⅛s S. E. qr.,																
14. Center ¼-⅛s S. E. qr.,																
15. South ¼-⅛s S. W. qr.,																
16. West ¼-⅛s S. W. qr.,																
17. Center ¼-⅛s S. W. qr.																

NAMES OF SWORN ASSISTANTS

CHAINMEN	FLAGMEN	AXMEN

18-3-17

No 324 Town of La Fayette

From stake on East and W. qr. line and on C. of road W. 33 line, 60 fence 14 N. of N. end of R.R. fence 64 S. of end, 110 center of R.R. 16 W. line, N. at 64, 23 West corner of fence 140.5 center of track, West at R.R. to track, 14 center of track 21, South along line 44 center of ditch 69 fence 82 North of corner, This corner is 66 from fence is 50 W. of center of track, Co. along track 82 fence and end of bridge 137 center of crossing 158.5 NE from Station at 79 Guard fence at 100, 38 fence 7 N. of corner

Recorded dist.	fence				
79.97	110	, 200 - 37, 62 more 895, 16 S. of tree 23 line			
Track bears W 5 & fence 10,	300	34.5	94	115	
	400	34	82	100	
	500	33	35 more 56 marsh		


405. Ranger 6 W. of center R.R. track 8 W. of fence 576 angle 33.5 27 more 51 8 from center is ranger 735 (2) N. end of marsh angle to right 2-20, 100 5.7 W. rail 38-61-83 edge of marsh, 200 7.5 W. rail 39.5 S. of Culvert 65-84 6 ranger 300 8.7 38-67-86 end of M. west. 50 more N to end of marsh E

400 - 9 - 34 - 68 - 90
500 - 8.5 - 31.5 - 66 - 88
600 - 7.5 - 30 - 62 - 88
700 - 5 - 24.5 - 54 - 93.8 S. of fence corner
787.5 - 0 - 22.5 - 51 - 81
on line 26-59-96.5 15 N. of fence corner
18 along angle to other corner
100 1.2 E to W. line 23-52 78
200 5.7 E " " " 25-52-74
300 11.5 E " " " 27-35 E. of Road N. 61 center
761 from 200 point 5 more W. Then to corner of Humphrey is line of old fence.

Surveyed by W. McChild C.S.
June 18, 1912
Recorded by Floyd S. Jensen C.S.
March 3, 1934

No 325

NE of 31-3-17

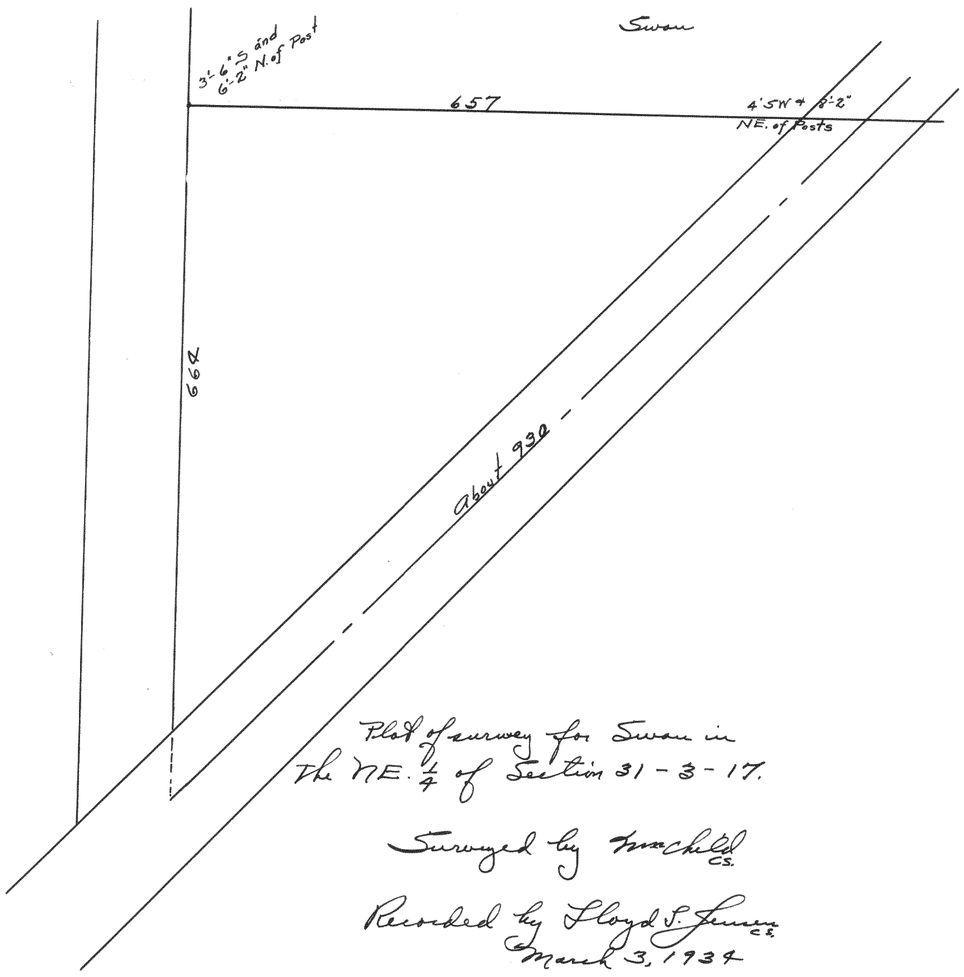

Plat of survey for Swan in The NE. 1/4 of Section 31-3-17.

Surveyed by W. McChild C.S.

Recorded by Floyd S. Jensen C.S.
March 3, 1934