Record of Survey.

no 341

17-4-18

Township....., North of Range..... F. E. Schaefer, Principal Meridian, Mon. as presented by the courses and distances on the following plat, and annexed field-notes of survey:

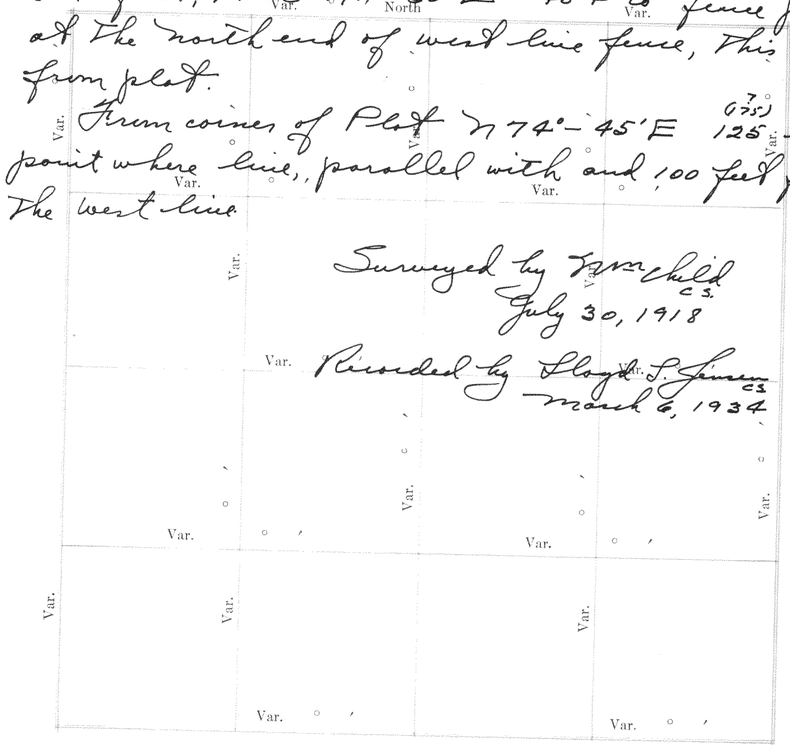
Established the center of the section at the point of intersection of straight quarter-lines.

Established all quarter-quarter corners upon the section boundaries at proportional distances between known points and quarter-section corners, according to the original field-notes of the [illegible] survey.

Established all lost corners at proportionate distances between known corners, according to the original field notes of the [illegible] survey.

From Southwest Corner of Eastmore Park, said corner is on the West line of Pastime Park to the N 53° W and the South side is N 74 3/4° E 804 feet, Then N 1°-30' E 404 to fence post at the north end of west line fence, This is from plat.

From corner of Plat N 74°-45' E 125 is point where line, parallel with and 100 feet from the west line.


Var.
North
Var.
Var.
Var.

No 343

Lyons

C.C. Reeve

On center of road at Southeast corner of lot 7 found stake, drove iron stake also 290.2 feet Southwest in center of street found stake, iron stake also found stake in center of Street 68 feet west of stone. Ran line over last two stakes on south and set stake 33 feet east in center of Street at corner of Forty lot. At stake in center of street at S.E. of 7 turned off R.A. West and set stake 33 feet west from this South 135 feet to post hole 100 feet from R.R track, from stake on W. of Street W. found measurements to correspond with lines and points said to be known, drove stake at Southeast of 7. Northeast 460 feet and left hub Then 208.8 ft. found

Surveyed by Wm Child CS.
Aug. 9, 1901

Recorded by Lloyd S. Jensen CS.
March 8, 1934

No. 344

10-2-18 Lyons

Found iron stake at northwest corner of Martin mobbs piece on S. of road, from this measured east along road 9.90 = 653.4 feet being the distance shown on a plat, This comes to East of Miller stump, set back about 60 feet and drive iron stake on or near this line and 25 ft. Southeast of this drive iron stake, 10 feet from pond, on line of these stakes, drive 3 iron stakes 52.4 feet Northwest and which stake is in line with the South side of iron on the South side of the bridge and is 236.7 from the large bolt in the iron work on said bridge.

Surveyed by Wm Child CS.
Dec. 15, 1911

Recorded by Lloyd S. Jensen CS.
March 8, 1934