Record of Survey.


No 345

Township....., North of Range.....of 4 Principal Meridian as presented by the courses and distances on the following plat, and annexed field-notes of survey:


Established the center of the section at the point of intersection of STRAIGHT quarter lines.

Established all quarter-quarter corners upon the section boundary at proportional distances between known section and quarter section corners, according to the original field-notes of the Government survey.

Established all lost corners at proportionate distances between known corners, according to the original field notes of the Government survey.

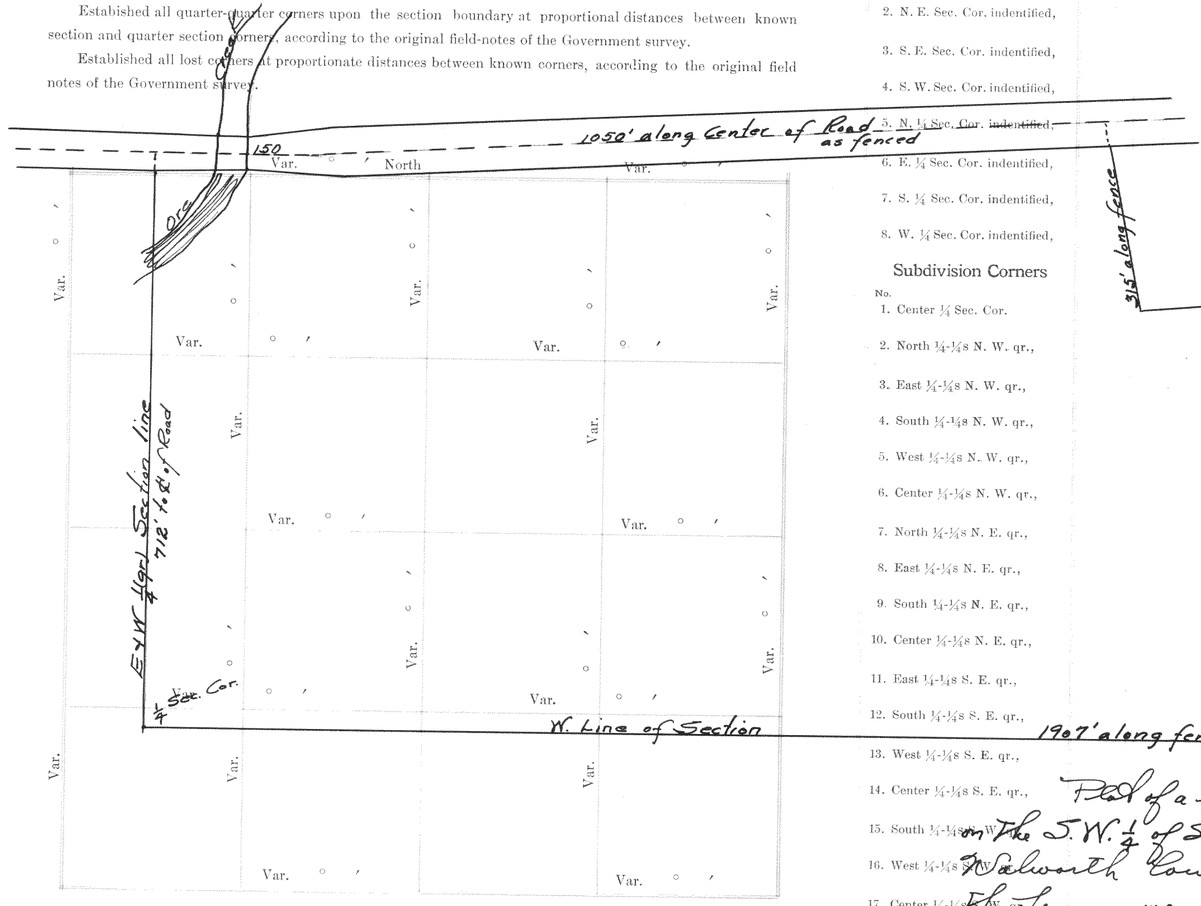
1050' along Center of Road as fenced
150
Var.
North
Var.
Var.
Var.

No 346

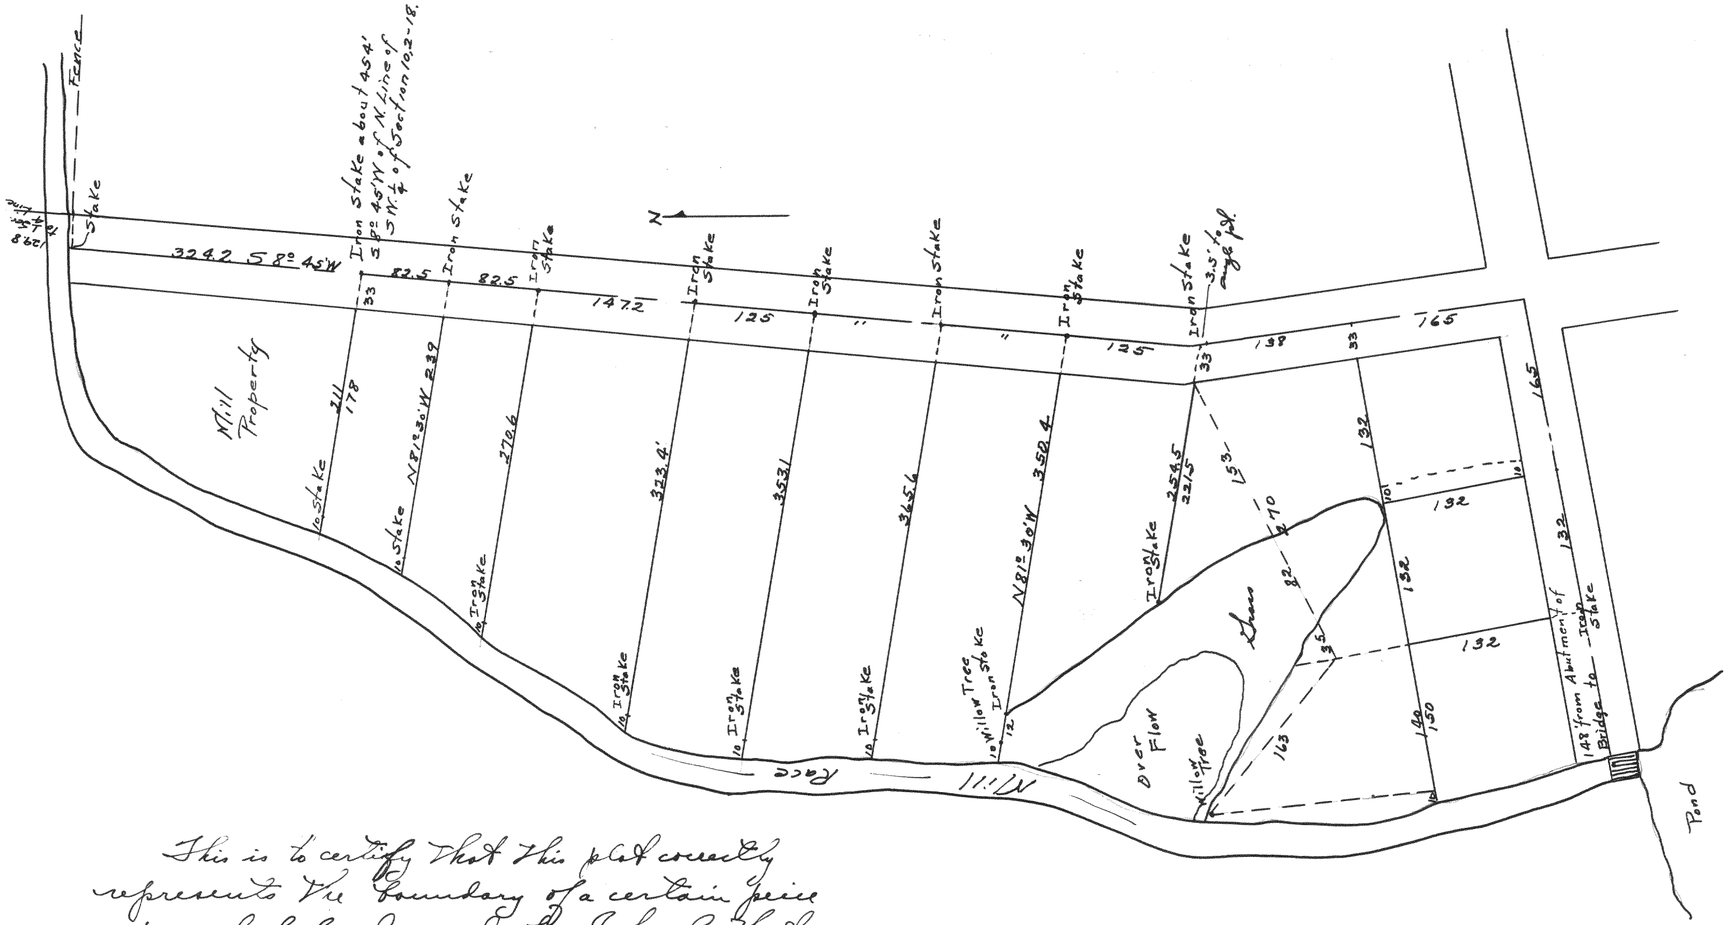

This is to certify That this plat correctly represents the boundary of a certain piece or parcel of land owned by John A. Hart and others in Section No. 10, in The Town of Lyons, Walworth County, Wis.
Survey completed Oct. 15, 1918
Wm Child
Surveyor

Recorded by Lloyd S. Jensen Co
March 8, 1934