Record of Survey.

No 348


Lyons

Township ..., North of Range 10-2-18 ...of 4 Principal Meridian as presented by the courses and distances on the following plat, and annexed field-notes of survey:

Established the center of the section at the point of intersection of straight section lines.

Established all quarter-quarter corners upon the section boundary at proportional distances between known section and quarter section corners, according to the original field-notes of the Government survey.

Established all lost corners at proportionate distances between known corners, according to the original field notes of the Government survey.

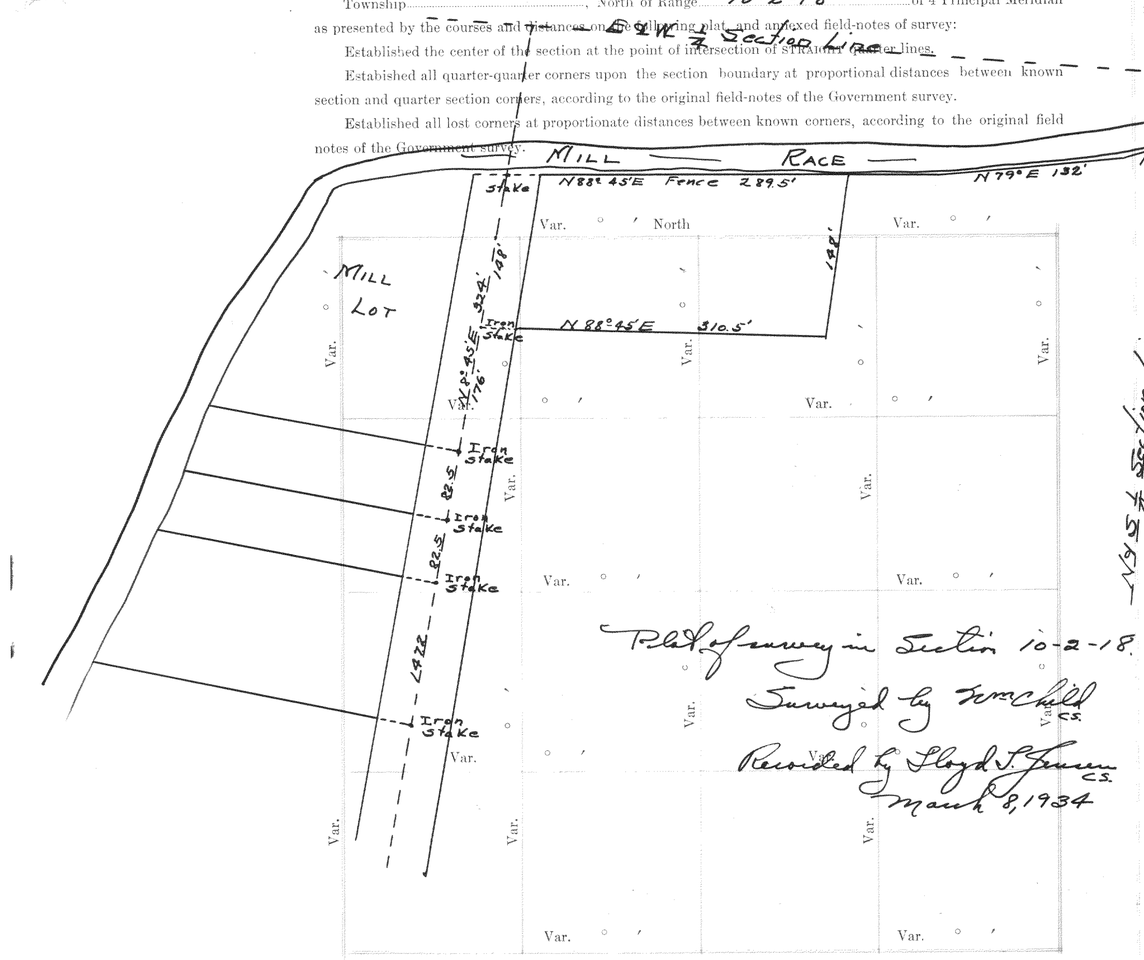

Plat of Section ..., Township ...North, Range ...of 4 Principal Meridian Scale 80 chains to 6 inches. The figures in red ink are the lengths of the lines as stated in the field-notes of the Government survey.

Declination of the Magnetic Meridian from the True Meridian ...

Surveyed and sub-divided ...A. D. 1 , in accordance with the State Laws and Instructions of the Commissioner of the General Land office, and recorded on pages ...of Register in the County Clerk's office.

Witness my hand this ...day of ...A. D. 1

...SURVEYOR.

DESCRIPTION


OF SECTION, QUARTER SECTION AND QUARTER QUARTER SECTION CORNERS

H. C. MILLER CO., MFG. STATIONERS, MILWAUKEE X15000

GOVERNMENT CORNERS	Bearing Trees	In. Dia.	Courses they bear	Links Distant	Bearing Trees	In. Dia.	Courses they bear	Links Distant	Bearing Trees	In. Dia.	Courses they bear	Links Distant	Bearing Trees	In. Dia.	Courses they bear	Links Distant
No.																
1. N. W. Sec. Cor. indentified,																
2. N. E. Sec. Cor. indentified,																
3. S. E. Sec. Cor. indentified,																
4. S. W. Sec. Cor. indentified,																
5. N. ¼ Sec. Cor. indentified,																
6. E. ¼ Sec. Cor. indentified,																
7. S. ¼ Sec. Cor. indentified,																
8. W. ¼ Sec. Cor. indentified,																
Subdivision Corners																
1. Center ¼ Sec. Cor.																
2. North ¼-⅛s N. W. qr.,																
3. East ¼-⅛s N. W. qr.,																
4. South ¼-⅛s N. W. qr.,																
5. West ¼-⅛s N. W. qr.,																
6. Center ¼-⅛s N. W. qr.,																
7. North ¼-⅛s N. E. qr.,																
8. East ¼-⅛s N. E. qr.,																
9. South ¼-⅛s N. E. qr.,																
10. Center ¼-⅛s N. E. qr.,																
11. East ¼-⅛s S. E. qr.,																
12. South ¼-⅛s S. E. qr.,																
13. West ¼-⅛s S. E. qr.,																
14. Center ¼-⅛s S. E. qr.,																
15. South ¼-⅛s S. W. qr.,																
16. West ¼-⅛s S. W. qr.,																
17. Center ¼-⅛s S. W. qr.																

No 348

Lyons

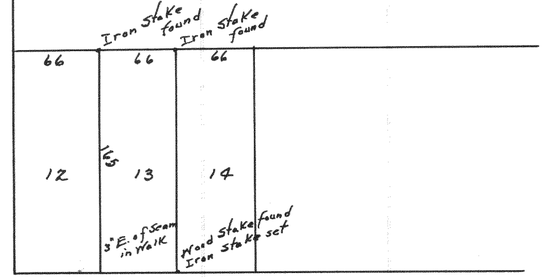

Field of survey in Courtlock add. to the village of Lyons.

Surveyed by Wm Child C.S.

Recorded by Lloyd J. Jensen C.S.
March 8, 1934

NAMES OF SWORN ASSISTANTS

CHAINMEN | FLAGMEN | AXMEN

no. 349 1-1-16

Ben. Hoby

Found old stake at S W. corner of Block 5 of Wm Bay, also stakes and stake holes of lots on West line of block, and as angle stake in road is gone, I set stake at 65 + 38.35 north from iron stake found at corner of lot. Produced the west line of block South 70 feet and find stake hole and set iron stake from this stake, west on line to point on 1/8 line 247.5 feet = 3.75 chains north of 1/8 post 66 feet and set monument for corner of plat. Then west 237.6 feet to 1/8 line and set monument north on 1/8 line 70 and set iron stake for northwest corner of lot 4 and Southwest of lot 3. Then 263.5 feet more to center of road 11.6 feet northeast of Red cedar stake at angle of road. Set monument northeast 118.5 feet to my point 102.1 from monument at Right angle to 1/8 post.

Surveyed by Wm Child C.S.

Recorded by Lloyd S. Jensen C.S.
March 8, 1934

no. 350 Wm Bay

Judge Lyons

West end 3 X 94 + 12 = 294 - 24.7 = 269 3/4 line, from 1/4 line to fence 269.3, 1/8 line East to corner of piece 722. North from fence 267 post 291.7 quarter line, West 716.3 to 1/8 corner.

Surveyed by Wm Child C.S.

Recorded by Lloyd S. Jensen C.S.
March 8, 1934