Record of Survey.

No 351 Observatory Sub.

Township....., North of Range.....of 4 Principal Meridian as presented by the courses and distances on the following plat, and annexed field-notes of survey:

Established the center of the section at the point of intersection of STRAIGHT quarter lines.

Established all quarter-quarter corners upon the section boundary at proportional distances between known section and quarter section corners, according to the original field-notes of the Government survey.

Established all lost corners at proportionate distances between known corners, according to the original field notes of the Government survey.

Beginning at the northwest corner of Lot 5 in the Observatory Subdivision so-called, in the Southwest quarter of Section 1, T1N, R16E, according to the plat thereof of said subdivision on record in the office of the Register of Deeds in and for said County of Walworth, Thence running due East along Var. ° ' North Var. ° ' East line eighty one and one half feet to West boundary line of lands now owned by Joseph Lackey and purchased of said parties of the first part; Thence South along said west boundary line two hundred feet (200); Thence west along north boundary of said lands owned by Joseph Lackey 81.5 feet; Thence North 200 feet to place of beginning, excepting a strip 20 feet wide off the west side of parcel described above. (Description from survey)

Surveyed by Wm Child C3.

Recorded by Lloyd S. Jensen C3. March 9, 1934

Var. ° ' Var. ° ' Var. ° ' Var. ° '

Plat of Section....., Township.....North, Range.....of 4 Principal Meridian Scale 80 chains to 6 inches. The figures in red ink are the lengths of the lines as stated in the field-notes of the Government survey.

Declination of the Magnetic Meridian from the True Meridian.....

Surveyed and sub-divided.....A. D. 1 , in accordance with the State Laws and Instructions of the Commissioner of the General Land office, and recorded on pages .....of Register in the County Clerk's office.

Witness my hand this.....day of.....A. D. 1

.....SURVEYOR.

DESCRIPTION

OF SECTION, QUARTER SECTION AND QUARTER QUARTER SECTION CORNERS

H. C. MILLER CO., MFG. STATIONERS, MILWAUKEE X15000

GOVERNMENT CORNERS	Bearing Trees	In. Dia.	Courses they bear	Links Distant	Bearing Trees	In. Dia.	Courses they bear	Links Distant	Bearing Trees	In. Dia.	Courses they bear	Links Distant	Bearing Trees	In. Dia.	Courses they bear	Links Distant
No.																
1. N. W. Sec. Cor. indentified,																
2. N. E. Sec. Cor. indentified,																
3. S. E. Sec. Cor. indentified,																
4. W. ¼ Sec. Cor. indentified,																
5. E. ¼ Sec. Cor. indentified,																
6. S. ¼ Sec. Cor. indentified,																
7. W. ¼ Sec. Cor. indentified,																
8. Subdivision Corners																
No.																
1. Center ¼ Sec. Cor.																
2. North ¼-¼s N. W. qr.,																
3. East ¼-¼s N. W. qr.,																
4. South ¼-¼s N. W. qr.,																
5. West ¼-¼s N. W. qr.,																
6. Center ¼-¼s N. W. qr.,																
7. North ¼-¼s N. E. qr.,																
8. East ¼-¼s N. E. qr.,																
9. South ¼-¼s N. E. qr.,																
10. Center ¼-¼s N. E. qr.,																
11. East ¼-¼s S. E. qr.,																
12. South ¼-¼s S. E. qr.,																
13. West ¼-¼s S. E. qr.,																
14. Center ¼-¼s S. E. qr.,																
15. South ¼-¼s S. W. qr.,																
16. West ¼-¼s S. W. qr.,																
17. Center ¼-¼s S. W. qr.																

No 352 Wm Bay 1-1-16

At ⅛ post set corner of block 24.75 North and 24.75 West from this. West 6 lots - 66 by 132, 1 - 66 foot lot is 177.2 on East & 122.5 feet on West. This point is 148.2 on South and 195.3 on North, on East side 2 lots are 66 X 132, Then 1 - 66X66 Then Northeast corner lot is 175.8 on east, lots on North are 86.9.

Surveyed by Wm Child C3. April 15, 1915


Recorded by Lloyd S. Jensen C3. March 9, 1934

NAMES OF SWORN ASSISTANTS

CHAINMEN | FLAGMEN | AXMEN

No 353

Bay View Subdivision
Wm Bay.

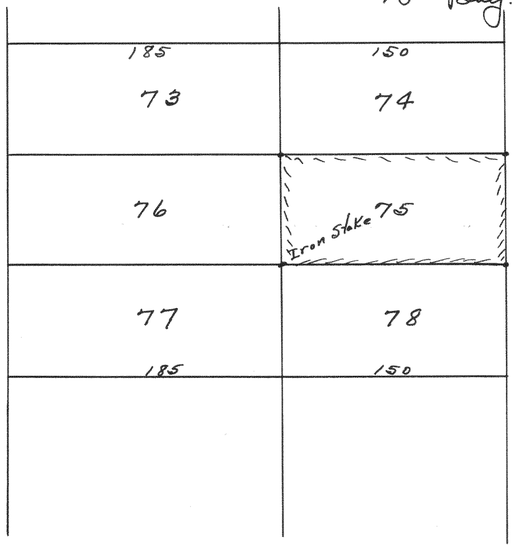


Plat of survey of Lot 75 of Bay View Sub. in The Village of Wm Bay.

Surveyed by Wm Child C.S.

Recorded by Floyd S Jensen C.S.
March 9, 1934

No 354

Original Town of
Williams Bay

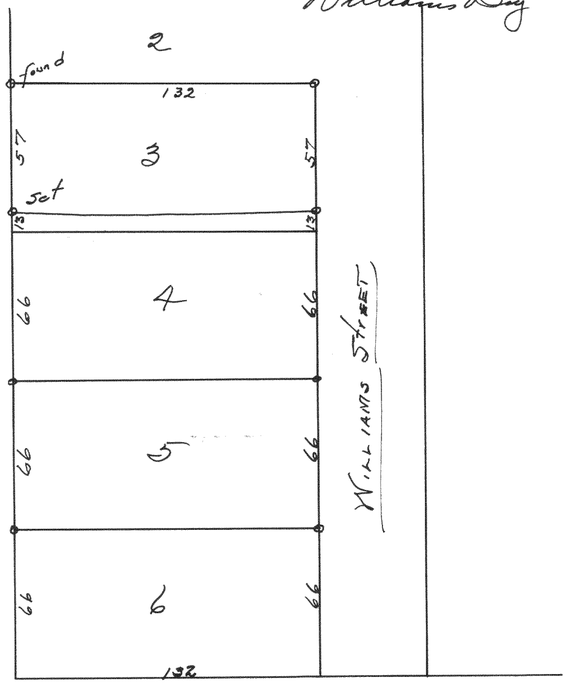

Plat of survey of part of The original Town of Williams Bay. for B. W. Stanton.

Surveyed by Wm Child C.S.

Recorded by Floyd S Jensen C.S.
March 9, 1934