Record of Survey.

No 356 (cont'd)

Township....., North of Range.....of 4 Principal Meridian as presented by the courses and distances on the following plat, and annexed field-notes of survey:

Established the center of the section at the point of intersection of STRAIGHT quarter lines.

Established all quarter-quarter corners upon the section boundary at proportional distances between known section and quarter section corners, according to the original field-notes of the Government survey.

Established all lost corners at proportionate distances between known corners, according to the original field-notes of the Government survey.

This is to certify that this plat represents the boundaries of some certain strips of land to be used for a road. The center line of which is described as follows to wit:

Beginning at a point on the N. line of the East ½ of the Southwest quarter of the SE ¼ of Section No. 1, T1N, R16E being the Town of Walworth, Walworth County, Wisconsin 25 feet west of the NE corner of the said E ½; Thence South parallel with and 25' W. of the east line of said East half 500 feet; Thence S 24° 45' W 150'; Thence S 65° W 100 feet; Thence S 47° 15' W 125 feet; Thence S 52° E 82.5 feet; Thence S 65° E 200 feet to a point 25 feet west of the above mentioned east line and 900 feet South of the place of beginning; Thence South parallel with and 25 feet west of the above mentioned East line 369 feet to a point due west of the Southwest corner of the land of W. J. Chalmers, as shown on this plat.

Williams Bay Feb. 3, 1916

Wm Child C.S.

Recorded by Lloyd V. Jensen C.S.

March 9, 1934

Plat of Section....., Township.....North, Range.....of 4 Principal Meridian Scale 80 chains to 6 inches. The figures in red ink are the lengths of the lines as stated in the field-notes of the Government survey.

Declination of the Magnetic Meridian from the True Meridian.....

Surveyed and sub-divided.....A. D. 1 , in accordance with the State Laws and Instructions of the Commissioner of the General Land office, and recorded on pages .....of Register in the County Clerk's office.

Witness my hand this.....day of.....A. D. 1

.....SURVEYOR.


DESCRIPTION

OF SECTION, QUARTER SECTION AND QUARTER QUARTER SECTION CORNERS

GOVERNMENT CORNERS	Bearing Trees	In. Dia.	Courses they bear	Links Distant	Bearing Trees	In. Dia.	Courses they bear	Links Distant	Bearing Trees	In. Dia.	Courses they bear	Links Distant	Bearing Trees	In. Dia.	Courses they bear	Links Distant
No.																
1. N. W. Sec. Cor. indentified,																
2. N. E. Sec. Cor. indentified,																
3. E. Sec. Cor. indentified,																
4. Sec. Cor. indentified,																
5. N. ¼ Sec. Cor. indentified,																
6. E. ¼ Sec. Cor. indentified,																
7. Sec. Cor. indentified,																
8. W. ¼ Sec. Cor. indentified,																
Subdivision Corners																
No.																
1. Center ¼ Sec. Cor.																
2. North ¼-¼s N. W. qr.,																
3. East ¼-¼s N. W. qr.,																
4. South ¼-¼s N. W. qr.,																
5. West ¼-¼s N. W. qr.,																
6. Center ¼-¼s N. W. qr.,																
7. North ¼-¼s N. E. qr.,																
8. East ¼-¼s N. E. qr.,																
9. South ¼-¼s N. E. qr.,																
10. Center ¼-¼s N. E. qr.,																
11. East ¼-¼s S. E. qr.,																
12. South ¼-¼s S. E. qr.,																
13. West ¼-¼s S. E. qr.,																
14. Center ¼-¼s S. E. qr.,																
15. South ¼-¼s S. W. qr.,																
16. West ¼-¼s S. W. qr.,																
17. Center ¼-¼s S. W. qr.																

N. C. MILLER CO., MFG. STATIONERS, MILWAUKEE X15000

No 357 Block 10 of Wm 2nd Add.

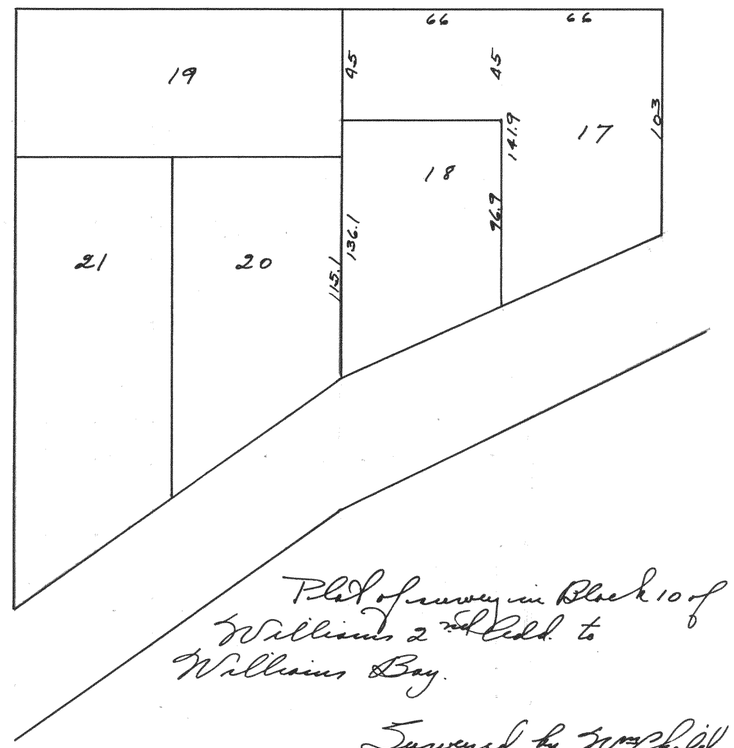

Plat of survey in Block 10 of Williams 2nd Add. to Williams Bay.

Surveyed by Wm Child C.S.

Recorded by Lloyd V. Jensen C.S.


March 9, 1934

NAMES OF SWORN ASSISTANTS

CHAINMEN	FLAGMEN	AXMEN

No 358

WILLIAMS BAY

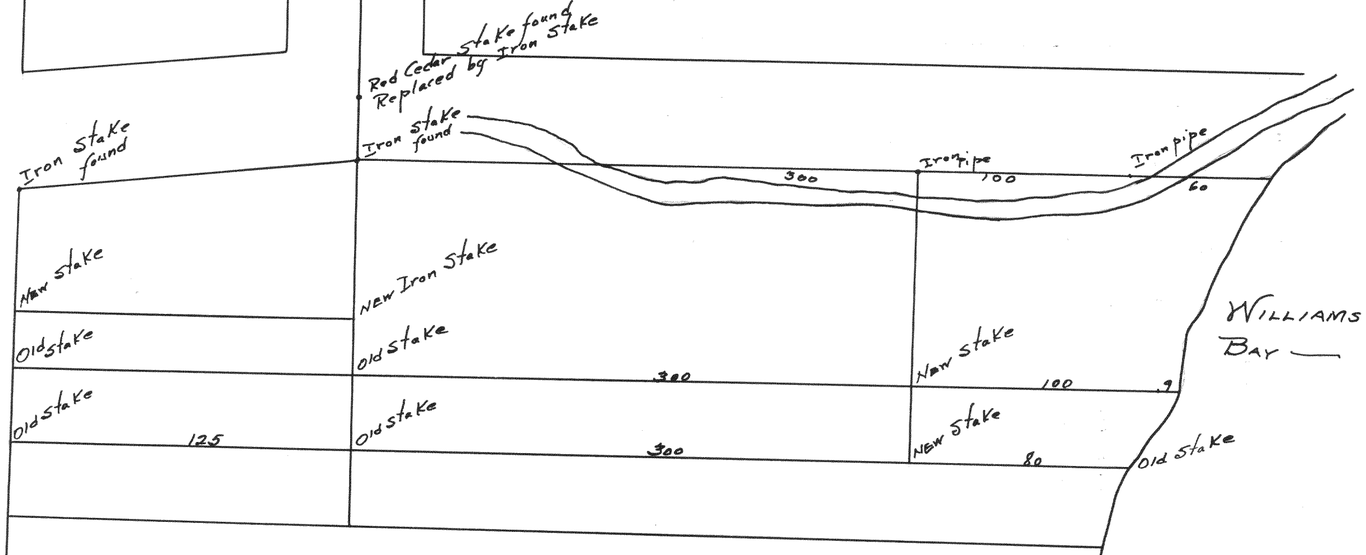

Plat of survey of lots in Wms Bay, original town.

Surveyed by Wm Child C.S.

Recorded by Lloyd S. Jensen C.S.
March 9, 1934