No 364

Record of Survey.


WALWORTH VILLAGE

Township....., North of Range.....of 4 Principal Meridian as presented by the courses and distances on the following plat, and annexed field-notes of survey:

Established the center of the section at the point of intersection of STRAIGHT quarter lines.

Established all quarter-quarter corners upon the section boundary at proportional distances between known section and quarter section corners, according to the original field-notes of the Government survey.

Established all lost corners at proportionate distances between known corners, according to the original field notes of the Government survey.

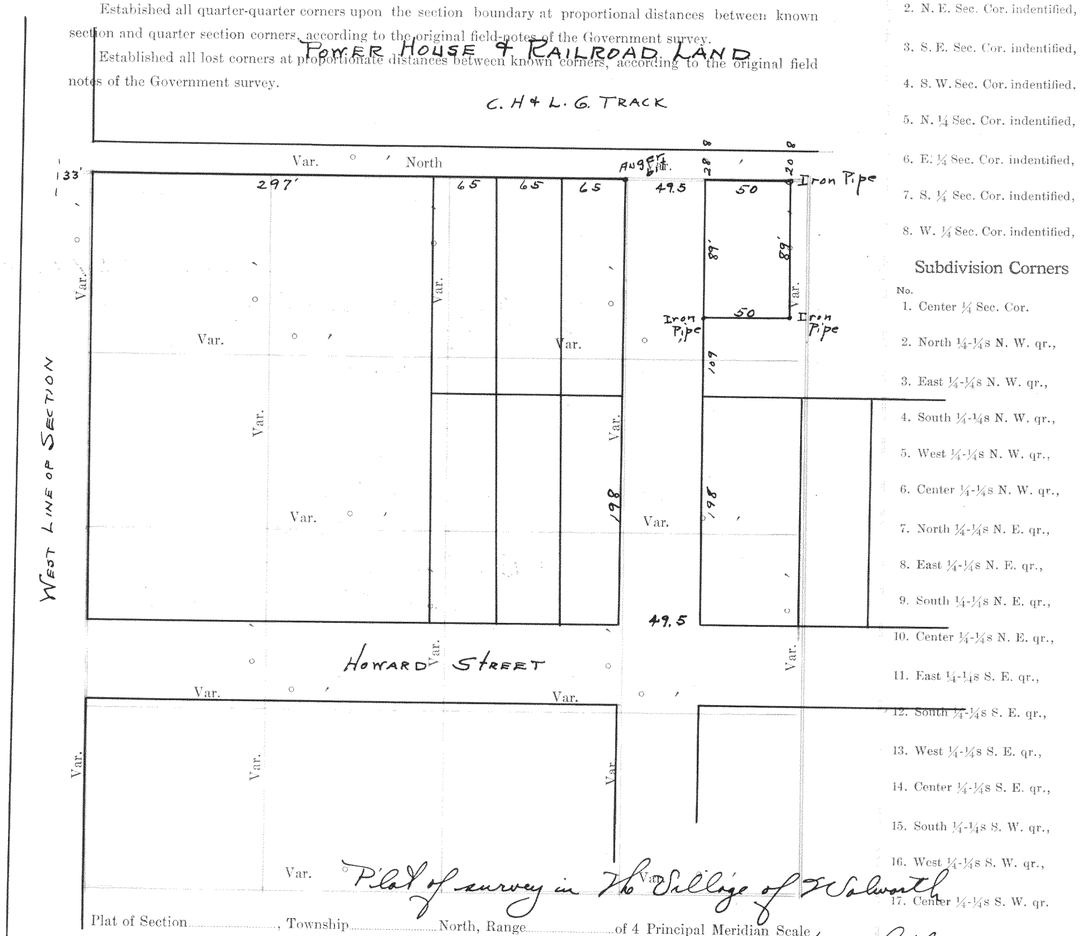

Plat of Section....., Township.....North, Range.....of 4 Principal Meridian Scale 80 chains to 6 inches. The figures in red ink are the lengths of the lines as stated in the field-notes of the Government survey.

Plat of survey in The Village of Walworth
Surveyed by Wm Child CS
Recorded by Floyd S. Jensen CS
March 10, 1934

Declination of the Magnetic Meridian from the True Meridian.....

Surveyed and sub-divided.....A. D. 1 , in accordance with the State Laws and Instructions of the Commissioner of the General Land office, and recorded on pages .....of Register in the County Clerk's office.

CHAINMEN

Witness my hand this.....day of.....A. D. 1

.....SURVEYOR.

DESCRIPTION

120


OF SECTION, QUARTER SECTION AND QUARTER QUARTER SECTION CORNERS

M. C. MILLER CO., MFG. STATIONERS, MILWAUKEE X15000

GOVERNMENT CORNERS	Bearing Trees	In. Dia.	Courses they bear	Links Distant	Bearing Trees	In. Dia.	Courses they bear	Links Distant	Bearing Trees	In. Dia.	Courses they bear	Links Distant	Bearing Trees	In. Dia.	Courses they bear	Links Distant
No.																
1. N. W. Sec. Cor. indentified,																
2. N. E. Sec. Cor. indentified,																
3. S. E. Sec. Cor. indentified,																
4. S. W. Sec. Cor. indentified,																
5. N. ¼ Sec. Cor. indentified,																
6. E. ¼ Sec. Cor. indentified,																
7. S. ¼ Sec. Cor. indentified,																
8. W. ¼ Sec. Cor. indentified,																
Subdivision Corners																
No.																
1. Center ¼ Sec. Cor.																
2. North ¼-¼s N. W. qr.,																
3. East ¼-¼s N. W. qr.,																
4. South ¼-¼s N. W. qr.,																
5. West ¼-¼s N. W. qr.,																
6. Center ¼-¼s N. W. qr.,																
7. North ¼-¼s N. E. qr.,																
8. East ¼-¼s N. E. qr.,																
9. South ¼-¼s N. E. qr.,																
10. Center ¼-¼s N. E. qr.,																
11. East ¼-¼s S. E. qr.,																
12. South ¼-¼s S. E. qr.,																
13. West ¼-¼s S. E. qr.,																
14. Center ¼-¼s S. E. qr.,																
15. South ¼-¼s S. W. qr.,																
16. West ¼-¼s S. W. qr.,																
17. Center ¼-¼s S. W. qr.																

No 365

WALWORTH VILLAGE

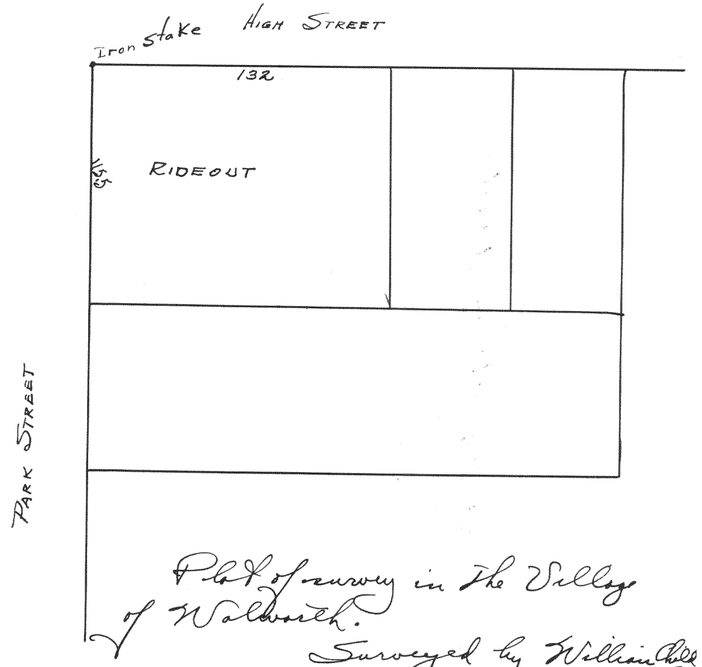


Plat of survey in The Village of Walworth.
Surveyed by William Child CS
Recorded by Floyd S. Jensen CS
March 10, 1934

NAMES OF SWORN ASSISTANTS

FLAGMEN	AXMEN

No 366

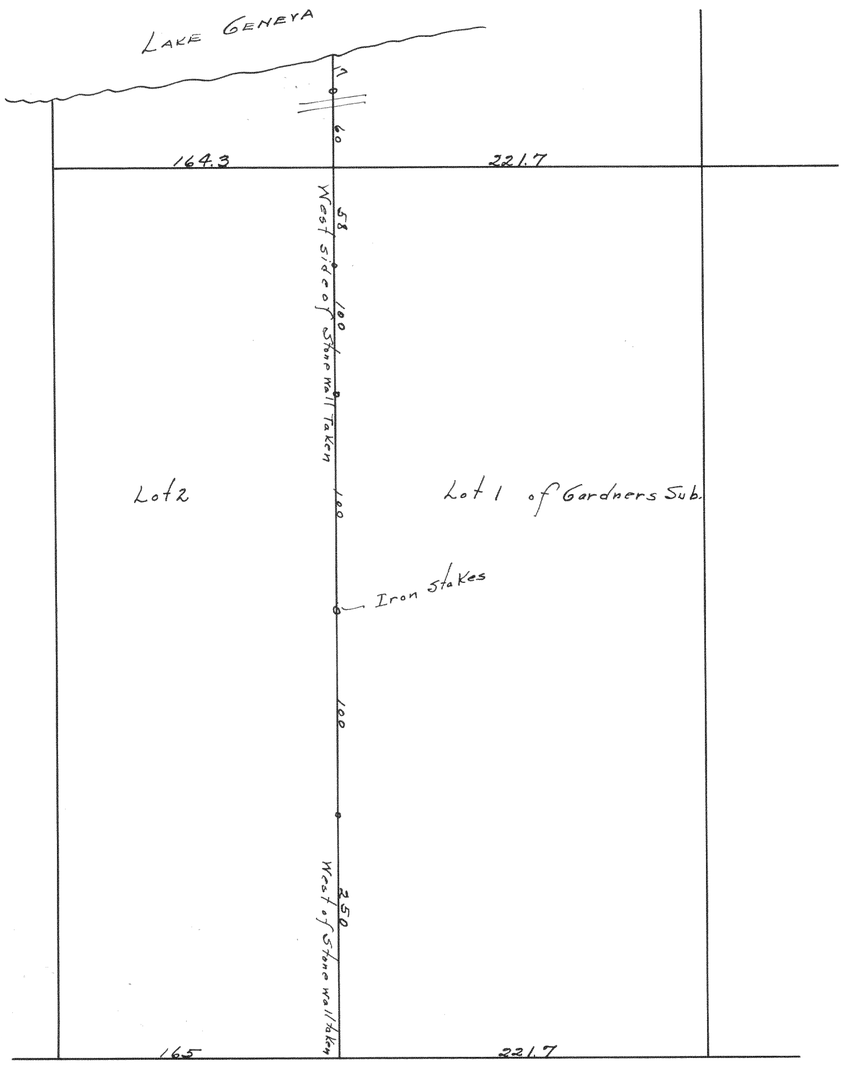

Plat of survey in Gardners Subd. located in Section 13, T1N, R16E.

Surveyed by Wm Child C.S.

Recorded by Lloyd S Jensen C.S.
March 10, 1934

No 367

11-2-16

Fontana
for Albert Colesworth

Found stone monument at 1/8 post on South of Southwest quarter and 9.20 chains = 607.2 feet North being Northeast of piece on this line, 200 North of Southeast corner set iron pipe for Northeast of piece surveyed. West from 1/8 post 206 feet find iron stake for corner of lot South and on this line at 150 feet drive stake for Southwest of piece, drive iron pipe 150 feet west and 200 North for Northwest corner of piece.

Surveyed by Wm Child C.S.
Oct 3, 1914

Recorded by Lloyd S Jensen C.S.
March 10, 1934