# Record of Survey.


No 374

Township....., North of Range.....of 4 Principal Meridian as presented by the courses and distances on the following plat, and annexed field-notes of survey:

Established the center of the section at the point of intersection of STRAIGHT quarter lines.

Established all quarter-quarter corners upon the section boundary at proportional distances between known section and quarter section corners, according to the original field-notes of the Government survey.

Established all lost corners at proportionate distances between known corners, according to the original field notes of the Government survey.

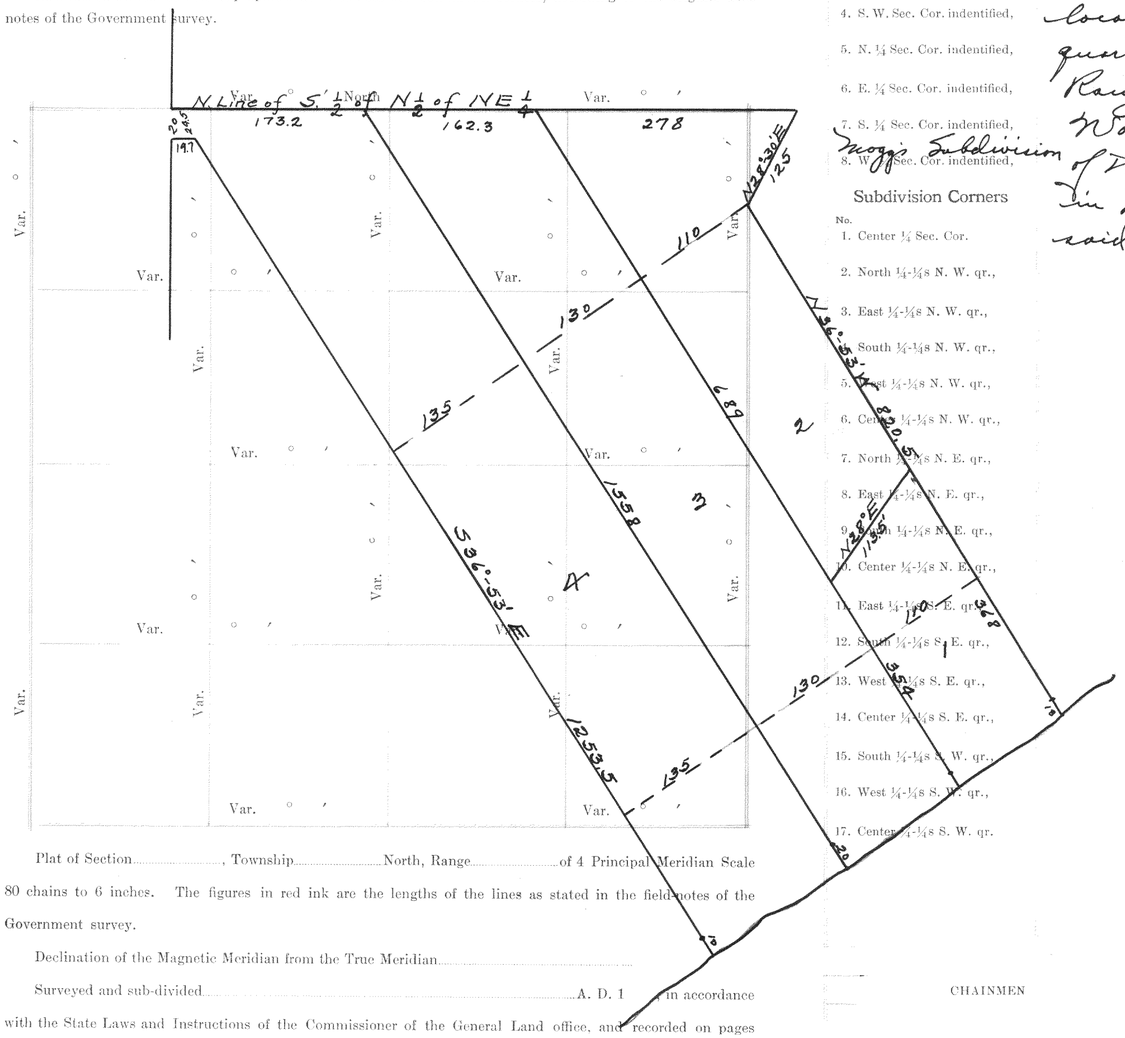


Plat of Section....., Township.....North, Range.....of 4 Principal Meridian Scale 80 chains to 6 inches. The figures in red ink are the lengths of the lines as stated in the field-notes of the Government survey.

Declination of the Magnetic Meridian from the True Meridian.....

Surveyed and sub-divided.....A. D. 1 , in accordance with the State Laws and Instructions of the Commissioner of the General Land office, and recorded on pages .....of Register in the County Clerk's office.

**Witness** my hand this.....day of.....A. D. 1

.....SURVEYOR.

# DESCRIPTION

## OF SECTION, QUARTER SECTION AND QUARTER QUARTER SECTION CORNERS

N. C. MILLER CO. MFG. STATIONERS, MILWAUKEE X15000

| GOVERNMENT CORNERS | Bearing Trees | In. Dia. | Courses they bear | Links Distant | Bearing Trees | In. Dia. | Courses they bear | Links Distant | Bearing Trees | In. Dia. | Courses they bear | Links Distant | Bearing Trees | In. Dia. | Courses they bear | Links Distant |
|---|---|---|---|---|---|---|---|---|---|---|---|---|---|---|---|---|
| No. | | | | | | | | | | | | | | | | |
| 1. N. W. Sec. Cor. indentified, | | | | | | | | | | | | | | | | |
| 2. N. E. Sec. Cor. indentified, | | | | | | | | | | | | | | | | |
| 3. S. E. Sec. Cor. indentified, | | | | | | | | | | | | | | | | |
| 4. S. W. Sec. Cor. indentified, | | | | | | | | | | | | | | | | |
| 5. N. ¼ Sec. Cor. indentified, | | | | | | | | | | | | | | | | |
| 6. E. ¼ Sec. Cor. indentified, | | | | | | | | | | | | | | | | |
| 7. S. ¼ Sec. Cor. indentified, | | | | | | | | | | | | | | | | |
| 8. W. Sec. Cor. indentified, | | | | | | | | | | | | | | | | |
| **Subdivision Corners** | | | | | | | | | | | | | | | | |
| No. | | | | | | | | | | | | | | | | |
| 1. Center ¼ Sec. Cor. | | | | | | | | | | | | | | | | |
| 2. North ¼-¼s N. W. qr., | | | | | | | | | | | | | | | | |
| 3. East ¼-¼s N. W. qr., | | | | | | | | | | | | | | | | |
| 4. South ¼-¼s N. W. qr., | | | | | | | | | | | | | | | | |
| 5. West ¼-¼s N. W. qr., | | | | | | | | | | | | | | | | |
| 6. Center ¼-¼s N. W. qr., | | | | | | | | | | | | | | | | |
| 7. North ¼-¼s N. E. qr., | | | | | | | | | | | | | | | | |
| 8. East ¼-¼s N. E. qr., | | | | | | | | | | | | | | | | |
| 9. South ¼-¼s N. E. qr., | | | | | | | | | | | | | | | | |
| 10. Center ¼-¼s N. E. qr., | | | | | | | | | | | | | | | | |
| 11. East ¼-¼s S. E. qr., | | | | | | | | | | | | | | | | |
| 12. South ¼-¼s S. E. qr., | | | | | | | | | | | | | | | | |
| 13. West ¼-¼s S. E. qr., | | | | | | | | | | | | | | | | |
| 14. Center ¼-¼s S. E. qr., | | | | | | | | | | | | | | | | |
| 15. South ¼-¼s S. W. qr., | | | | | | | | | | | | | | | | |
| 16. West ¼-¼s S. W. qr., | | | | | | | | | | | | | | | | |
| 17. Center ¼-¼s S. W. qr. | | | | | | | | | | | | | | | | |

Moggs Subdivision

A copy of the plat of Moggs Subdivision located in the East half of the Southeast quarter of section No. 11, Township 1 North, Range 16 East, being the Town of Walworth, Walworth County, Wisconsin. The plat of the said subdivision being on record in the register of deeds office in and for the said county in Vol. 5 of plats on page 214.

Elkhorn. Oct. 25, 1927


W. Child C.S.

Recorded by Lloyd S. Jensen C.S.
March 14, 1934

## NAMES OF SWORN ASSISTANTS

| CHAINMEN | FLAGMEN | AXMEN |
|---|---|---|
| | | |

No 375

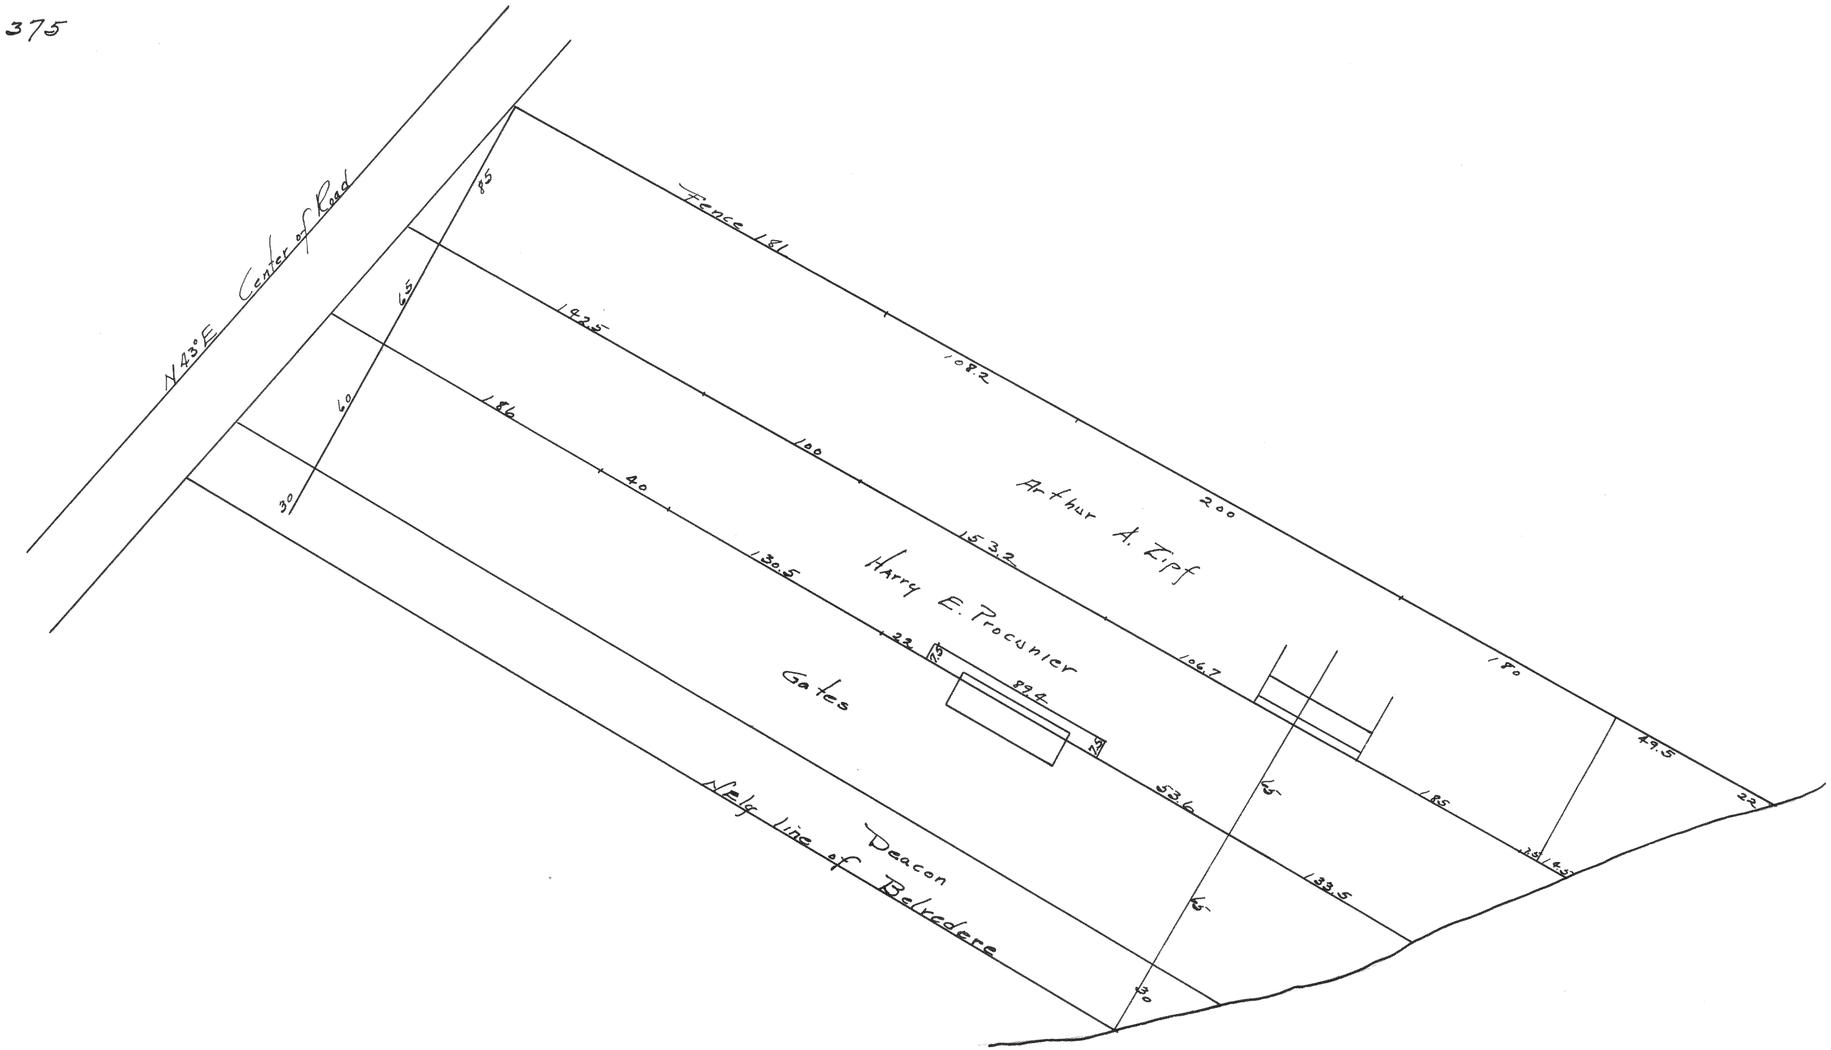


Survey of unplatted lots in Section 11-1-16.
Surveyed by Wm Child C.S.

Recorded by Floyd S. Jensen C.S.
March 14, 1884