No 376

Record of Survey.


FONTANA

Township....., North of Range.....of 4 Principal Meridian as presented by the courses and distances on the following plat, and annexed field-notes of survey:

Established the center of the section at the point of intersection of STRAIGHT quarter lines.


Established all quarter-quarter corners upon the section boundary at proportional distances between known section and quarter section corners, according to the original field-notes of the Government survey.

Established all lost corners at proportionate distances between known corners, according to the original field notes of the Government survey.

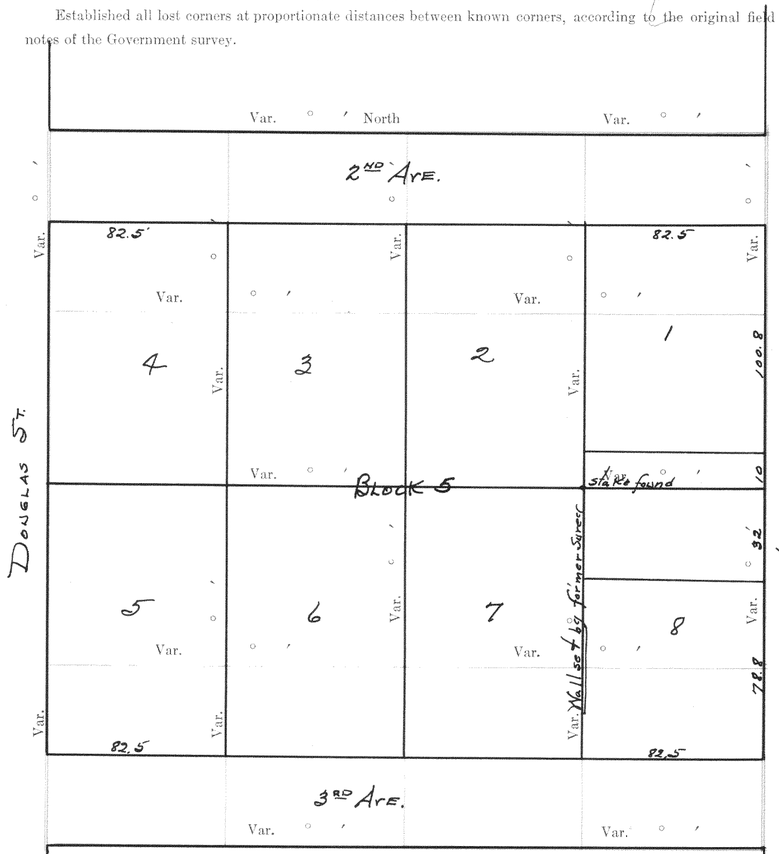
Var. ° ′ North
Var. ° ′
2ND AVE.
82.5
Var.
82.5
Var.
Var.
Var.
Var.
4
3
2
1
100.8
Var.
Var.
Var.
Var.

125

No 378

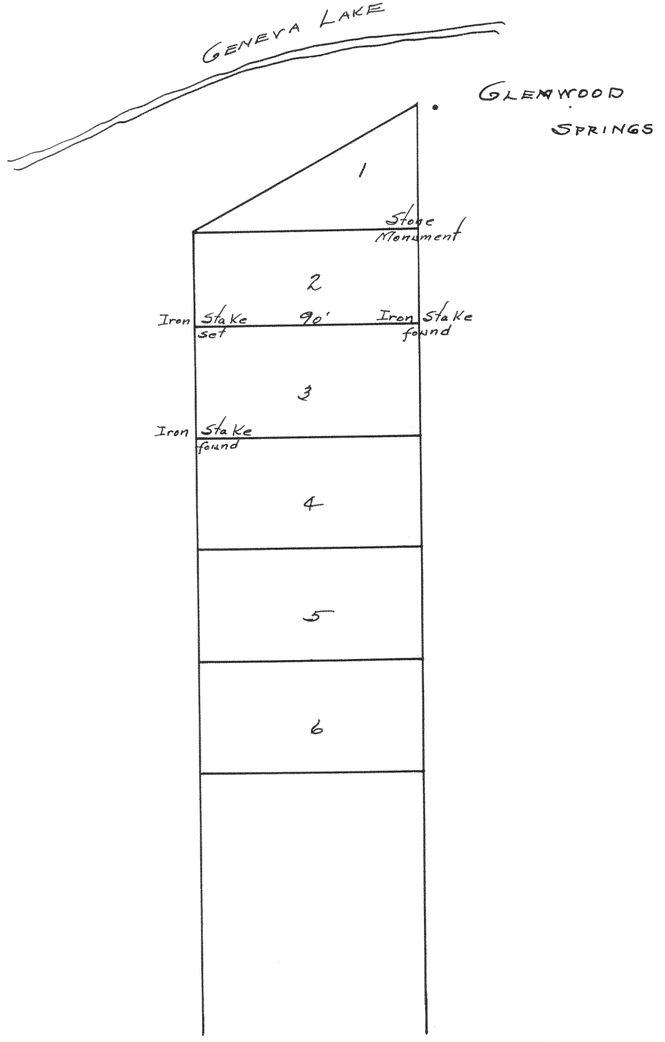


Plat of a survey made for O. C. Turner of Chicago to relocate the corners of Lots in Block No 1 of the Plat of Glenwood Springs located on Geneva Lake

Surveyed by Wm Child C.S.

Recorded by Lloyd S. Jensen C.S.
March 14, 1934

No 379

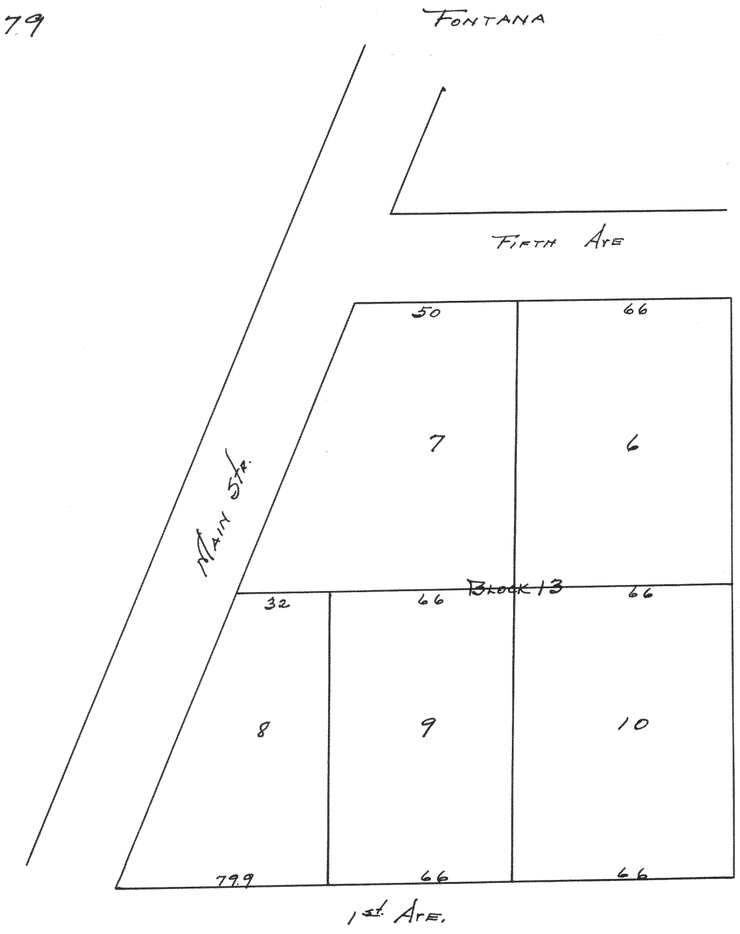

Plat of a survey in Blk. 13 of the Village of Fontana, Walworth Co. Wisconsin.

Surveyed by Wm Child C.S.

Recorded by Lloyd S. Jensen C.S.
March 14, 1934