No 385

# Record of Survey.

Township ..., North of Range 36-4-16 & 1-3-17 of 4 Principal Meridian as presented by the courses and distances on the following plat, and annexed field-notes of survey:

Established the center of the section at the point of intersection of STRAIGHT quarter lines.

Established all quarter-quarter corners upon the section boundary at proportional distances between known section and quarter section corners, according to the original field-notes of the Government survey.

Established all lost corners at proportionate distances between known corners, according to the original field notes of the Government survey. This is to certify

That I did on the 27th. day of February 1912 make measurements on the Southwest quarter of the northwest quarter of Section No. 36, in the Town of Troy, Walworth County, Wisconsin, and also on the north half of the northwest quarter of Section No 1 in the Town of La Fayette, in said County and State, and a strip off from the North side of the southwest quarter of said Northwest quarter sufficient to ascertain the area of said pieces, and find the same to contain 123.6 acres.

Dated Elkhorn, Wisconsin
Feb. 28, 1912
Wm Child CS.

Recorded by Lloyd S. Jensen CS.
March 15, 1934

Var. Var. Var. Var. Var. Var. Var. Var. Var.

Plat of Section ..., Township ... North, Range ... of 4 Principal Meridian Scale 80 chains to 6 inches. The figures in red ink are the lengths of the lines as stated in the field-notes of the Government survey.

Declination of the Magnetic Meridian from the True Meridian ...

Surveyed and sub-divided ... A. D. 1 , in accordance with the State Laws and Instructions of the Commissioner of the General Land office, and recorded on pages ... of Register in the County Clerk's office.

**Witness** my hand this ... day of ... A. D. 1

... SURVEYOR.


# DESCRIPTION

## OF SECTION, QUARTER SECTION AND QUARTER QUARTER SECTION CORNERS

H. C. MILLER CO. MFG. STATIONERS, MILWAUKEE X15000

| GOVERNMENT CORNERS | Bearing Trees | In. Dia. | Courses they bear | Links Distant | Bearing Trees | In. Dia. | Courses they bear | Links Distant | Bearing Trees | In. Dia. | Courses they bear | Links Distant | Bearing Trees | In. Dia. | Courses they bear | Links Distant |
|---|---|---|---|---|---|---|---|---|---|---|---|---|---|---|---|---|
| No. | | | | | | | | | | | | | | | | |
| 1. N. W. Sec. Cor. indentified, | No 386 | | | | | | | | | | | | | | | |
| 2. N. E. Sec. Cor. indentified, | | | | | | | | | | | | | | | | |
| 3. S. E. Sec. Cor. indentified, | | | | | | | | | | | | | | | | |
| 4. S. W. Sec. Cor. indentified, | | | | | | | | | | | | | | | | |
| 5. N. ¼ Sec. Cor. indentified, | | | | | | | | | | | | | | | | |
| 6. E. ¼ Sec. Cor. indentified, | | | | | | | | | | | | | | | | |
| 7. S. ¼ Sec. Cor. indentified, | | | | | | | | | | | | | | | | |
| 8. W. ¼ Sec. Cor. indentified, | | | | | | | | | | | | | | | | |
| **Subdivision Corners** | | | | | | | | | | | | | | | | |
| No. | | | | | | | | | | | | | | | | |
| 1. Center ¼ Sec. Cor. | | | | | | | | | | | | | | | | |
| 2. North ¼-¼s N. W. qr., | | | | | | | | | | | | | | | | |
| 3. East ¼-¼s N. W. qr., | | | | | | | | | | | | | | | | |
| 4. South ¼-¼s N. W. qr., | | | | | | | | | | | | | | | | |
| 5. West ¼-¼s N. W. qr., | | | | | | | | | | | | | | | | |
| 6. Center ¼-¼s N. W. qr., | | | | | | | | | | | | | | | | |
| 7. North ¼-¼s N. E. qr., | | | | | | | | | | | | | | | | |
| 8. East ¼-¼s N. E. qr., | | | | | | | | | | | | | | | | |
| 9. South ¼-¼s N. E. qr., | | | | | | | | | | | | | | | | |
| 10. Center ¼-¼s N. E. qr., | | | | | | | | | | | | | | | | |
| 11. East ¼-¼s S. E. qr., | | | | | | | | | | | | | | | | |
| 12. South ¼-¼s S. E. qr., | | | | | | | | | | | | | | | | |
| 13. West ¼-¼s S. E. qr., | | | | | | | | | | | | | | | | |
| 14. Center ¼-¼s S. E. qr., | | | | | | | | | | | | | | | | |
| 15. South ¼-¼s S. W. qr., | | | | | | | | | | | | | | | | |
| 16. West ¼-¼s S. W. qr., | | | | | | | | | | | | | | | | |
| 17. Center ¼-¼s S. W. qr. | | | | | | | | | | | | | | | | |

24-4-16

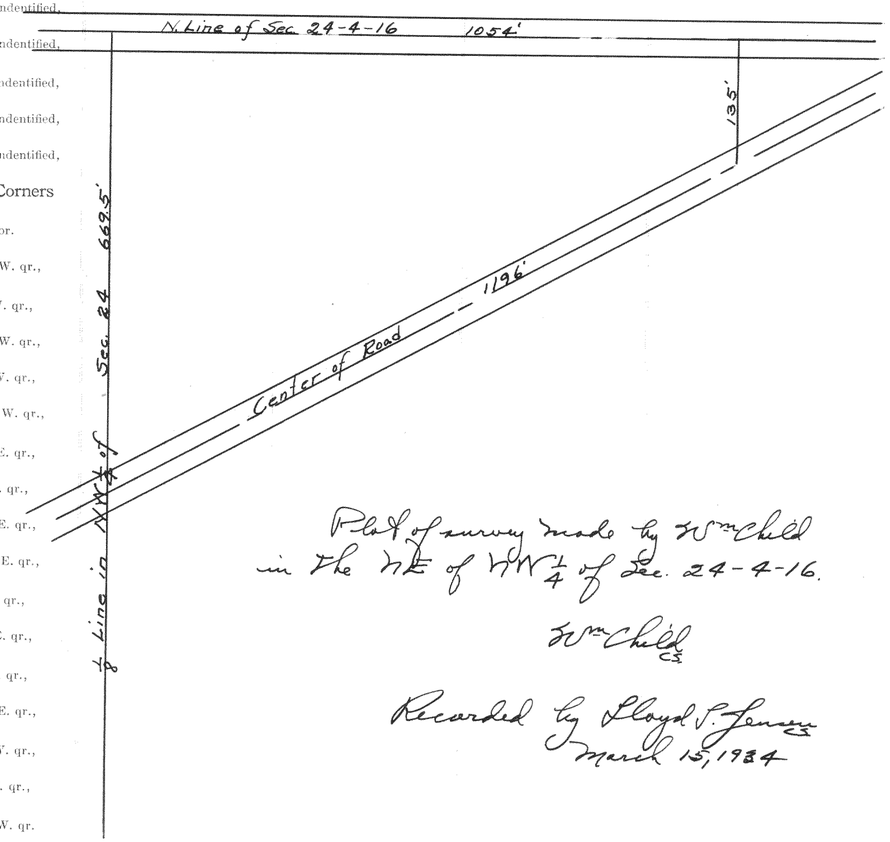


Plat of survey made by Wm Child in the NE of NW¼ of Sec. 24-4-16.

Wm Child CS.


Recorded by Lloyd S. Jensen CS.
March 15, 1934

## NAMES OF SWORN ASSISTANTS

| CHAINMEN | FLAGMEN | AXMEN |
|---|---|---|
| | | |

No 387

32 - 4 - 16

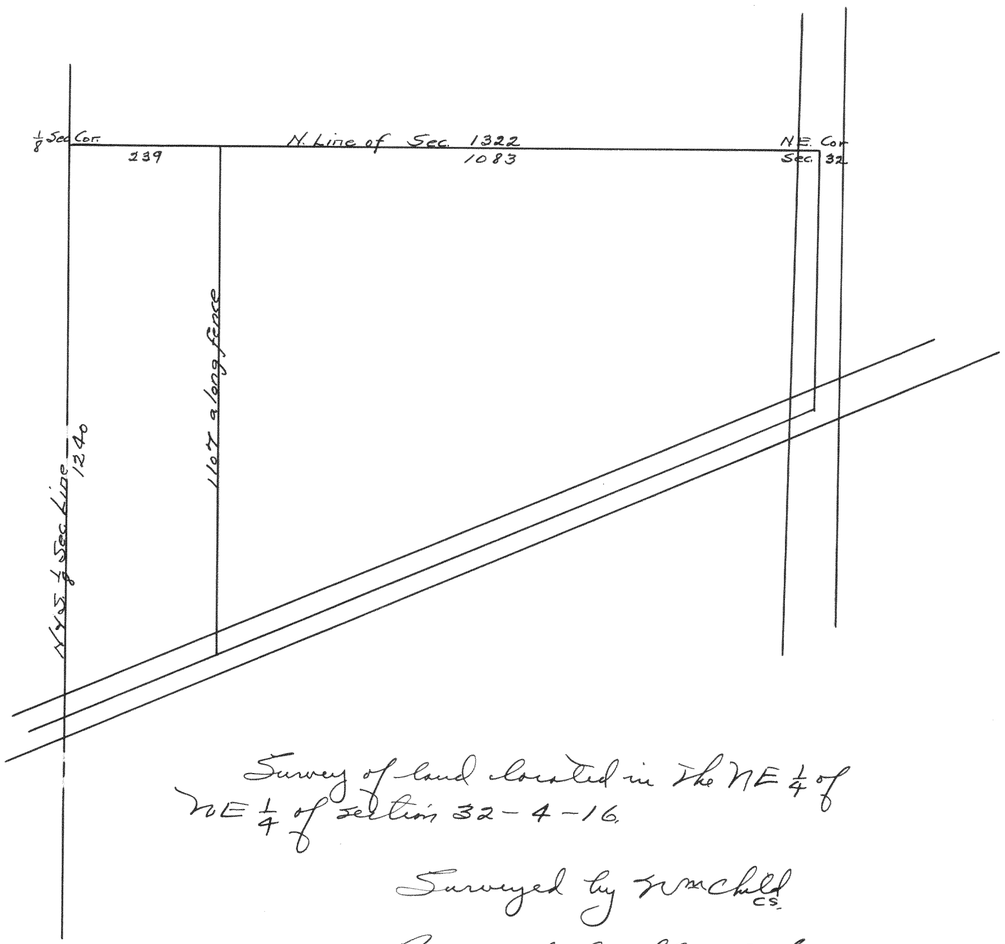



Survey of land located in the NE 1/4 of NE 1/4 of Section 32 - 4 - 16.

Surveyed by Wm Child C.S.

Recorded by Lloyd S. Jensen C.S.
March 15, 1934

No 388

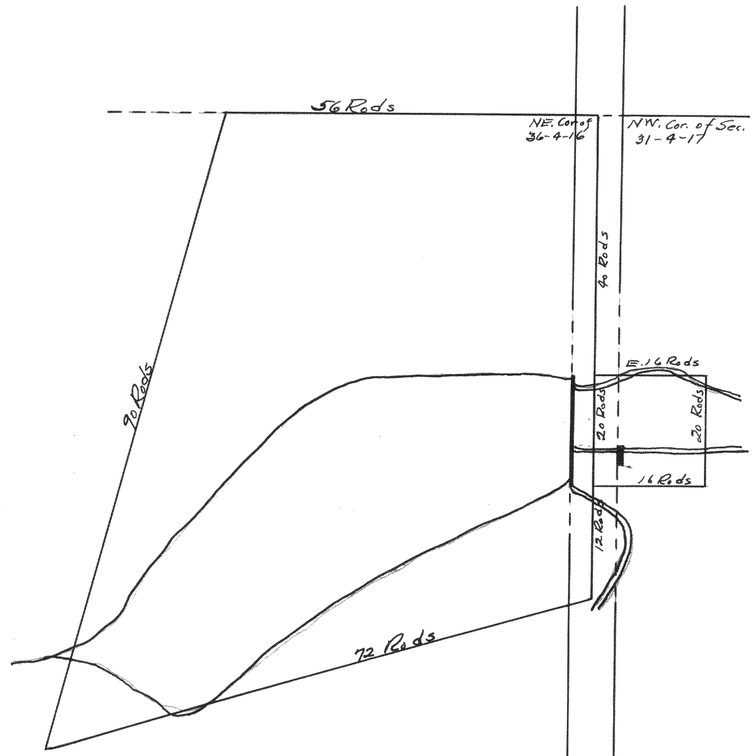


Survey of land in Sec. 36 - 4 - 16 and Sec. 31 - 4 - 17.

Surveyed by Wm Child C.S.

Recorded by Lloyd S. Jensen C.S.
March 15, 1934