Record of Survey.

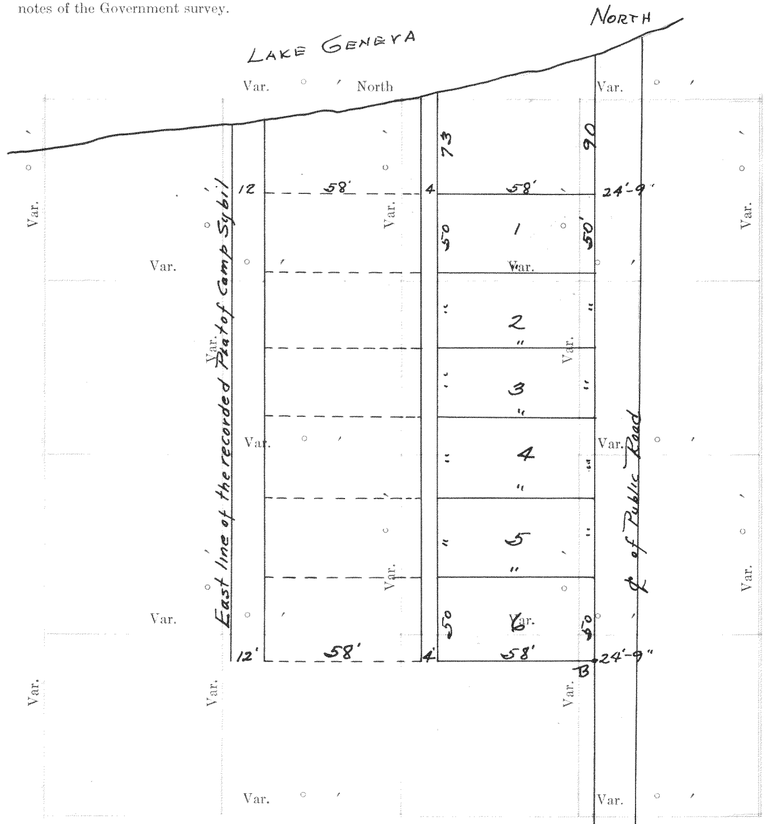
Township....., North of Range.....of 4 Principal Meridian as presented by the courses and distances on the following plat, and annexed field-notes of survey:

Established the center of the section at the point of intersection of STRAIGHT quarter lines.

Estabished all quarter-quarter corners upon the section boundary at proportional distances between known section and quarter section corners, according to the original field-notes of the Government survey.

Established all lost corners at proportionate distances between known corners, according to the original field notes of the Government survey.

No. 30


NORTH
LAKE GENEVA
Var.
North
Var.
Var.
Var.

No 31 Plat of a survey made by the direction of Ralph H. Leach for the purpose of ascertaining the number of square yards of surface in one certain marsh or slew located in the West half of section No 17, Town 4 North, Range 18 East being the Town of East Troy, Walworth County, Wisconsin. And lying in front of Lots 25 to 64 inclusive of the Plat of Wilmer Grove Beach which plat is on record in the Register of Deeds office in and for the said County in Volume 8 of Plats on Page 92. In figuring yards a strip .7. feet in width along the entire front of the said lots being 1004 feet in length is to be taken out as hard land. The lines on Plat marked "A" are lines that were measured. Scale of Plat 50 = 1" (on original not this drawing)

Elkhorn July 14th 1927

Wm Child
County Surveyor

Recorded ~~by~~ Feb. 23, 1933 by
Lloyd S. Jensen
County Surveyor.

