Record of Survey.


No 415

Township....., North of Range.....of 4 Principal Meridian as presented by the courses and distances on the following plat, and annexed field-notes of survey.


Established the center of the section at the point of intersection of STRAIGHT quarter lines.

Established all quarter-quarter corners upon the section boundary at proportional distances between known section and quarter section corners, according to the original field-notes of the Government survey.

Established all lost corners at proportionate distances between known corners, according to the original field notes of the Government survey.

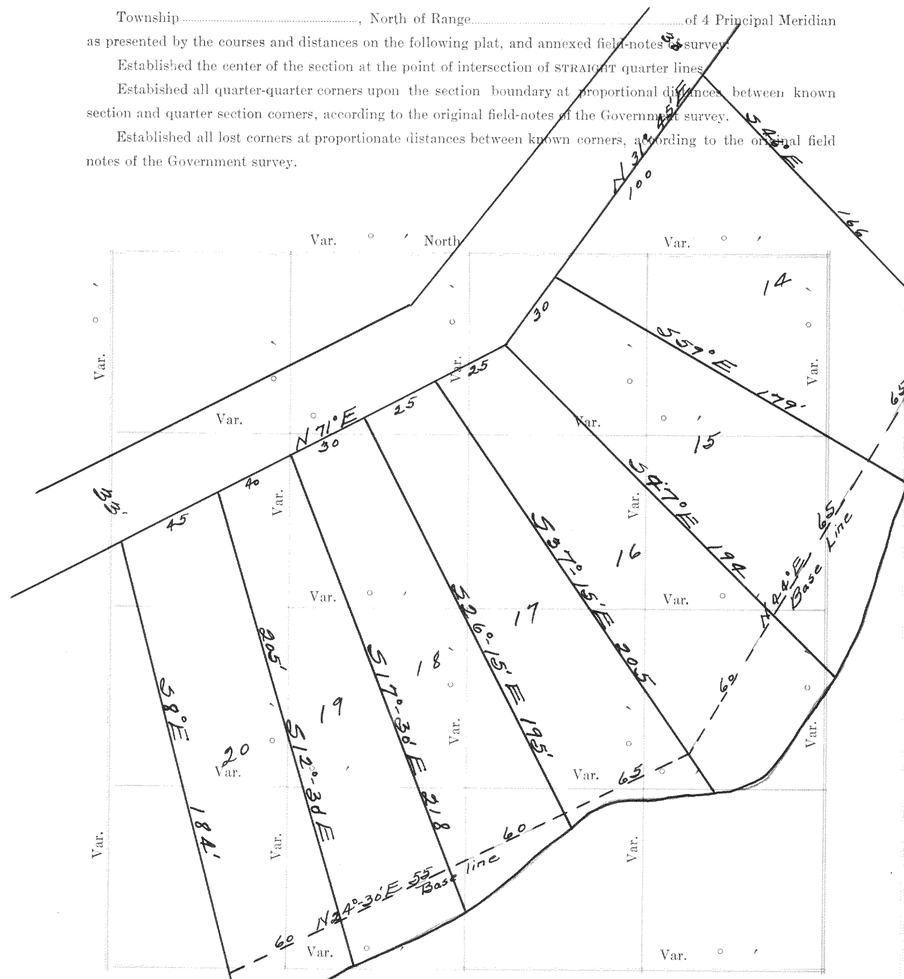
Var.
North
Var.
Var.
Var.

No. 416

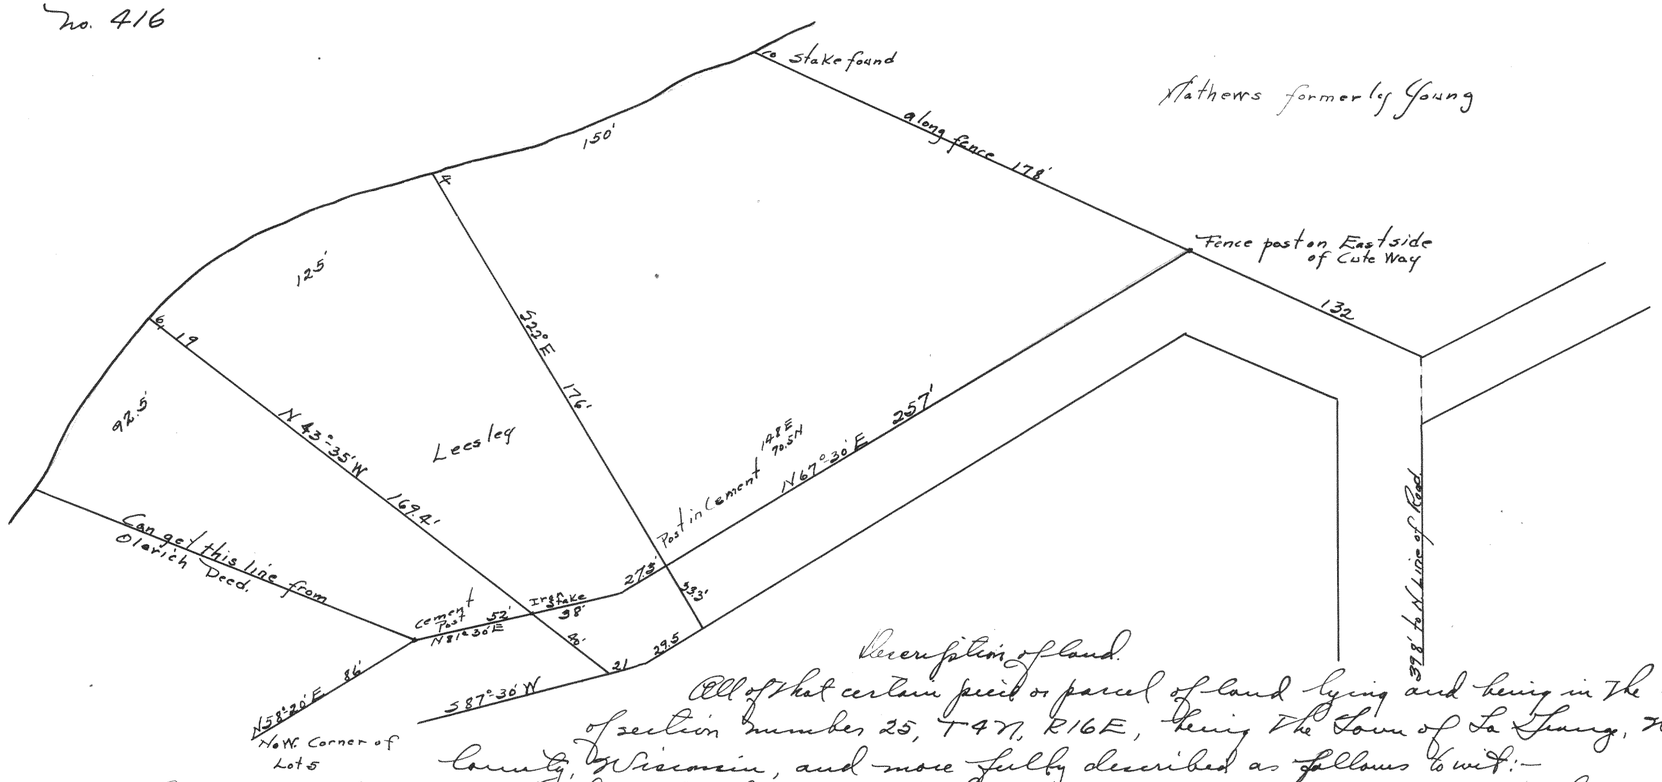

Description of land.

All of that certain piece or parcel of land lying and being in the S.W. quarter of section number 25, T 4 N, R 16 E, being the Town of La Grange, Walworth County, Wisconsin, and more fully described as follows to wit:—

Beginning at an iron stake and which iron stake may be found as follows; from the northwesterly corner of lot No. 5 of the plat of Shoreacres Park (which plat is recorded in the Register of Deeds office in and for said Walworth Co., in Vol. 5 of plats on page 145) N 58°-20' E 86 feet to a cement monument; and N 81°-30' E 52' to the said iron stake the place of beginning; Thence N 43°-35' W 184.4 feet to an iron stake and producing and extending said line of N 43°-35' W 6' more ± to the shore of Middle Lake at low water mark; Thence starting in a northeasterly direction and following the shore of said lake at low water line 150 feet more or less to a point; Thence S 22° E 4 feet more or less to an iron stake, and which iron stake is N 43°-35' W 169.4' & N 62°-00' E 125 feet from the place of beginning, and continuing on said line of S 22° E 176 feet more to a fence post set in cement; Thence S 61° W 27.3 feet to an iron stake; Thence S 81°-30' W 38 feet ± to the place of beginning.

Surveyed by W. McCold C3

Recorded by Lloyd V. Jones C3

March 19, 1934