Record of Survey.


No 422 23-2-16

Township....., North of Range.....of 4 Principal Meridian as presented by the courses and distances on the following plat, and annexed field-notes of survey:

Established the center of the section at the point of intersection of STRAIGHT quarter lines.


Established all quarter-quarter corners upon the section boundary at proportional distances between known section and quarter section corners, according to the original field-notes of the Government survey.

Established all lost corners at proportionate distances between known corners, according to the original field notes of the Government survey.

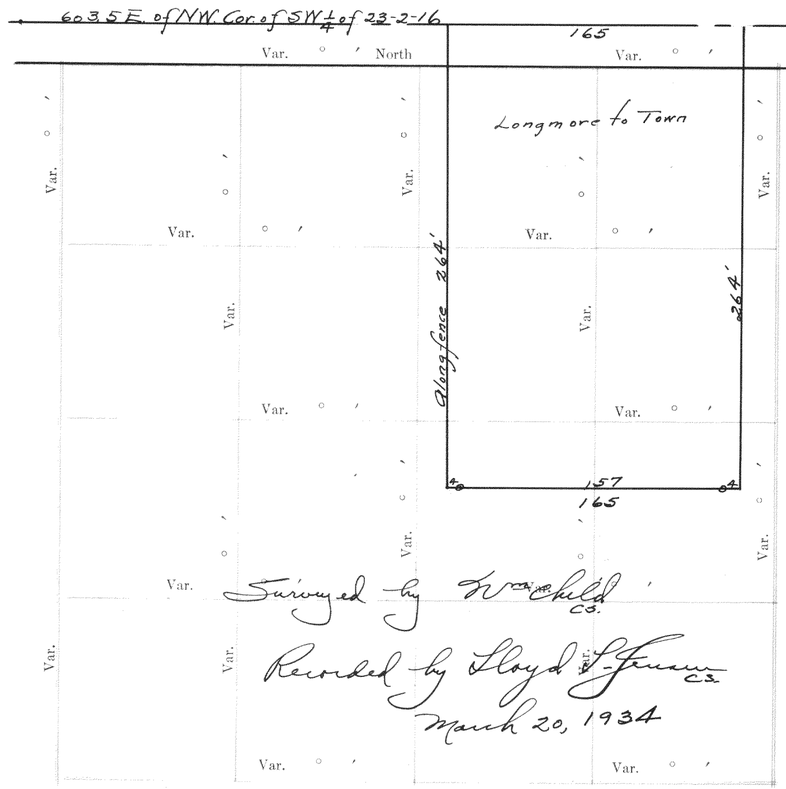
60.3 E. of NW Cor. of SW¼ of 23-2-16
Var. ° ' North
165
Var. ° '
Longmore to Town
Var.
Var.
Var.

No 424

3-2-16

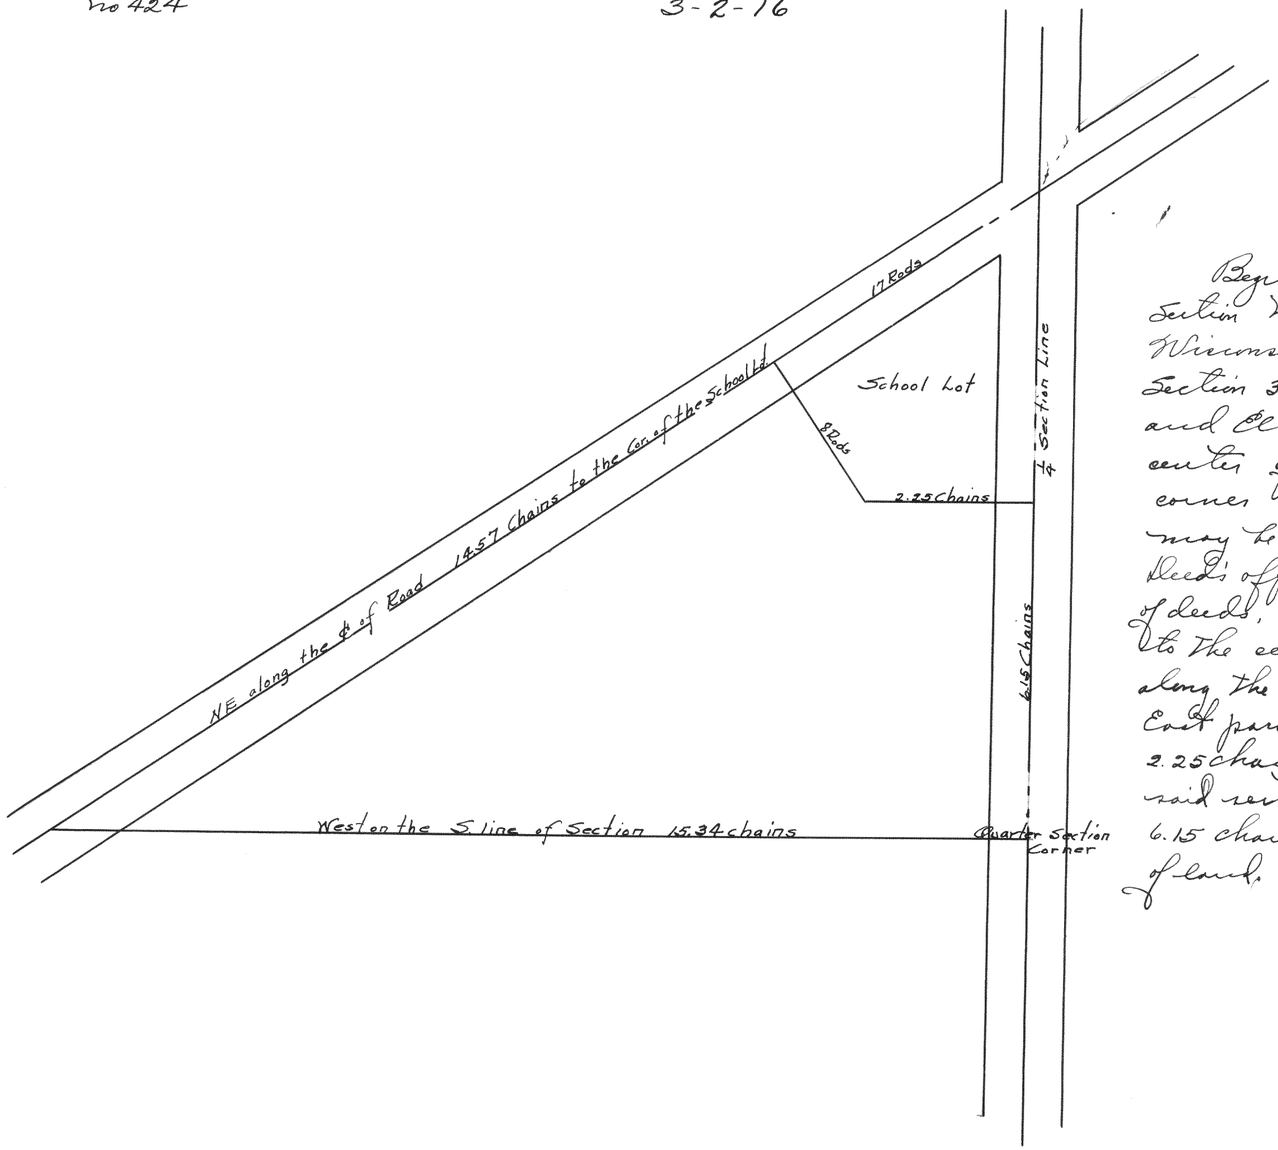

Description

Beginning at the ¼ section corner on the S. line of Section No. 3, in the Town of Delavan, Walworth County, Wisconsin; Thence West along the South line of said Section 3 15.34 chains to the center of the Delavan and Elkhorn Road, Thence southeasterly along the center of said road 14.57 chains to the northwesterly corner of the school lot (a description of which lot may be found in a deed recorded in the Register of Deed's office in and for Walworth County, in Vol. 115 of deeds, on page 392) Thence Southeasterly at right angles to the center line of said road 2 chains (equalling 8 rods) along the most westerly side of said school lot, Thence East parallel with the South line of said section 2.25 chains to the N. and S. quarter section line of said section No. 3, Thence S. on said qr. section line 6.15 chains to the place of beginning, containing 6.87 acres of land.

Surveyed by W. McChild C.S.

Recorded by Lloyd S. Jensen C.S.

March 21, 1934