No 453

Record of Survey.

28-2-16

Township ... North of Range ... 4 Principal Meridian

Cor. Section Corners


North line of Section (North)

Surveys presented by the courses and distances on the following plat, and annexed field-notes of survey:

Established the center of the section at the point of intersection of STRAIGHT quarter lines.

Established all quarter-quarter corners upon the section boundary at proportional distances between known section and quarter section corners, according to the original field-notes of the Government survey.

Established all lost corners at proportionate distances between known corners, according to the original field notes of the Government survey.

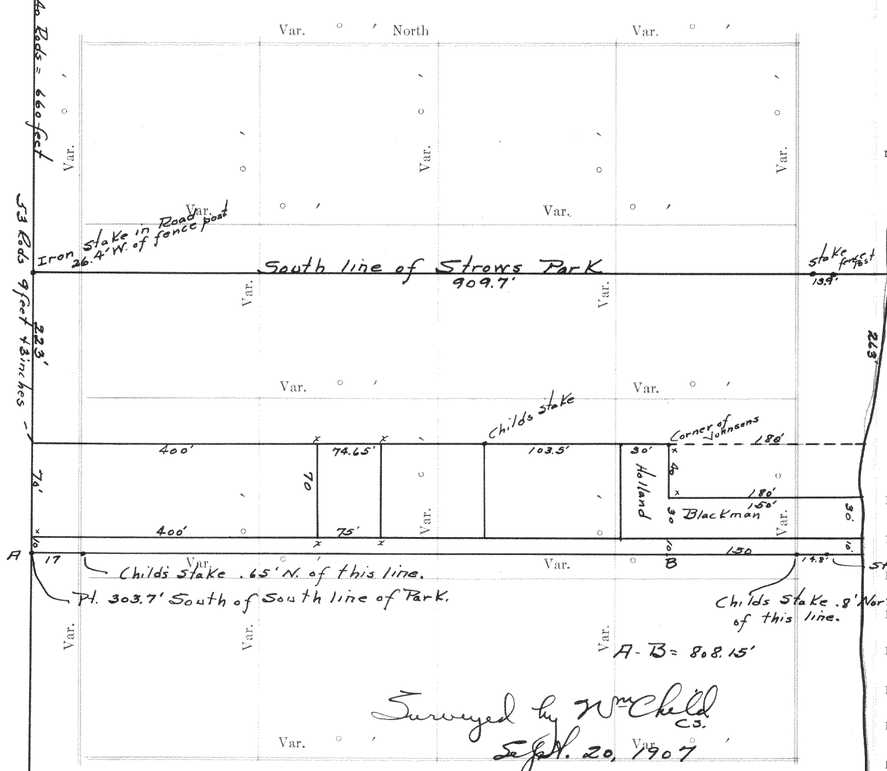

Surveyed by Wm Child C.S.
Sept. 20, 1907

Plat of Section ..., Township ... North, Range ... of 4 Principal Meridian Scale 80 chains to 6 inches. The figures in red ink are the lengths of the lines as stated in the field-notes of the Government survey.

Recorded by Lloyd S. Jensen
March 26, 1934

Declination of the Magnetic Meridian from the True Meridian ...

Surveyed and sub-divided ... A. D. 1 ..., in accordance with the State Laws and Instructions of the Commissioner of the General Land office, and recorded on pages ... of Register in the County Clerk's office.

Witness my hand this ... day of ... A. D. 1

... SURVEYOR.

DESCRIPTION

OF SECTION, QUARTER SECTION AND QUARTER QUARTER SECTION CORNERS

H. C. MILLER CO., MFG. STATIONERS, MILWAUKEE X15000

GOVERNMENT CORNERS	Bearing Trees	In. Dia.	Courses they bear	Links Distant	Bearing Trees	In. Dia.	Courses they bear	Links Distant	Bearing Trees	In. Dia.	Courses they bear	Links Distant	Bearing Trees	In. Dia.	Courses they bear	Links Distant
No.																
1. N. W. Sec. Cor. indentified,																
2. N. E. Sec. Cor. indentified,																
3. S. E. Sec. Cor. indentified,																
4. S. W. Sec. Cor. indentified,																
5. N. ¼ Sec. Cor. indentified,																
6. E. ¼ Sec. Cor. indentified,																
7. S. ¼ Sec. Cor. indentified,																
8. W. ¼ Sec. Cor. indentified,																
Subdivision Corners																
No.																
1. Center ¼ Sec. Cor.																
2. North ¼-⅛s N. W. qr.,																
3. East ¼-⅛s N. W. qr.,																
4. South ¼-⅛s N. W. qr.,																
5. West ¼-⅛s N. W. qr.,																
6. Center ¼-⅛s N. W. qr.,																
7. North ¼-⅛s N. E. qr.,																
8. East ¼-⅛s N. E. qr.,																
9. South ¼-⅛s N. E. qr.,																
10. Center ¼-⅛s N. E. qr.,																
11. East ¼-⅛s S. E. qr.,																
12. South ¼-⅛s S. E. qr.,																
13. West ¼-⅛s S. E. qr.,																
14. Center ¼-⅛s S. E. qr.,																
15. South ¼-⅛s S. W. qr.,																
16. West ¼-⅛s S. W. qr.,																
17. Center ¼-⅛s S. W. qr.																

No 454

32-2-16

Beginning at an iron monument as perscribed by law for the recording of Village Plats in the center of the highway and which iron monument is 43.3 feet north and 25 feet East of the quarter section corner on the South line of Section No. 32, in Town 2 North, R 16 E, being the Town of Delavan, Walworth Co., Wisconsin.

Thence North parallel with and 25 feet East of the quarter section line of said section No. 32. 949.8 feet to a like iron monument; Thence N59°28E being parallel with and 25 feet from, (measuring at right angles to) the line of a survey made by James S. Tufts Eng. 14th 1896 for the use of Lake shore Lots 540.9 feet to a like iron monument; Thence South parallel with the above mentioned quarter section line 920 feet to a like iron monument in the center of the road or highway; Thence S57°W 556.3 feet to the place of beginning.

Surveyed by Wm Child CS

Recorded by Lloyd S. Jensen CS
March 26, 1934

NAMES OF SWORN ASSISTANTS

CHAINMEN	FLAGMEN	AXMEN

No 455 27-2-16

Harrington Subdivision

Beginning at an iron monument in the center of one certain road and said iron monument being the Southeast corner of one certain plat known as the Harrington Sub. and which plat is on record in the Register of Deeds office in and for Walworth County, Wisconsin, in Vol. 6 of Plats on page; Thence East 132.5 feet to a stake; Thence South 125 feet to a stake; Thence west 216.5 feet to a stake in the center of the above mentioned road; Thence northeasterly along the center of said road 150.5 feet to the place of beginning containing ½ acre of land.

Surveyed by Wm Child CS.

Recorded by Floyd S. Jones CS.
March 26, 1934

No. 456 27-2-16

Description of old Lot 8 of Lake View.

Beginning at a stake at the Southeast corner of Lot no. 7 in the plat of Lake View which plat is on record in the Register of Deeds office in and for Walworth Co., Wisconsin, in Vol. 4 of Plats on page 37, Thence northwesterly along the most southerly line of said lot 7, 313 feet more or less to the shore of Delavan Lake at low water line; Thence southerly along the shore of said Lake at low water line to a point; Thence southeasterly 23 feet more or less to a stake being on a line of the lake line of the above mentioned plat and 50 feet from a stake on said line on the most southerly side of said lot 7 and producing or extending said line southeasterly 285.7 feet to a stake being in line with the south easterly line of said plat and 65 feet from the South east corner of said lot 7, and 35.5 feet more to a stake in the center of one certain road 10.8 feet northerly from an angle stake in said road; Thence northeasterly along the center of said road 68.2 feet to a stake 2.5 feet southerly from an angle stake in said road; Thence northwesterly 25.4 feet to the place of beginning.

Surveyed by Wm Child CS.

Recorded by Floyd S. Jones CS.
March 26, 1934