Record of Survey.

No 467

25-4-16

Township ..., North of Range Pleasant Lake 4 Principal Meridian as presented by the courses and distances on the following plat, and annexed field-notes of survey:

Established the center of the section at the point of intersection of STRAIGHT quarter lines.

Established all quarter-quarter corners upon the section boundary at proportional distances between known section and quarter section corners, according to the original field-notes of the Government survey.

Established the post corners at proportional distances between known corners on the original field notes of the Government survey.

Description of Tract pieced

All that certain piece or parcel of land lying and being in the Township of La Grange, Walworth County, Wisconsin, described as follows to wit:- Beginning at an iron stake, on the Easterly shore of Pleasant Lake, That is S25°-15' W 60 feet from an iron stake, at the point where the north line of said section 25 intersects the said lake shore, and the said stake being witnessed by a Cotton wood tree southerly 15.5 feet, and an oak tree, Easterly, 17 feet; Thence S78°-00' E 105 feet, to a stake; Thence S 43°-30' W 90 feet to a stake; Thence N 63°-00' W 73.5 feet to a stake on the shore of said Lake; Thence ~~[illegible]~~ N25°-15' E lieing along the said shore 60 feet to the place of beginning, excepting and reserving, for a right of way to be used in common with others, a strip of land, 10 feet in width off of the Southeasterly side of the above described piece.

Surveyed by Wm Child CS.

Recorded by Lloyd L. Jensen CS. March 28, 1934

Plat of Section ..., Township ... North, Range ... of 4 Principal Meridian. Scale 80 chains to 6 inches. The figures in red ink are the lengths of the lines as stated in the field-notes of the Government survey.

Declination of the Magnetic Meridian from the True Meridian ...

Surveyed and sub-divided ... A. D. 1 , in accordance with the State Laws and Instructions of the Commissioner of the General Land office, and recorded on pages ... of Register in the County Clerk's office.

Witness my hand this ... day of ... A. D. 1

... SURVEYOR.


DESCRIPTION

OF SECTION, QUARTER SECTION AND QUARTER QUARTER SECTION CORNERS

H. C. MILLER CO. MFG. STATIONERS, MILWAUKEE X15000

GOVERNMENT CORNERS	Bearing Trees	In. Dia.	Courses they bear	Links Distant	Bearing Trees	In. Dia.	Courses they bear	Links Distant	Bearing Trees	In. Dia.	Courses they bear	Links Distant	Bearing Trees	In. Dia.	Courses they bear	Links Distant
No.																
1. N. W. Sec. Cor. indentified,																
2. N. E. Sec. Cor. indentified,																
3. S. E. Sec. Cor. indentified,																
4. S. W. Sec. Cor. indentified,																
5. N. ¼ Sec. Cor. indentified,																
6. E. ¼ Sec. Cor. indentified,																
7. S. ¼ Sec. Cor. indentified,																
8. W. ¼ Sec. Cor. indentified,																
Subdivision Corners																
No.																
1. Center ¼ Sec. Cor.																
2. North ¼-⅛s N. W. qr.,																
3. East ¼-⅛s N. W. qr.,																
4. South ¼-⅛s N. W. qr.,																
5. West ¼-⅛s N. W. qr.,																
6. Center ¼-⅛s N. W. qr.,																
7. North ¼-⅛s N. E. qr.,																
8. East ¼-⅛s N. E. qr.,																
9. South ¼-⅛s N. E. qr.,																
10. Center ¼-⅛s N. E. qr.,																
11. East ¼-⅛s S. E. qr.,																
12. South ¼-⅛s S. E. qr.,																
13. West ¼-⅛s S. E. qr.,																
14. Center ¼-⅛s S. E. qr.,																
15. South ¼-⅛s S. W. qr.,																
16. West ¼-⅛s S. W. qr.,																
17. Center ¼-⅛s S. W. qr.																

No 468

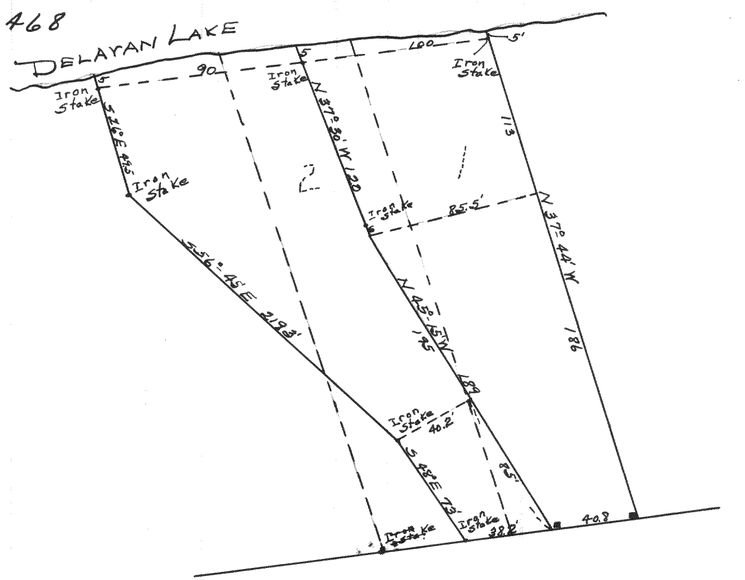

Plat of a survey made for Charles Lenz of Chicago in lots 1-2-3 of the plat of Sans Souci, which Plat is on record in the Registers of Deeds office in and for Walworth County, Wisconsin, in Vol. 5 of Plats on page 62

Elkhorn June 9, 1924


Wm Child CS.

Recorded by Lloyd L. Jensen CS. March 29, 1934

NAMES OF SWORN ASSISTANTS

CHAINMEN	FLAGMEN	AXMEN

No 469 18-2-16

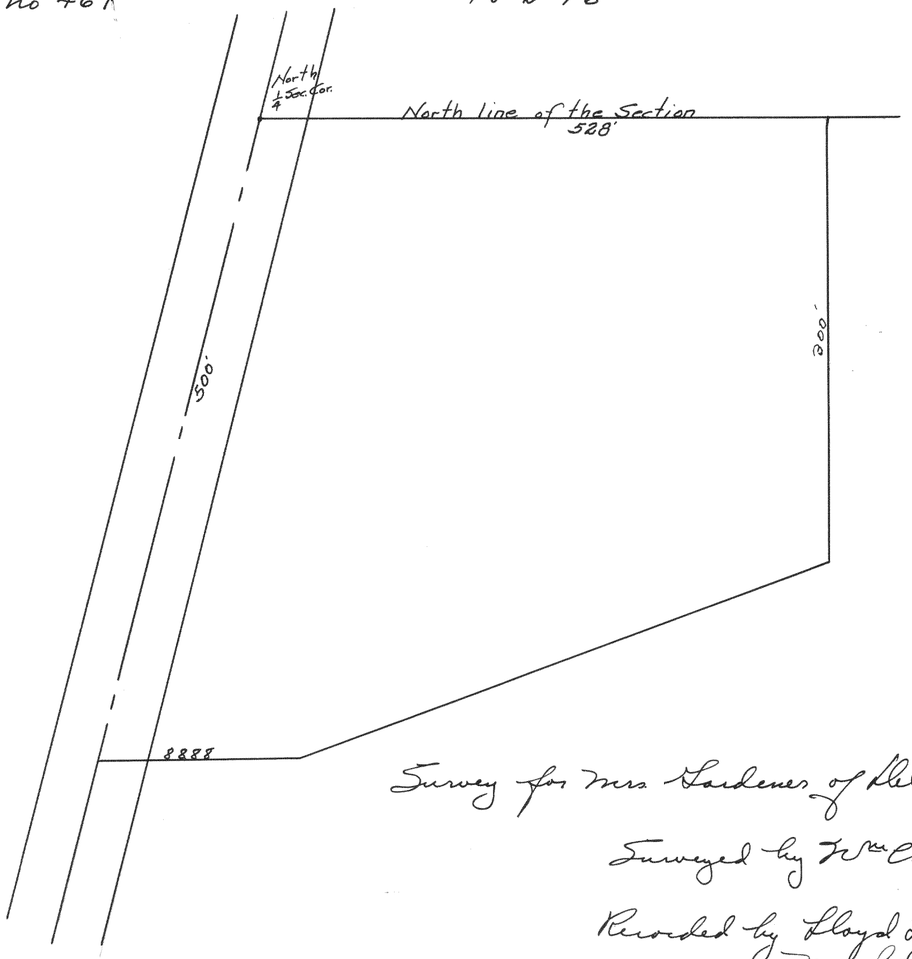

Survey for Mrs. Gardener of Delavan

Surveyed by F. Wm. Child
CS

Recorded by Lloyd S. Jensen
CS
March 29, 1934

No 470 28-2-16

That certain piece or parcel of land lying and being in the Northwest quarter of Section No. 28, T2N, R16E, being the Town of Delavan, Walworth County, Wisconsin, described as follows to wit: Beginning at a point 1½ rods south and 7 rods 5½ ft. West of the Northeast corner of the said quarter section, being also the center of the road; thence south on a line parallel with the East line of said qr. section 466.09 feet to an iron stake; thence Westerly 375.7 feet to a stake; thence north parallel with the East line of said quarter section 461.39 feet to a point 1½ rods South of the North line of the said quarter section, being the center of the road; thence East being along the center of said road 375.7 feet to the place of beginning containing four (4) acres of land.

Surveyed by F. Wm. Child
CS

Recorded by Lloyd S. Jensen
CS
March 29, 1934