158

No 479

Record of Survey.


29432-2-16

Township ..... North of Range ..... of 4 Principal Meridian as presented by the courses and distances on the following plat, and annexed field-notes of survey:

Established the center of the section at the point of intersection of STRAIGHT quarter lines. Road

Established all quarter-quarter corners upon the section boundary at proportional distances between known section and quarter section corners, according to the original field-notes of the Government survey. 250 feet

Established all lost corners at proportionate distances between known corners, according to the original field notes of the Government survey.

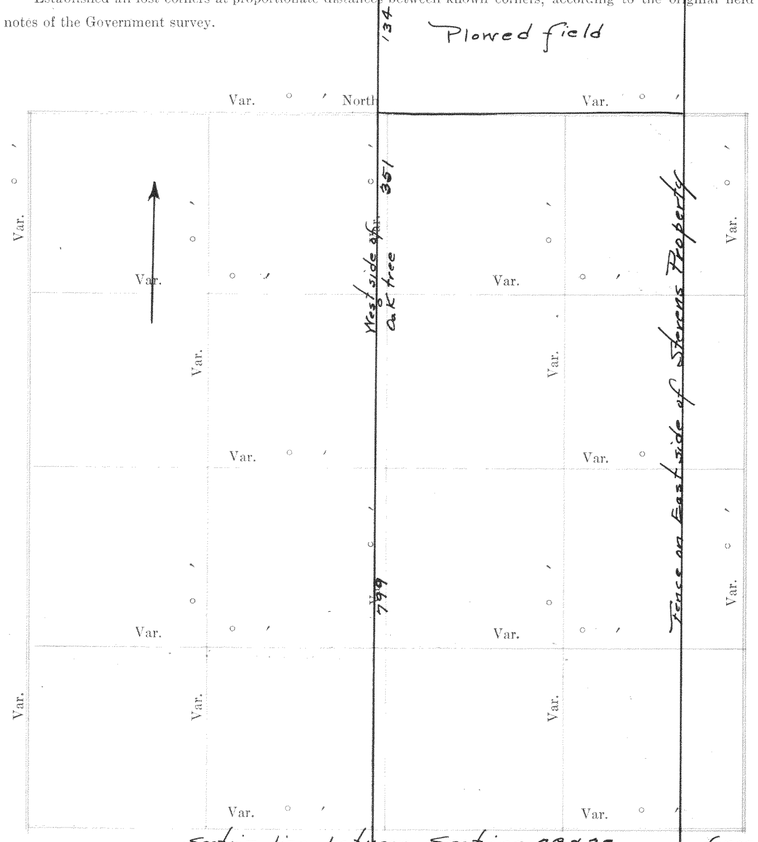

Plat of Section ....., Township ..... North, Range ..... of 4 Principal Meridian Scale 80 chains to 6 inches. The figures in red ink are the lengths of the lines as stated in the field-notes of the Government survey.

Declination of the Magnetic Meridian from the True Meridian .....

Surveyed and sub-divided ..... A. D. 1 , in accordance with the State Laws and Instructions of the Commissioner of the General Land office, and recorded on pages ..... of Register in the County Clerk's office.

Witness my hand this ..... day of ..... A. D. 1

..... SURVEYOR.

DESCRIPTION

OF SECTION, QUARTER SECTION AND QUARTER QUARTER SECTION CORNERS

H. C. MILLER CO., MFG. STATIONERS, MILWAUKEE X15000

GOVERNMENT CORNERS	Bearing Trees	In. Dia.	Courses they bear	Links Distant	Bearing Trees	In. Dia.	Courses they bear	Links Distant	Bearing Trees	In. Dia.	Courses they bear	Links Distant	Bearing Trees	In. Dia.	Courses they bear	Links Distant
No.																
1. N. W. Sec. Cor. indentified,																
2. N. E. Sec. Cor. indentified,																
3. S. E. Sec. Cor. indentified,																
4. S. W. Sec. Cor. indentified,																
5. N. ¼ Sec. Cor. indentified,																
6. E. ¼ Sec. Cor. indentified,																
7. S. ¼ Sec. Cor. indentified,																
8. W. ¼ Sec. Cor. indentified,																
Subdivision Corners																
No.																
1. Center ¼ Sec. Cor.																
2. North ¼-¼s N. W. qr.,																
3. East ¼-¼s N. W. qr.,																
4. South ¼-¼s N. W. qr.,																
5. West ¼-¼s N. W. qr.,																
6. Center ¼-¼s N. W. qr.,																
7. North ¼-¼s N. E. qr.,																
8. East ¼-¼s N. E. qr.,																
9. South ¼-¼s N. E. qr.,																
10. Center ¼-¼s N. E. qr.,																
11. East ¼-¼s S. E. qr.,																
12. South ¼-¼s S. E. qr.,																
13. West ¼-¼s S. E. qr.,																
14. Center ¼-¼s S. E. qr.,																
15. South ¼-¼s S. W. qr.,																
16. West ¼-¼s S. W. qr.,																
17. Center ¼-¼s S. W. qr.																

Plat of survey of part of what was formerly The Chas. Stevens farm now owned by Jane T. Moulding.

Surveyed by Wm Child CS

Recorded by Floyd P. Jensen CS March 30, 1934

NAMES OF SWORN ASSISTANTS

CHAINMEN	FLAGMEN	AXMEN

No 480

22-2-16

Part of Block 2 of San Souci

Discriptions from Surveys.


Commencing at the N.W. corner of Ernest C. Smith's land, Thence E. along said Smith's N. line 104 ft. to an iron stake; Thence NWly 110 feet to an iron stake at the S. side of the road; Thence SWly along the south side of said road, 91.4 ft. more or less to an iron stake on the E'ly side of road 58 ft. 9 inches N. of the NW. corner of said Smith's land, Thence South 58 ft. 9 inches to the place of beginning. Also beginning at the iron fence post at the S.E. corner of the above described lot; Thence west being along the South line of said lot, 37 ft. to the N.E corner of the lot owned by one Smith, Thence South being along the E. line of said Smith lot and the E. line of the lot owned by Mr. Andrus 95 ft. to the SE corner of said Andrus lot, it being on the N. line of the lot owned by one Griffenhagen, Thence E. being along the N. line of said Griffenhagen lot 121.5 ft. to a fence post on the W. line of a lot owned by R. Blodgett, Thence North being along the W. line of said Blodgett's lot and the West line of a portion of the lot owned by Mrs. Anderson 101.5 ft. to a fence post, Thence West being along the S. line of a portion of the lot owned by said Anderson 34.5 ft. to an iron stake at the S.W. corner thereof and continuing Wly 36.5 ft. to the place of beginning. All in Sec. 22, T2N. R 16E of the 4th P.M. Walworth County, Wisconsin.

Surveyed by Wm Child C.S.

Recorded by Lloyd S. Jensen C.S.
March 30, 1934

No 481

22-2-16

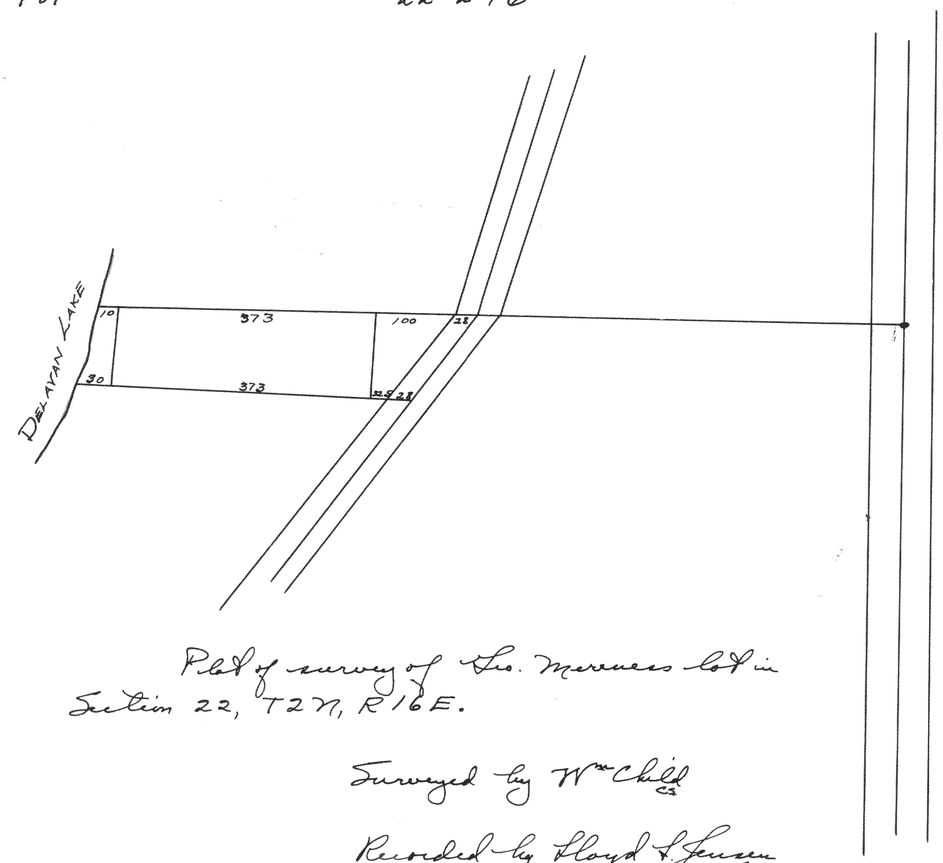

Plat of survey of Geo. Mercuers lot in Section 22, T2N, R16E.

Surveyed by Wm Child C.S.

Recorded by Lloyd S. Jensen C.S.
March 30, 1934