Record of Survey.

4-4-18

No 513

Township ..., North of Range ...of 4 Principal Meridian as presented by the courses and distances on the following plat, and annexed field-notes of survey:

Established the center of the section at the point of intersection of STRAIGHT quarter lines.

Established all quarter-quarter corners upon the section boundary at proportional distances between known section and quarter section corners, according to the original field-notes of the Government survey.


Established all lost corners at proportionate distances between known corners, according to the original field-notes of the Government survey.

On the Town of East Troy in said County of Walworth, Described Tract as follows; Beginning at a point on the shore of the Lower Lake or pond 870 feet South of the North west corner of a plat of land known as Trees Park; Thence N 10° 40' E 410 feet; Thence S 87° 45' W 300 feet; Thence S 8° 50' W 270 feet to the shore of said Lower Lake or pond; Thence Southeasterly along the shore of said Lower Lake or pond to the place of beginning; reference being had to a plat of said land surveyed by Wm Child, County Surveyor of Walworth Co., Wisconsin, Sept. 1 & 2, 1902 by direction of John Tree; said tract containing 2.1 acres more or less; all of said land being situated in Section 4, T. 4 N., R 18 E of the 4th P. M.

Surveyed by Wm Child CS


Apr. 2, 1934

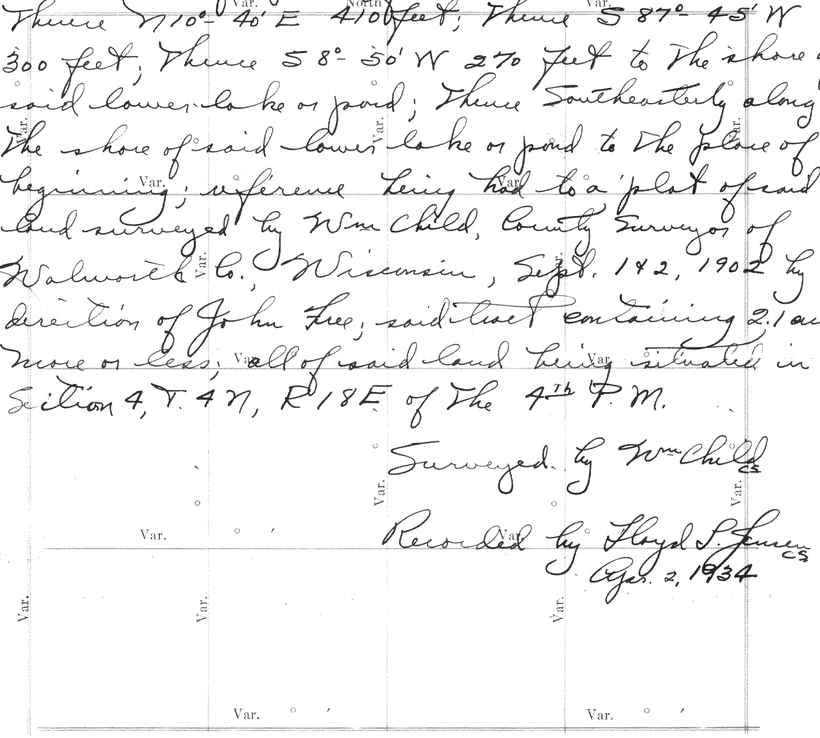

Plat of Section ..., Township ...North, Range ...of 4 Principal Meridian Scale 80 chains to 6 inches. The figures in red ink are the lengths of the lines as stated in the field-notes of the Government survey.

Declination of the Magnetic Meridian from the True Meridian ...

Surveyed and sub-divided ...A. D. 1 , in accordance with the State Laws and Instructions of the Commissioner of the General Land office, and recorded on pages ...of Register in the County Clerk's office.

Witness my hand this ...day of ...A. D. 1

...SURVEYOR.

DESCRIPTION

OF SECTION, QUARTER SECTION AND QUARTER QUARTER SECTION CORNERS

N. C. MILLER CO. MFG. STATIONERS, MILWAUKEE X15000

GOVERNMENT CORNERS	Bearing Trees	In. Dia.	Courses they bear	Links Distant	Bearing Trees	In. Dia.	Courses they bear	Links Distant	Bearing Trees	In. Dia.	Courses they bear	Links Distant	Bearing Trees	In. Dia.	Courses they bear	Links Distant
No. 1. N. W. Sec. Cor. indentified,																
2. N. E. Sec. Cor. indentified,																
3. S. E. Sec. Cor. indentified,																
4. S. W. Sec. Cor. indentified,																
5. N. ¼ Sec. Cor. indentified,																
6. E. ¼ Sec. Cor. indentified,																
7. S. ¼ Sec. Cor. indentified,																
8. W. ¼ Sec. Cor. indentified,																
Subdivision Corners																
No. 1. Center ¼ Sec. Cor.																
2. North ¼-⅛s N. W. qr.,																
3. East ¼-⅛s N. W. qr.,																
4. South ¼-⅛s N. W. qr.,																
5. West ¼-⅛s N. W. qr.,																
6. Center ¼-⅛s N. W. qr.,																
7. North ¼-⅛s N. E. qr.,																
8. East ¼-⅛s N. E. qr.,																
9. South ¼-⅛s N. E. qr.,																
10. Center ¼-⅛s N. E. qr.,																
11. East ¼-⅛s S. E. qr.,																
12. South ¼-⅛s S. E. qr.,																
13. West ¼-⅛s S. E. qr.,																
14. Center ¼-⅛s S. E. qr.,																
15. South ¼-⅛s S. W. qr.,																
16. West ¼-⅛s S. W. qr.,																
17. Center ¼-⅛s S. W. qr.																

No 514

5-4-18

Description of homestead from Survey.

Beginning at a point on the North and South ⅛ section line in the West half of section 5, T 4 N. R 18 E or Town of East Troy, Walworth Co., Wisc., where said ⅛ section line intersects the centerline of the road running Southwest and Northeast through said section line, and said place of beginning, being the Southwest corner of lands deeded to the late James Kavanagh the 7th day of Aug. 1871 and which deed is on record in the Register of deeds office, in and for said Wal. Co., in Vol. 50 of deeds on page 351; Thence North on said ⅛ line 22.40 chains to an iron stake; Thence East at right angles to said ⅛ line 18.89 chains to an iron stake in line of one certain fence being the East line of lands deeded to said Kavanagh; Thence Southwest along the line of said fence 19.49 chains to the center of the above mentioned road; Thence Southwest along the center of said road 18.67 chains to the place of beginning, containing 40 acres of land.

Surveyed by Wm Child CS.

Dec. 1904

Recorded by Floyd S. Jones CS.

April 2, 1934

NAMES OF SWORN ASSISTANTS

CHAINMEN	FLAGMEN	AXMEN

No 515 5-4-18

Description of remaining piece
from survey

Beginning at an iron stake on the north and south 1/8 section line in the West half of Section 5, T4N, R18E, on Town of East Troy, Walworth Co. Wisconsin, and said iron stake being 22.40 chains, north, of where said 1/8 section line, intersects, the centerline of the road, running Southwest and Northeast through said Section 5;

Thence north on said 1/8 section line about 30.66ch. to the north line of said section 5.

Thence East along said north line about 19.60ch. to a point 30 lks west of the quarter section corner on the northside of said section 5.

Thence Southwesterly along the line of one certain ditch or fence, which ditch and fence is the East line of lands deeded to the late James Kavanagh the — day of and which deed is on record in the Registers of Deeds office, in and for said Wal. Co. in Vol. 50 of deeds on page 351 to an iron stake.

Thence West being at right angles, to the above mentioned 1/8 section corner 18.89 chains to the place of beginning, containing 57 acres more or less.

Surveyed by Wm Child CS
Dec. 19, 1904

Recorded by Lloyd S. Jensen CS.
April 2, 1934

No 516 9-4-18

Beginning at a stake in the center of the road as now traveled and on the 1/4 section line 262 feet west of the East 1/4 post of Section 9, T4N, R18E; Thence S 9°-00' E 300 feet along the center of the road to a stake; Thence S 70°-15' W 350' to a stake.
" N 62°-00' W 350' " " " .
" N 78°-00' W 478' " " " .
" N 0°-45' E 100' " " " .
" N 43°-00' E 226' " " " on the shore of Beulah Lake; Thence Starting in a southeast direction and following the lake shore to a stake; Thence East parallel to the 1/4 line 210 feet to the center of the road; Thence S 9°-00' E 263 feet to the place of beginning, containing 9.0 acres of land more or less.

Surveyed by Wm Child

Recorded by Lloyd S. Jensen CS.
Sept. 3, 1934