Record of Survey.

No 528


14-1-16

Township ..., North of Range FONTANA ...of 4 Principal Meridian as presented by the courses and distances on the following plat, and annexed field-notes of survey:

Established the center of the section at the point of intersection of STRAIGHT quarter lines.

Estabished all quarter-quarter corners upon the section boundary at proportional distances between known section and quarter section corners, according to the original field-notes of the Government survey.

Established all lost corners at proportionate distances between known corners, according to the original field notes of the Government survey.

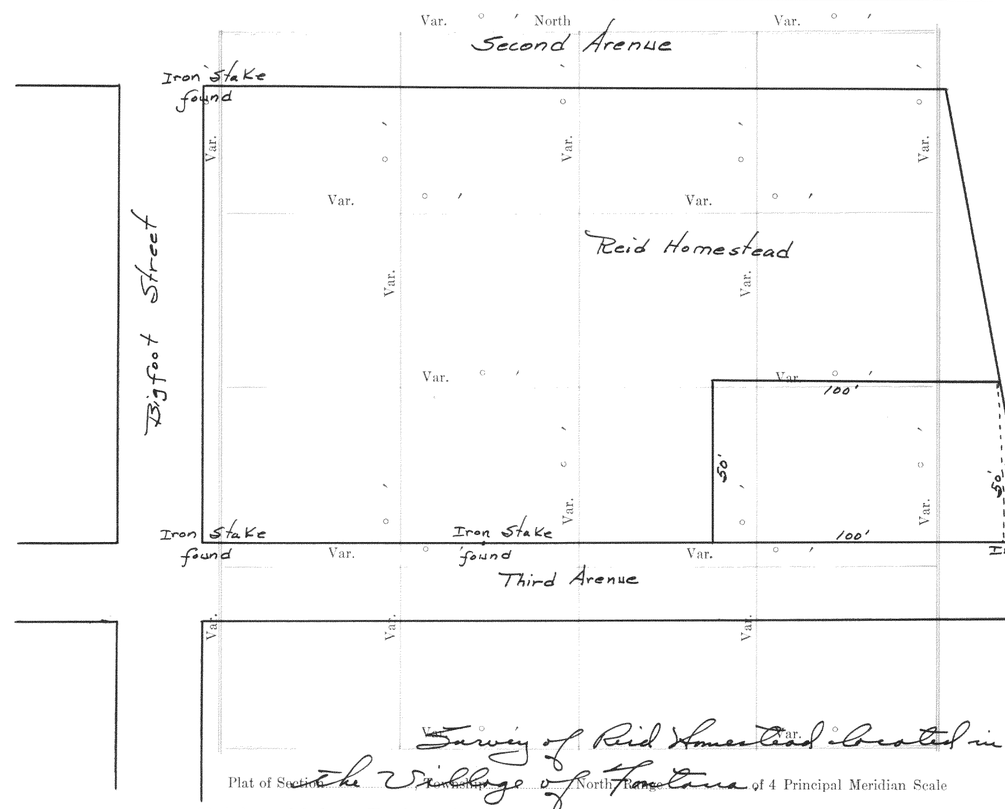

Plat of Survey of Reid Homestead located in the Subdivision of ~~Section~~ ... of North Range ~~East~~ of 4 Principal Meridian Scale 80 chains to 6 inches. The figures in red ink are the lengths of the lines as stated in the field-notes of the Government survey.

Surveyed by Wm Child CS.

Declination of the Magnetic Meridian from the True Meridian ...

Surveyed and sub-divided ... A. D. 1934 in accordance with the State Laws and Instructions of the Commissioner of the General Land Office and recorded on pages ... of Register in the County Clerk's office.

Recorded by Lloyd D Jensen CS.
April 26, 1934

Witness my hand this ... day of ... A. D. 1

... SURVEYOR.


DESCRIPTION

22-2-16

OF SECTION, QUARTER SECTION AND QUARTER QUARTER SECTION CORNERS

M. C. MILLER CO., MFG. STATIONERS, MILWAUKEE X15000

GOVERNMENT CORNERS	Bearing Trees	In. Dia.	Courses they bear	Links Distant	Bearing Trees	In. Dia.	Courses they bear	Links Distant	Bearing Trees	In. Dia.	Courses they bear	Links Distant	Bearing Trees	In. Dia.	Courses they bear	Links Distant
No.																
1. N. W. Sec. Cor. indentified,																
2. N. E. Sec. Cor. indentified,																
3. S. E. Sec. Cor. indentified,																
4. S. W. Sec. Cor. indentified,																
5. N. ¼ Sec. Cor. indentified,																
6. E. ¼ Sec. Cor. indentified,																
7. S. ¼ Sec. Cor. indentified,																
8. W. ¼ Sec. Cor. indentified,																
Subdivision Corners																
No.																
1. Center ¼ Sec. Cor.																
2. North ¼-¼s N. W. qr.,																
3. East ¼-¼s N. W. qr.,																
4. South ¼-¼s N. W. qr.,																
5. West ¼-¼s N. W. qr.,																
6. Center ¼-¼s N. W. qr.,																
7. North ¼-¼s N. E. qr.,																
8. East ¼-¼s N. E. qr.,																
9. South ¼-¼s N. E. qr.,																
10. Center ¼-¼s N. E. qr.,																
11. East ¼-¼s S. E. qr.,																
12. South ¼-¼s S. E. qr.,																
13. West ¼-¼s S. E. qr.,																
14. Center ¼-¼s S. E. qr.,																
15. South ¼-¼s S. W. qr.,																
16. West ¼-¼s S. W. qr.,																
17. Center ¼-¼s S. W. qr.																

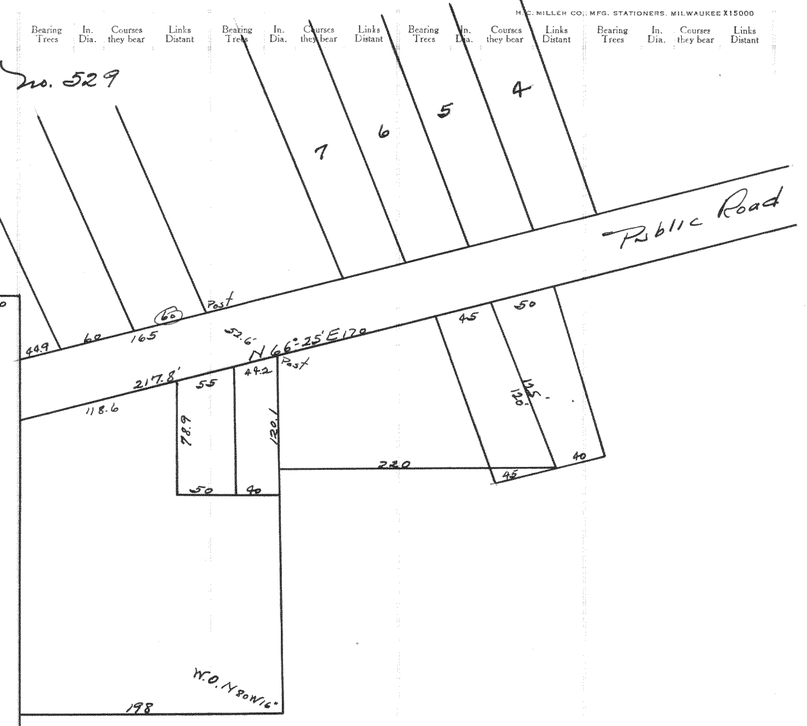

Plat of a survey of 3 small parcels in the Subdivisions of Sans Souci and Mereness Springs

Surveyed by Wm Child CS.

Recorded by Lloyd D Jensen CS.
April 26, 1934


NAMES OF SWORN ASSISTANTS

CHAINMEN | FLAGMEN | AXMEN

175

No 530

33-2-16

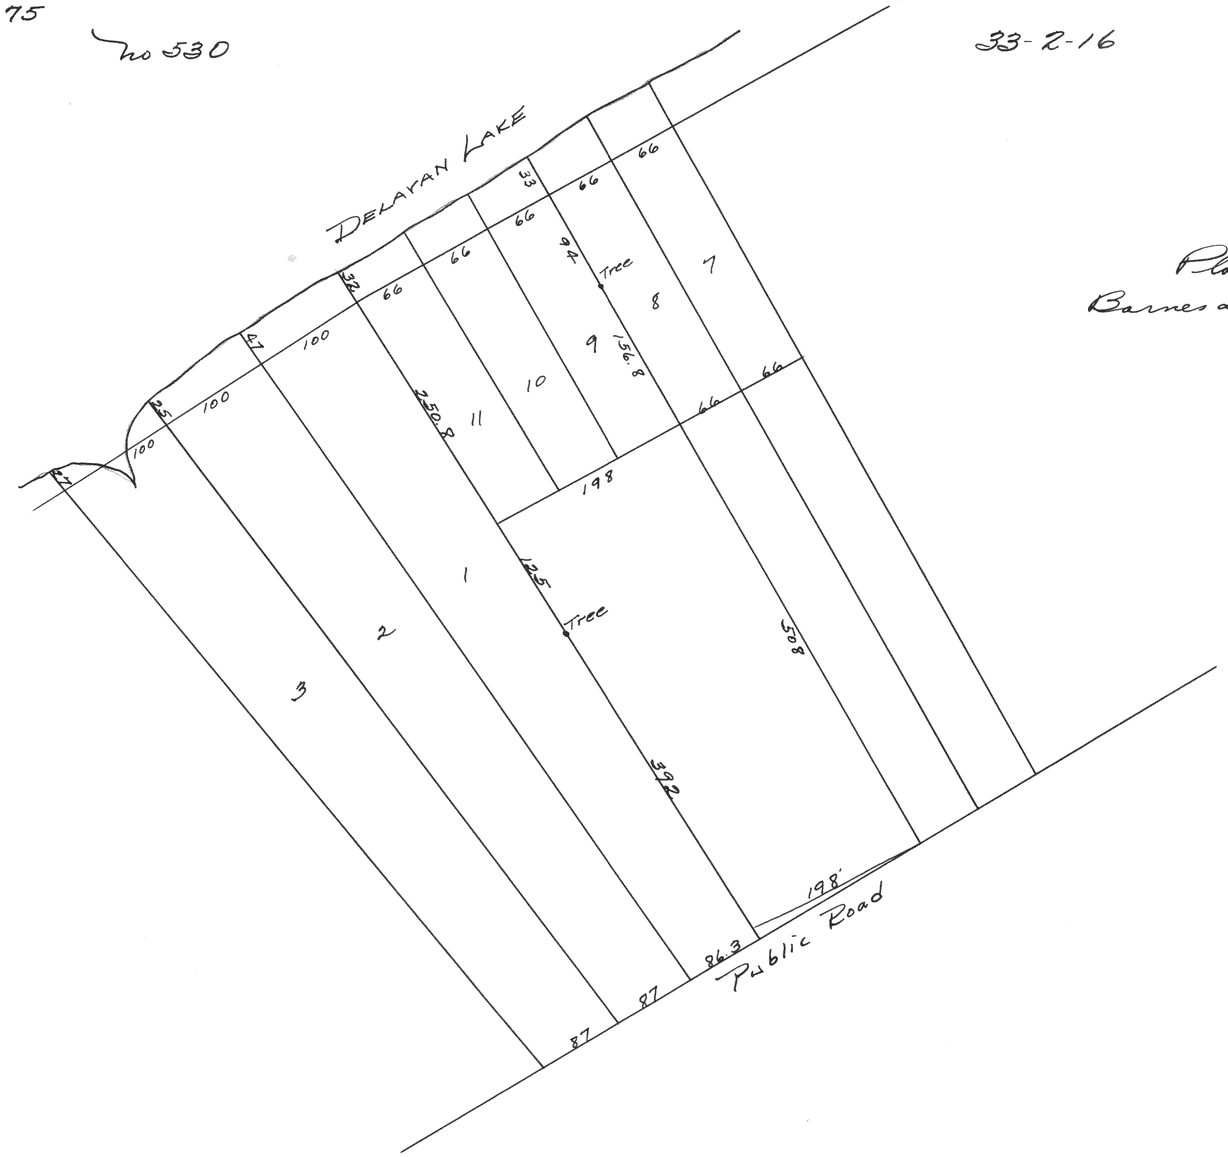

Plat of survey of lots in Collins Grove and Barnes and Von Steenwilck Subdivisions.

Surveyed by Wm Child C.S.

Recorded by Floyd S. Jones C.S.

April 20, 1934