Record of Survey.


No 537 1-1-16

Township ..., North of Range WILLIAMS BAY ... Principal Meridian as presented by the courses and distances on the following plat, and annexed field-notes of survey:

Established the center of the section at the point of intersection of STRAIGHT quarter lines.

Established all quarter-quarter corners upon the section boundary at proportional distances between known section and quarter section corners, according to the original field-notes of the Government survey.

Established all lost corners at proportionate distances between known corners, according to the original field notes of the Government survey.

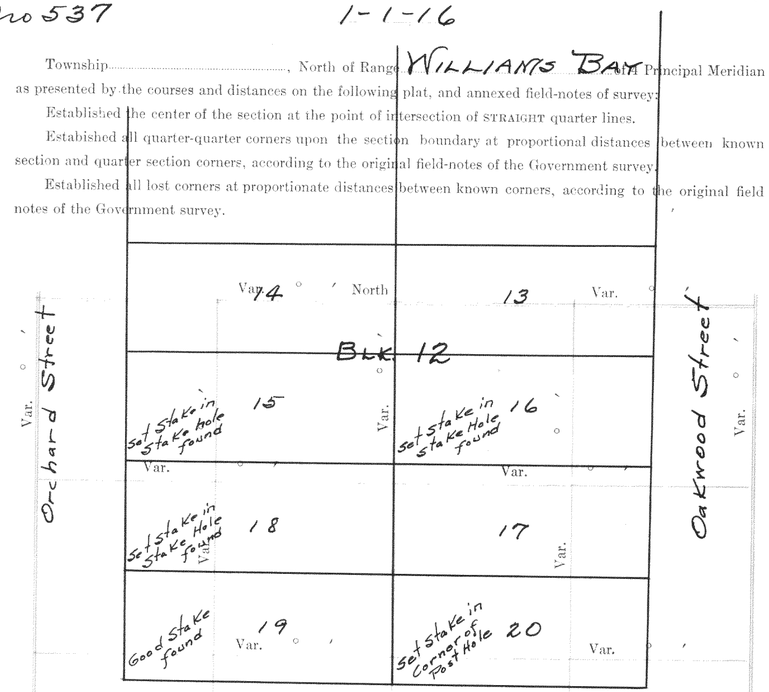

Plat of survey of part of Block 12 of Williams second Addition to the Village of Williams Bay.

Surveyed by Wm Child C.S.

Recorded by Floyd S. Jensen C.S.

April 21, 1934

Plat of Section ..., Township ... North, Range ... of 4 Principal Meridian. Scale 80 chains to 6 inches. The figures in red ink are the lengths of the lines as stated in the field-notes of the Government survey.

Declination of the Magnetic Meridian from the True Meridian ...

Surveyed and sub-divided ... A. D. 1 ..., in accordance with the State Laws and Instructions of the Commissioner of the General Land office, and recorded on pages ... of Register in the County Clerk's office.

Witness my hand this ... day of ... A. D. 1

... SURVEYOR.


DESCRIPTION

OF SECTION, QUARTER SECTION AND QUARTER QUARTER SECTION CORNERS

N. C. MILLER CO. MFG. STATIONERS, MILWAUKEE X15000

GOVERNMENT CORNERS	Bearing Trees	In. Dia.	Courses they bear	Links Distant	Bearing Trees	In. Dia.	Courses they bear	Links Distant	Bearing Trees	In. Dia.	Courses they bear	Links Distant	Bearing Trees	In. Dia.	Courses they bear	Links Distant
No.																
1. N. W. Sec. Cor. indentified,	No. 538															
2. N. E. Sec. Cor. indentified,																
3. S. E. Sec. Cor. indentified,																
4. S. W. Sec. Cor. indentified,																
5. N. ¼ Sec. Cor. indentified,																
6. E. ¼ Sec. Cor. indentified,																
7. S. ¼ Sec. Cor. indentified,																
8. W. ¼ Sec. Cor. indentified,																
Subdivision Corners																
No.																
1. Center ¼ Sec. Cor.																
2. North ¼-¼s N. W. qr.,																
3. East ¼-¼s N. W. qr.,				63				66								
4. South ¼-¼s N. W. qr.,																
5. West ¼-¼s N. W. qr.,																
6. Center ¼-¼s N. W. qr.,																
7. North ¼-¼s N. E. qr.,																
8. East ¼-¼s N. E. qr.,																
9. South ¼-¼s N. E. qr.,																
10. Center ¼-¼s N. E. qr.,																
11. East ¼-¼s S. E. qr.,																
12. South ¼-¼s S. E. qr.,																
13. West ¼-¼s S. E. qr.,																
14. Center ¼-¼s S. E. qr.,																
15. South ¼-¼s S. W. qr.,																
16. West ¼-¼s S. W. qr.,																
17. Center ¼-¼s S. W. qr.																

ELKHORN

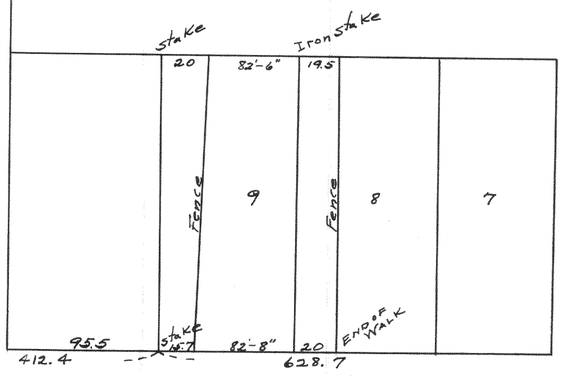

Randal Place to The Avenue

Plat of a survey in Block 1 of Hodge's Add. to the City of Elkhorn.

Surveyed by Wm Child C.S.

Recorded by Floyd S. Jensen C.S.

April 21, 1934


CHAINMEN

NAMES OF SWORN ASSISTANTS

FLAGMEN	AXMEN

178 No 539

1-1-16

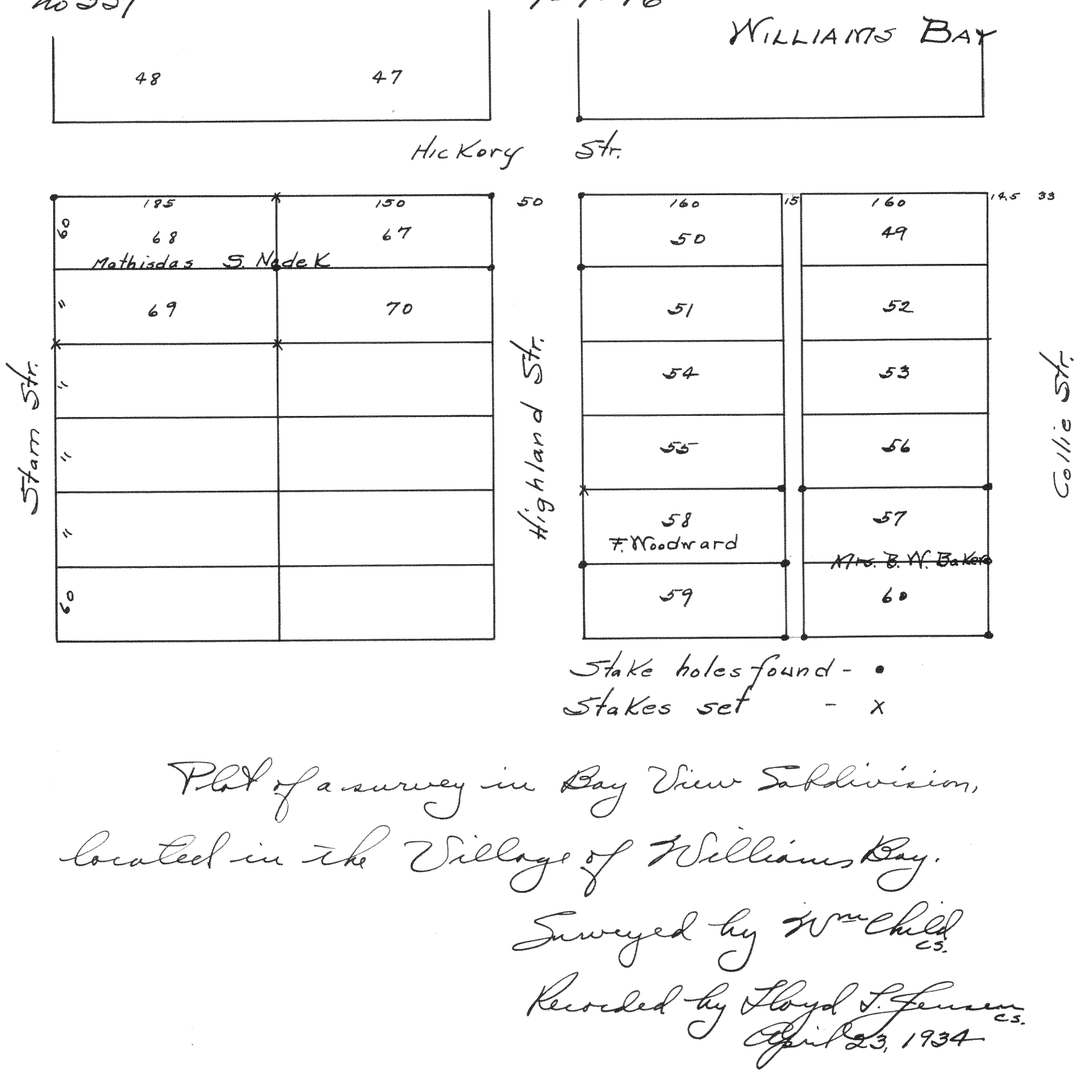

Stake holes found - •

Stakes set - X

Plat of a survey in Bay View Subdivision, located in the Village of Williams Bay.

Surveyed by Wm Child C.S.

Recorded by Lloyd S. Jensen C.S.

April 23, 1934