Record of Survey.


No. 544

Township ....., North of Range 9-4-18 .....of 4 Principal Meridian as presented by the courses and distances on the following plat, and annexed field-notes of survey:

Established the center of the section at the point of intersection of STRAIGHT quarter lines.

Established all quarter-quarter corners upon the section boundary at proportional distances between known section and quarter section corners, according to the original field-notes of the Government survey.

Established all lost corners at proportionate distances between known corners, according to the original field notes of the Government survey.

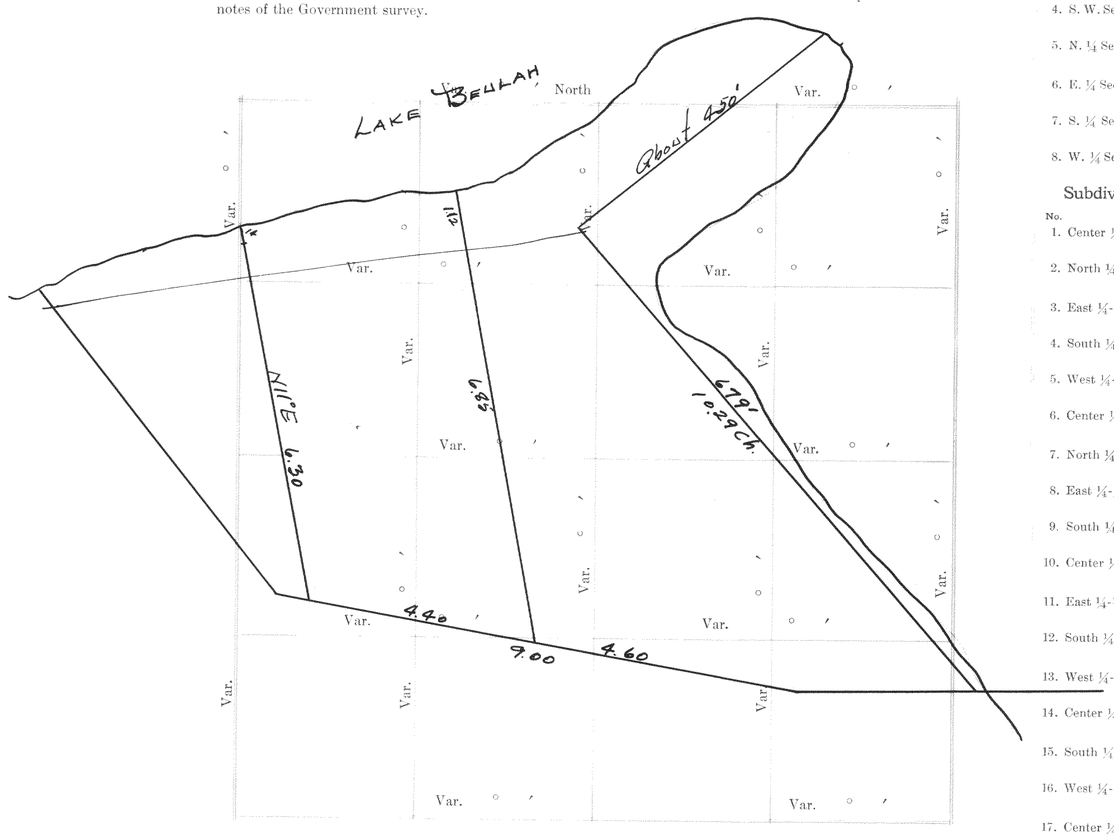

Plat of Section ....., Township ..... North, Range ..... of 4 Principal Meridian Scale 80 chains to 6 inches. The figures in red ink are the lengths of the lines as stated in the field-notes of the Government survey.

Declination of the Magnetic Meridian from the True Meridian .....

Surveyed and sub-divided ..... A. D. 1 , in accordance with the State Laws and Instructions of the Commissioner of the General Land office, and recorded on pages ..... of Register in the County Clerk's office.

Witness my hand this ..... day of ..... A. D. 1

..... SURVEYOR.

DESCRIPTION

OF SECTION, QUARTER SECTION AND QUARTER QUARTER SECTION CORNERS

N. C. MILLER CO., MFG. STATIONERS, MILWAUKEE X15000

GOVERNMENT CORNERS	Bearing Trees	In. Dia.	Courses they bear	Links Distant	Bearing Trees	In. Dia.	Courses they bear	Links Distant	Bearing Trees	In. Dia.	Courses they bear	Links Distant	Bearing Trees	In. Dia.	Courses they bear	Links Distant
No.																
1. N. W. Sec. Cor. indentified,																
2. N. E. Sec. Cor. indentified,																
3. S. E. Sec. Cor. indentified,																
4. S. W. Sec. Cor. indentified,																
5. N. ¼ Sec. Cor. indentified,																
6. E. ¼ Sec. Cor. indentified,																
7. S. ¼ Sec. Cor. indentified,																
8. W. ¼ Sec. Cor. indentified,																
Subdivision Corners																
No.																
1. Center ¼ Sec. Cor.																
2. North ¼-¼s N. W. qr.,																
3. East ¼-¼s N. W. qr.,																
4. South ¼-¼s N. W. qr.,																
5. West ¼-¼s N. W. qr.,																
6. Center ¼-¼s N. W. qr.,																
7. North ¼-¼s N. E. qr.,																
8. East ¼-¼s N. E. qr.,																
9. South ¼-¼s N. E. qr.,																
10. Center ¼-¼s N. E. qr.,																
11. East ¼-¼s S. E. qr.,																
12. South ¼-¼s S. E. qr.,																
13. West ¼-¼s S. E. qr.,																
14. Center ¼-¼s S. E. qr.,																
15. South ¼-¼s S. W. qr.,																
16. West ¼-¼s S. W. qr.,																
17. Center ¼-¼s S. W. qr.																

Description from survey —

Beginning at a stake at the Southeast corner of lands heretofore sold, said point being N 80° W 9 ch. from the ¼ sec. post on the South side of the NE ¼ of Section 9, T 4 N. R 18 E, Thence N 11° W along Mitchells East line 6.30 ch. to a stake (Wit. by W.O. Tree N 60° W .31½ ch.); Thence on the same course 14 lks. to the shore of Lake Beulah; Thence Easterly along the shore to a pt.; Thence S 11° E 1.12 chains to a stake which is S 87° E 4.24 chains from the stake last above mentioned; Thence on the same course 6.85 ch. to a stake which is N 80° W 4.60 chains from the aforesaid ¼ post; Thence N 80° W 4.40 ch. to the place of beginning, containing 2.85 Acres more or less.

Surveyed by Wm Child C.S.

Recorded by Floyd S. Fowler C.S.
May 3, 1934


NAMES OF SWORN ASSISTANTS

CHAINMEN	FLAGMEN	AXMEN

181 No. 545

DELAVAN CITY

18-2-16

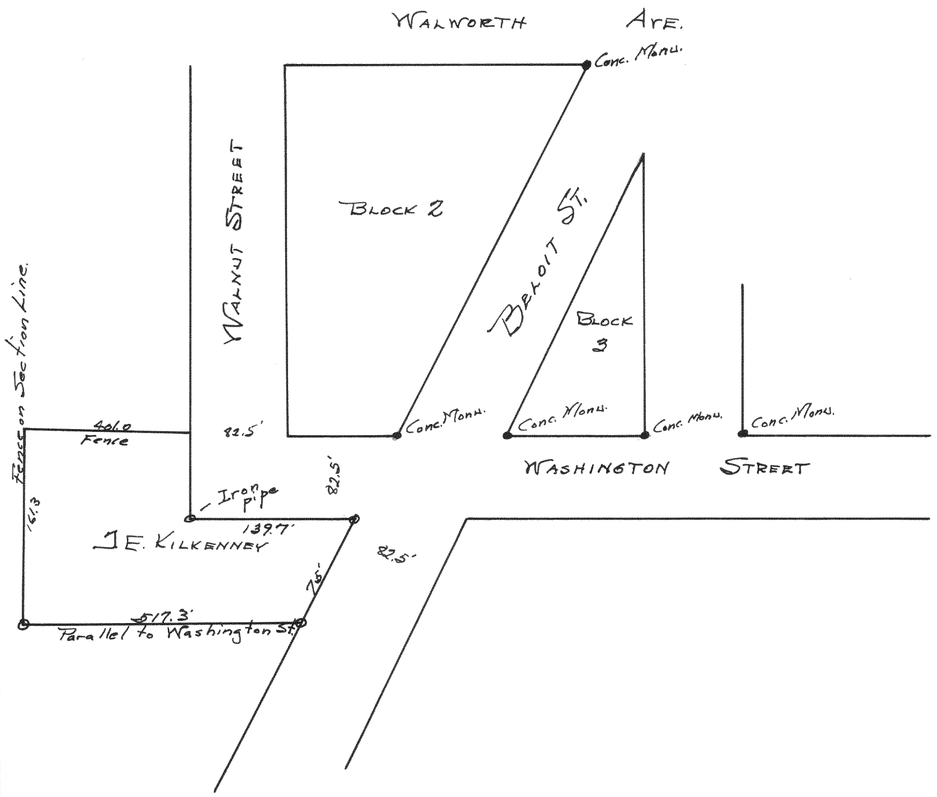

Plat of a survey in the Southwest 1/4 of Section 18, T2N, R16E for J.E. Kilkenney of Delavan. Concrete monuments were located as noted on the drawing. Iron pipes(o) were driven at the corners of the plot surveyed as shown. The fences on the West and North were used as the line.

Surveyed by Lloyd S. Jones C.S.
May 2, 1934