Record of Survey.


No. 550

Township LOTS 6 & 7 of Block 4 of Lipps' 2nd Add to Superior North of Baseline of 4 Principal Meridian as presented by the courses and distances on the following plat, and annexed field-notes of survey:

Established the center of the section at the point of intersection of STRAIGHT quarter lines.

Established all quarter-quarter corners upon the section boundary at proportional distances between known section and quarter section corners, according to the original field-notes of the Government survey.

Established all lost corners at proportionate distances between known corners, according to the original field notes of the Government survey.

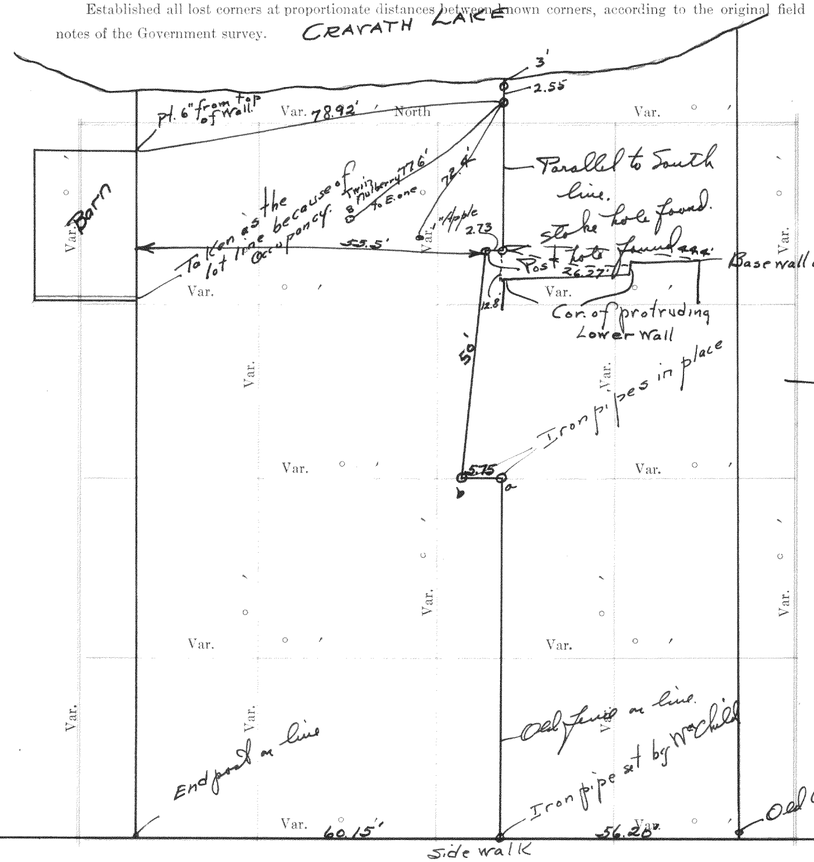

Plat of Section ..., Township ... North, Range ... of 4 Principal Meridian Scale 80 chains to 6 inches. The figures in red ink are the lengths of the lines as stated in the field-notes of the Government survey.

Declination of the Magnetic Meridian from the True Meridian ...

Surveyed and sub-divided ... A. D. 1 , in accordance with the State Laws and Instructions of the Commissioner of the General Land office, and recorded on pages ... of Register in the County Clerk's office.

Witness my hand this ... day of ... A. D. 1

... SURVEYOR.

DESCRIPTION

OF SECTION, QUARTER SECTION AND QUARTER QUARTER SECTION CORNERS

H. C. MILLER CO., MFG. STATIONERS, MILWAUKEE X15000

GOVERNMENT CORNERS No.	Bearing Trees	In. Dia.	Courses they bear	Links Distant	Bearing Trees	In. Dia.	Courses they bear	Links Distant	Bearing Trees	In. Dia.	Courses they bear	Links Distant	Bearing Trees	In. Dia.	Courses they bear	Links Distant
1. N. W. Sec. Cor. indentified,																
2. N. E. Sec. Cor. indentified,																
3. S. E. Sec. Cor. indentified,																
4. S. W. Sec. Cor. indentified,																
5. N. ¼ Sec. Cor. indentified,																
6. E. ¼ Sec. Cor. indentified,																
7. S. ¼ Sec. Cor. indentified,																
8. W. ¼ Sec. Cor. indentified,																
Subdivision Corners No.																
1. Center ¼ Sec. Cor.																
2. North ¼-¼s N. W. qr.,																
3. East ¼-¼s N. W. qr.,																
4. South ¼-¼s N. W. qr.,																
5. West ¼-¼s N. W. qr.,																
6. Center ¼-¼s N. W. qr.,																
7. North ¼-¼s N. E. qr.,																
8. East ¼-¼s N. E. qr.,																
9. South ¼-¼s N. E. qr.,																
10. Center ¼-¼s N. E. qr.,																
11. East ¼-¼s S. E. qr.,																
12. South ¼-¼s S. E. qr.,																
13. West ¼-¼s S. E. qr.,																
14. Center ¼-¼s S. E. qr.,																
15. South ¼-¼s S. W. qr.,																
16. West ¼-¼s S. W. qr.,																
17. Center ¼-¼s S. W. qr.																

On this survey the old fences were made use of to locate the lines. It checked the front ends & checked with Mr. Child in this work.

At pts. a & b I found iron pipes, at a pt. 50 feet west I found 2 iron pipes which were not correct. After digging I found an old post hole & stake hole as noted. From the last point West I placed the line parallel to the South line as is given in the description in the deed. This line fell a few inches S. of the old fence but both owners were present & they agreed to go by the description as given.

The South line was taken from the front corner post & the basement wall under the old ~~east~~ of barn.

Surveyed by Floyd L. Jensen
County Surveyor

May 15, 1934


NAMES OF SWORN ASSISTANTS

CHAINMEN	FLAGMEN	AXMEN

184

No 551

18-1-17

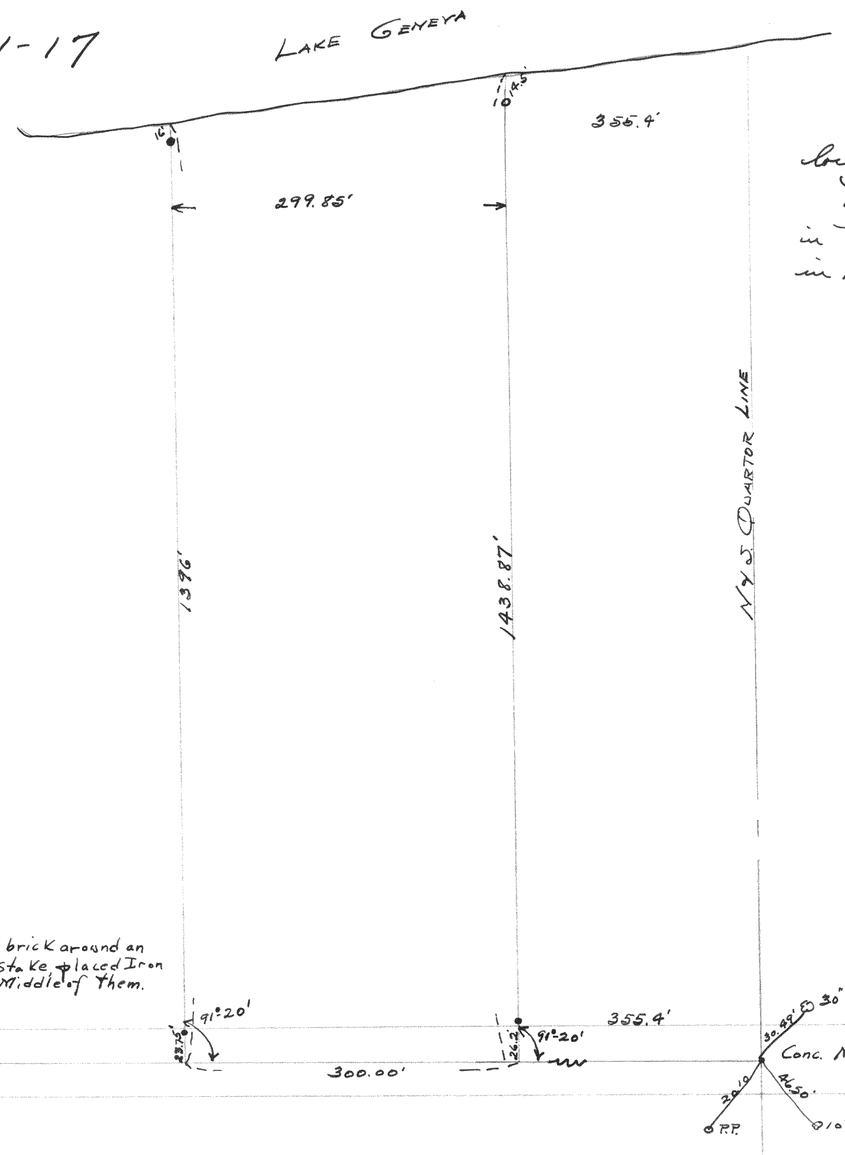

Plat of the survey of the Guyon property located in Fractional Section 18, T1N, R1E.

Monuments located & used by J. G. Skeels in his survey for the Court in 1930 were used in this survey.

Surveyed by Floyd S. Jensen
County Surveyor

May 18, 1934