Record of Survey.

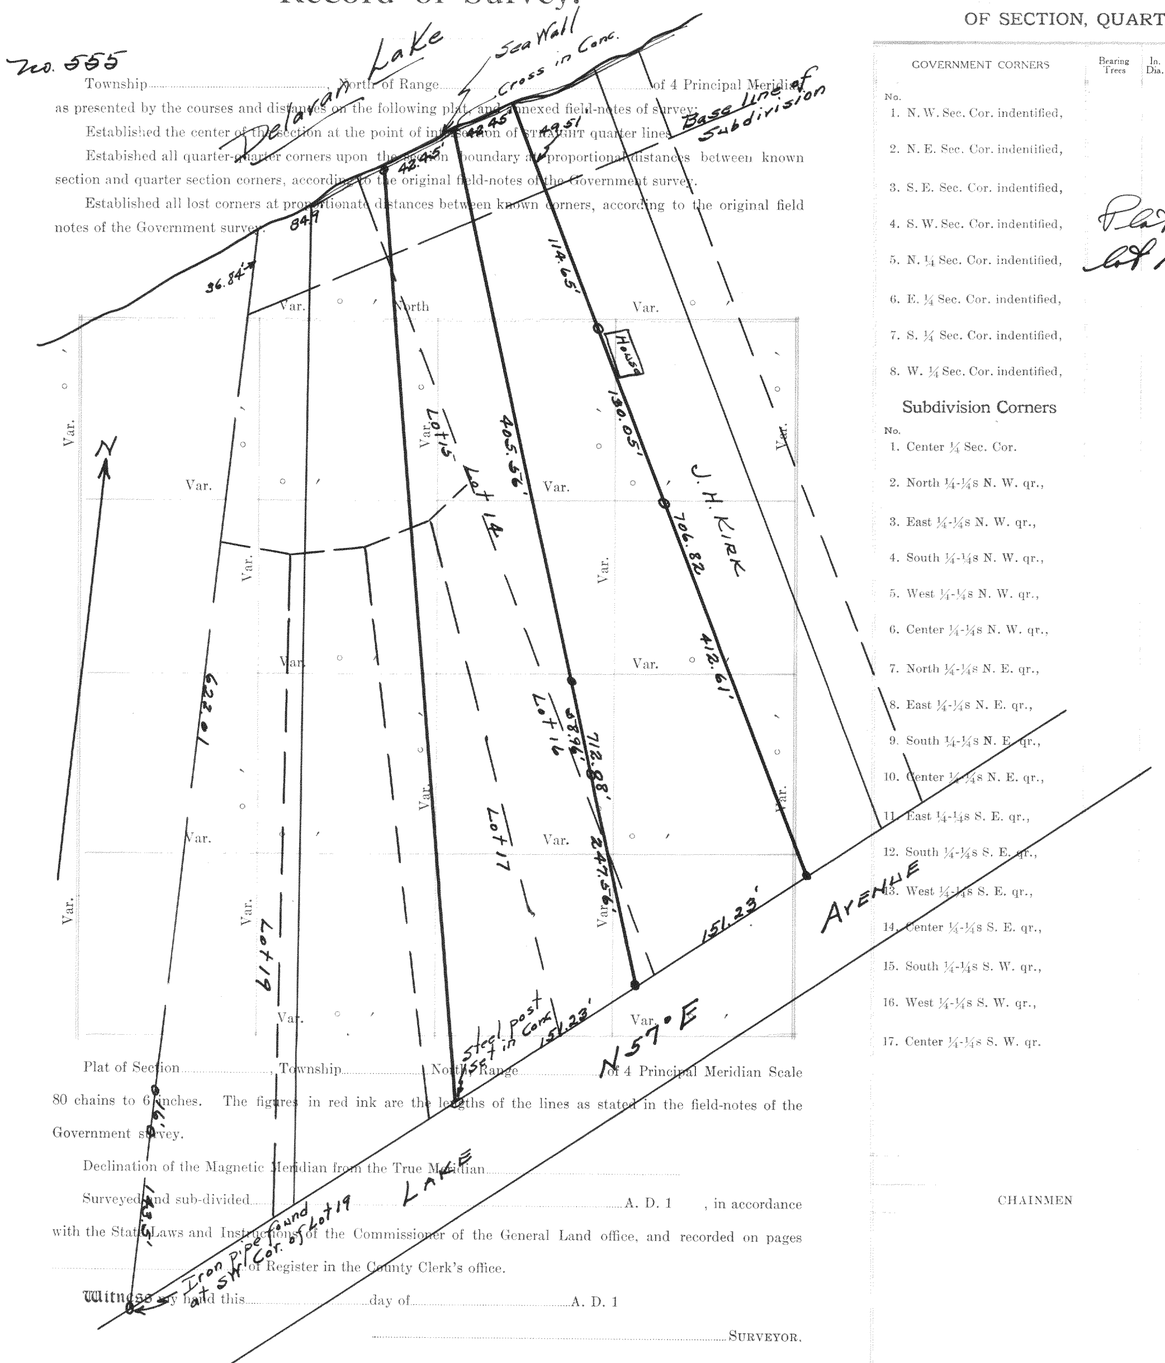
No. 555

Township ..... North of Range ..... of 4 Principal Meridian as presented by the courses and distances on the following plat, and annexed field-notes of survey.

Established the center of this section at the point of intersection of STRAIGHT quarter lines.

Established all quarter-quarter corners upon the section boundary at proportional distances between known section and quarter section corners, according to the original field-notes of the Government survey.

Established all lost corners at proportionate distances between known corners, according to the original field notes of the Government survey.

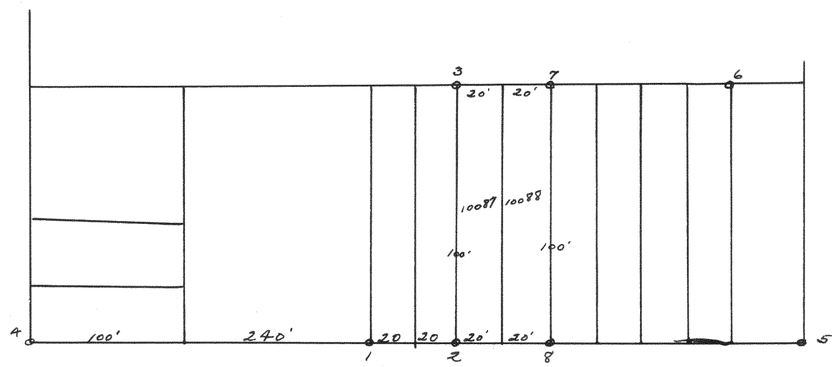

Lake
Sea Wall
Cross in Conc.
Base line of Subdivision
42.45'
49.51'
84.7'
36.84'
114.45'
Var.
North
Var.
Var.
Var.

No. 556 T31N, R15E

Measured from Finch School located in Section 11, T31N, R15E to the residence of George Virden, found distance to be 13,007 feet. Measured from Finch school to the residence of Mr. Meisner, found distance to be 13,804 feet or 2.61 miles.

Sept. 15, 1935
Floyd S. Jensen
Co. Sur.

No. 557 Lake Como Beach



Sahinwood Road

Found iron pipes at points numbered 1, 2, 3, 4, 5 & 6.

Placed pipes at points 7 & 8.

Floyd S. Jensen
Co. Sur.