Record of Survey.


No. 558

Township....., North of Range.....of 4 Principal Meridian as presented by the courses and distances on the following plat, and annexed field-notes of survey:

Established the center of the section at the point of intersection of STRAIGHT quarter lines.


Established all quarter-quarter corners upon the section boundary at proportional distances between known section and quarter section corners, according to the original field-notes of the Government survey.

Established all lost corners at proportionate distances between known corners, according to the original field notes of the Government survey.

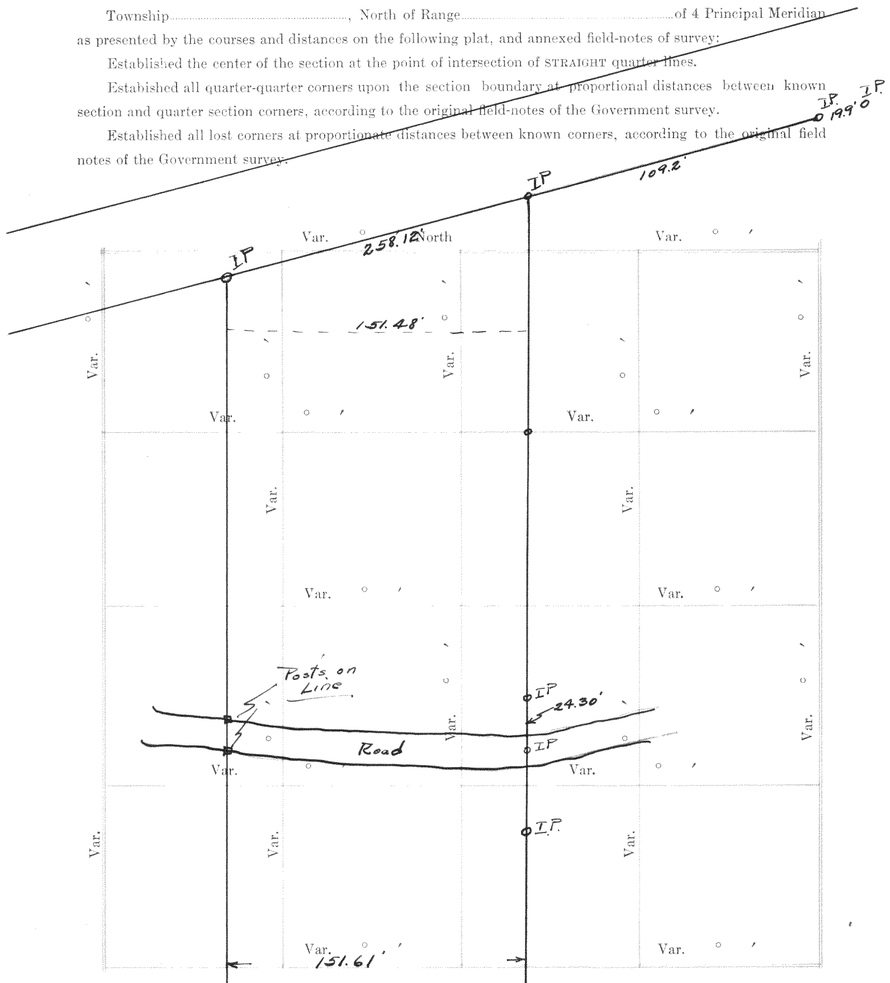
IP
199.0
IP
IP
109.2'
Var.
258.12 North
Var.
151.48'
Var.
Var.
Var.

187 No. 559

Bailey's Subd.

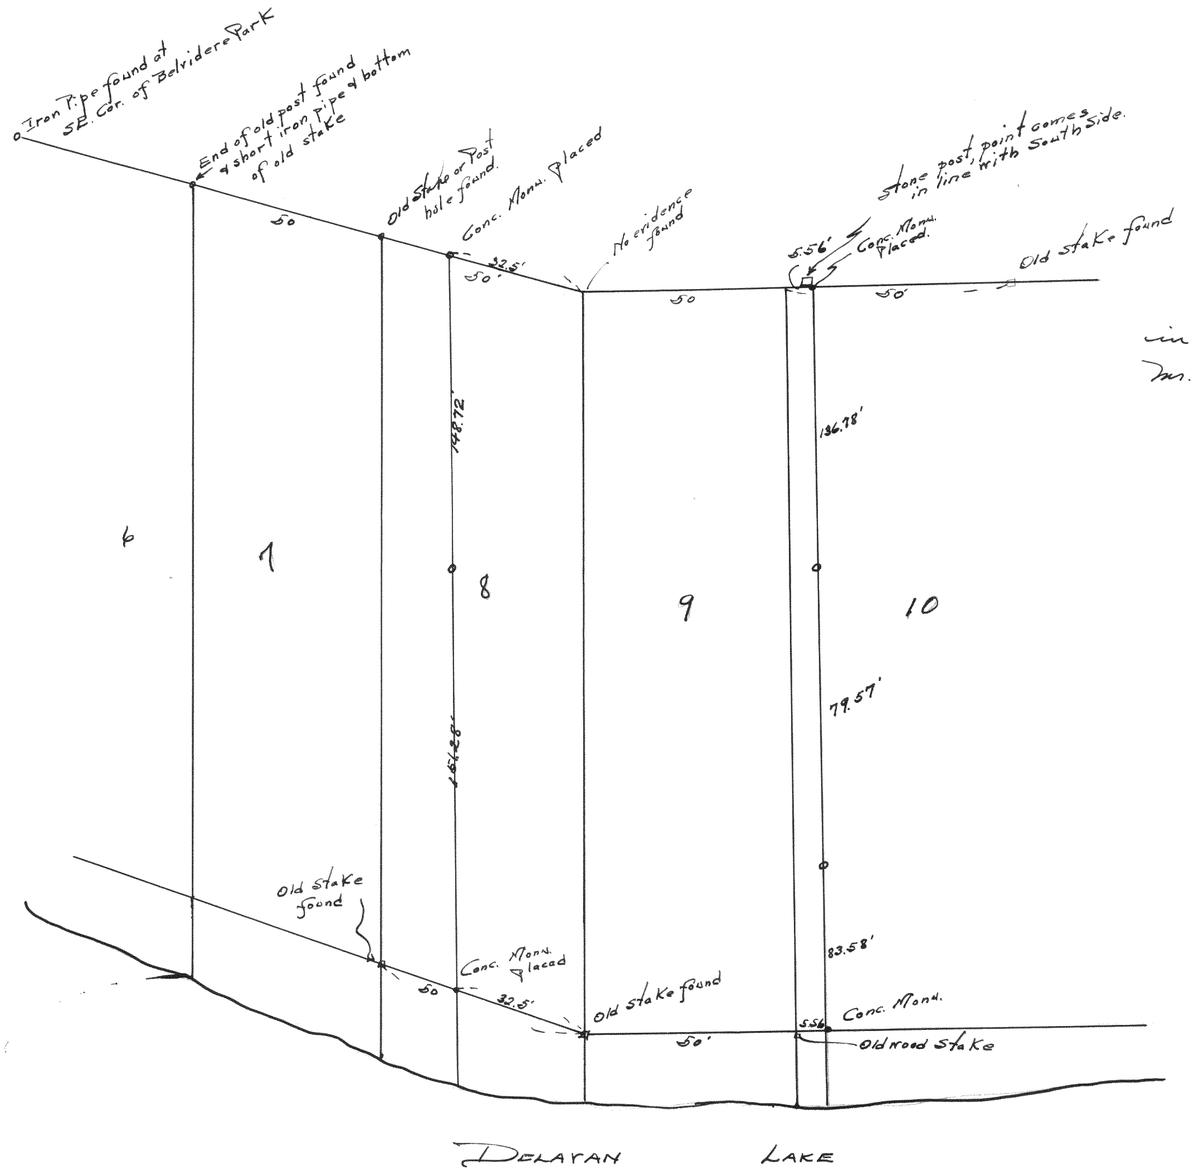

Survey of part of Bailey's Subd. located in the West ½ of Section 27, T27 N, R16E for Mrs. Lacham.

Floyd S. Jensen
Co. Sur.
1934