Record of Survey.

No. 566


25-3-15

Township....., North of Range.....of 4 Principal Meridian as presented by the courses and distances on the following plat, and annexed field-notes of survey:

Established the center of the section at the point of intersection of STRAIGHT quarter lines.

Estabished all quarter-quarter corners upon the section boundary at proportional distances between known section and quarter section corners, according to the original field-notes of the Government survey.

Established all lost corners at proportionate distances between known corners, according to the original field notes of the Government survey.

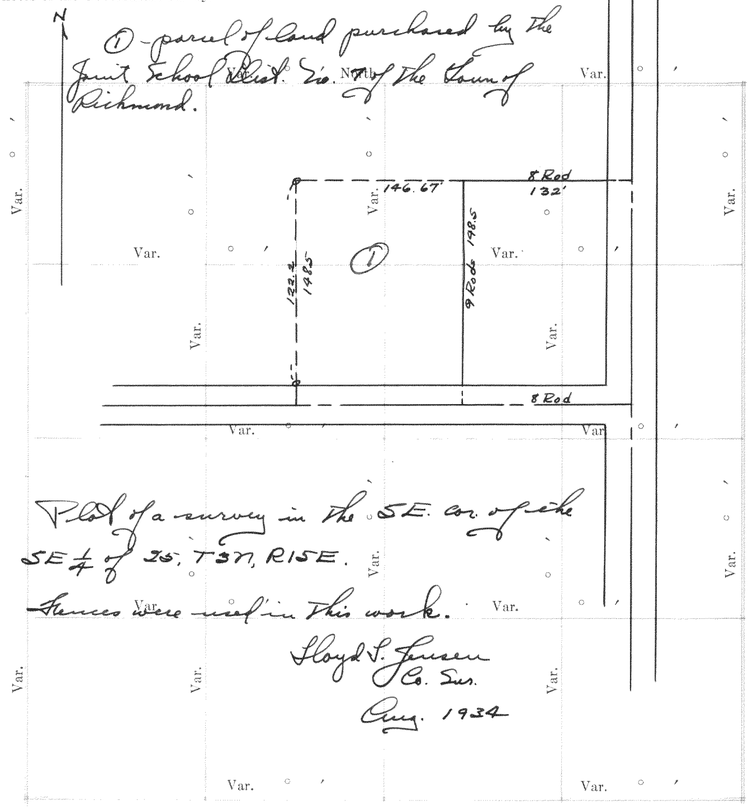

Plat of Section....., Township.....North, Range.....of 4 Principal Meridian Scale 80 chains to 6 inches. The figures in red ink are the lengths of the lines as stated in the field-notes of the Government survey.

Declination of the Magnetic Meridian from the True Meridian.....

Surveyed and sub-divided.....A. D. 1 , in accordance with the State Laws and Instructions of the Commissioner of the General Land office, and recorded on pages .....of Register in the County Clerk's office.

Witness my hand this.....day of.....A. D. 1

.....SURVEYOR.

DESCRIPTION

190


OF SECTION, QUARTER SECTION AND QUARTER QUARTER SECTION CORNERS

H. C. MILLER CO., MFG. STATIONERS, MILWAUKEE X15000

GOVERNMENT CORNERS	Bearing Trees	In. Dia.	Courses they bear	Links Distant	Bearing Trees	In. Dia.	Courses they bear	Links Distant	Bearing Trees	In. Dia.	Courses they bear	Links Distant	Bearing Trees	In. Dia.	Courses they bear	Links Distant
No.																
1. N. W. Sec. Cor. indentified,																
2. N. E. Sec. Cor. indentified,																
3. S. E. Sec. Cor. indentified,																
4. S. W. Sec. Cor. indentified,																
5. N. ¼ Sec. Cor. indentified,																
6. E. ¼ Sec. Cor. indentified,																
7. S. ¼ Sec. Cor. indentified,																
8. W. ¼ Sec. Cor. indentified,																
Subdivision Corners																
No.																
1. Center ¼ Sec. Cor.																
2. North ¼-¼s N. W. qr.,																
3. East ¼-¼s N. W. qr.,																
4. South ¼-¼s N. W. qr.,																
5. West ¼-¼s N. W. qr.,																
6. Center ¼-¼ N. W. qr.,																
7. North ¼-¼s N. E. qr.,																
8. East ¼-¼s N. E. qr.,																
9. South ¼-¼s N. E. qr.,																
10. Center ¼-¼s N. E. qr.,																
11. East ¼-¼s S. E. qr.,																
12. South ¼-¼s S. E. qr.,																
13. West ¼-¼s S. E. qr.,																
14. Center ¼-¼s S. E. qr.,																
15. South ¼-¼s S. W. qr.,																
16. West ¼-¼s S. W. qr.,																
17. Center ¼-¼s S. W. qr.																

No. 567

FONTANA - LAKE VIEW SUBD.

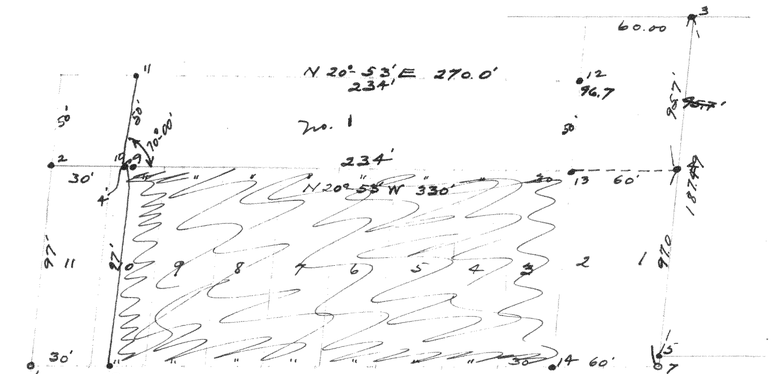

Prop owned by Land Co. - lots 3 - 9 & The N ⅔ of lot 10.
Found Conc. mons. at points marked 1, 2, 3, 4, 5
" Iron pipes at " " 6 & 7
Set conc. mons. at " " 8, 9, 10, 11, 12, 13 & 14
Parcel No. 1. purchased by a metes & bounds description and ownership found of the property owned in the Subd.
Found all measurements to check the recorded plat of Fontana. Survey for Palmer Boat Co.


Lloyd S. Jensen
Co. Sur.

NAMES OF SWORN ASSISTANTS

CHAINMEN	FLAGMEN	AXMEN

No. 568 DELAYAN LAKE

COLLIES GROVE

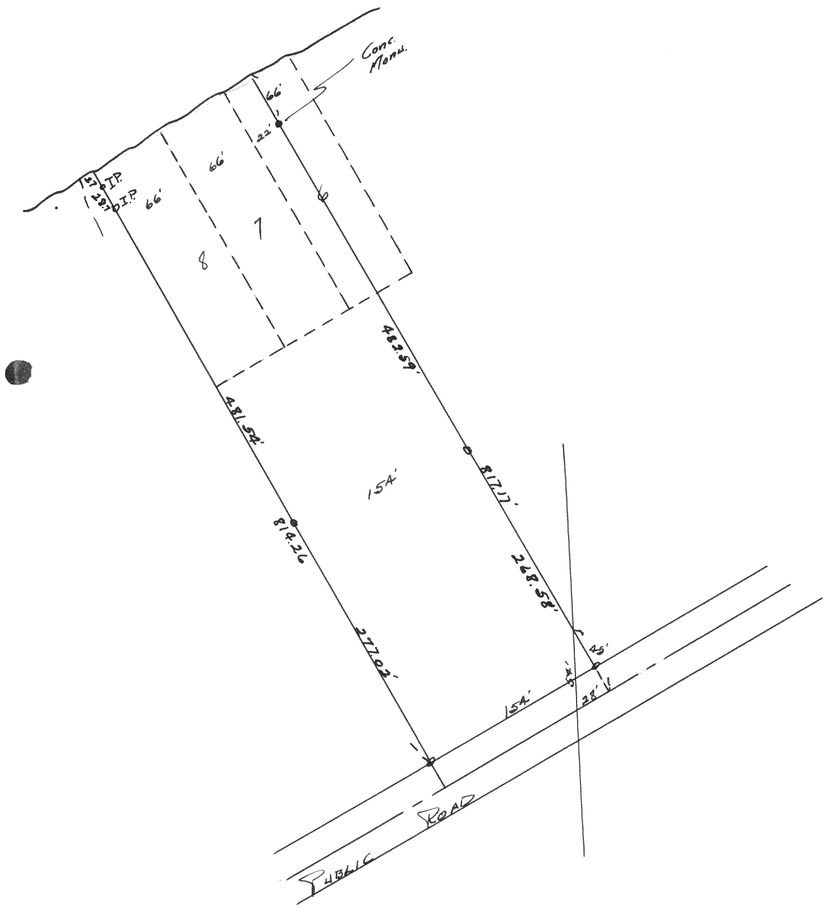


Plat of a survey for Sedmes B. Van Hees of Chicago. Survey made to determine if description & fences in the field checked, and we found that they did.

Lloyd V. Jensen
Co. Sur.
Sept. 12, 1934

No. 569 DELAYAN CITY

LOT 1 & 2 of BLOCK 13

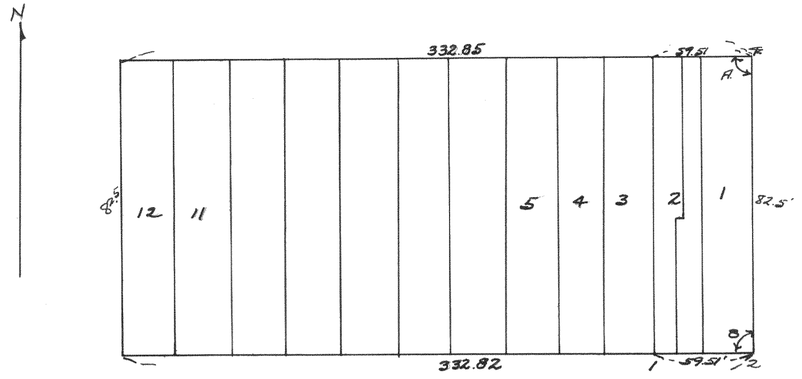

Platted distance for block = 330.00
Field Meas. = 332.85 & 82 as shown.
Block lines gotten from concrete monuments at corners of adjoining blocks as shown on the City Plat.
Angle "A" = 89°-53'
" "B" = 90°-07'
Corner No 1. is cross cut in conc. step and line falls 0.6' E. of West line of building.
Corner No. 2 - cross cut in conc. of alley drive
Corners at North end of lot are crosses cut in the sike walk.

Surveyed by Lloyd V. Jensen
Co. Sur.