No. 570


Record of Survey.

Township Pell Lake Subd., North of Range ..... of 4 Principal Meridian as presented by the courses and distances on the following plat, and annexed field-notes of survey:

Established the center of the section at the point of intersection of STRAIGHT quarter lines.

Established all quarter-quarter corners upon the section boundary at proportional distances between known section and quarter section corners, according to the original field-notes of the Government survey.

Established all lost corners at proportionate distances between known corners, according to the original field notes of the Government survey.

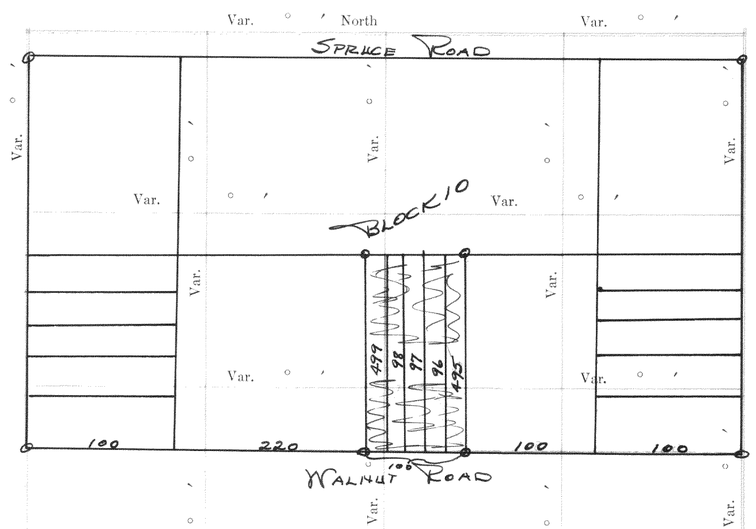

Plat of survey of 5 lots in block 10 of Pell Lake Subd
Found iron pipe as shown on the drawing and found
that the block measured as given in Plat.
The sales plats of these blocks show an extra lot
but the recorded plat does not. Stakes driven at the corners
of the block of 5 lots.
Surveyed by Lloyd S. Jensen Co. Sur.

Plat of Section ....., Township ..... North, Range ..... of 4 Principal Meridian Scale 80 chains to 6 inches. The figures in red ink are the lengths of the lines as stated in the field-notes of the Government survey.

Declination of the Magnetic Meridian from the True Meridian .....

Surveyed and sub-divided ..... A. D. 1 , in accordance with the State Laws and Instructions of the Commissioner of the General Land office, and recorded on pages ..... of Register in the County Clerk's office.

Witness my hand this ..... day of ..... A. D. 1

..... SURVEYOR.


DESCRIPTION

OF SECTION, QUARTER SECTION AND QUARTER QUARTER SECTION CORNERS

N. C. MILLER CO., MFG. STATIONERS, MILWAUKEE X15000

GOVERNMENT CORNERS	Bearing Trees	In. Dia.	Courses they bear	Links Distant	Bearing Trees	In. Dia.	Courses they bear	Links Distant	Bearing Trees	In. Dia.	Courses they bear	Links Distant	Bearing Trees	In. Dia.	Courses they bear	Links Distant
No.																
1. N. W. Sec. Cor. indentified,																
2. N. E. Sec. Cor. indentified,																
3. S. E. Sec. Cor. indentified,																
4. S. W. Sec. Cor. indentified,																
5. N. ¼ Sec. Cor. indentified,																
6. E. ¼ Sec. Cor. indentified,																
7. S. ¼ Sec. Cor. indentified,																
8. W. ¼ Sec. Cor. indentified,																
Subdivision Corners																
No.																
1. Center ¼ Sec.																
2. North ¼-¼s N. W. qr.,																
3. East ¼-¼s N. W. qr.,																
4. South ¼-¼s N. W. qr.,																
5. West ¼-¼s N. W. qr.,																
6. Center ¼-¼s N. W. qr.,																
7. North ¼-¼s N. E. qr.,																
8. East ¼-¼s N. E. qr.,																
9. South ¼-¼s N. E. qr.,																
10. Center ¼-¼s N. E. qr.,																
11. East ¼-¼s S. E. qr.,																
12. South ¼-¼s S. E. qr.,																
13. West ¼-¼s S. E. qr.,																
14. Center ¼-¼s S. E. qr.,																
15. South ¼-¼s S. W. qr.,																
16. West ¼-¼s S. W. qr.,																
17. Center ¼-¼s S. W. qr.																

No. 571

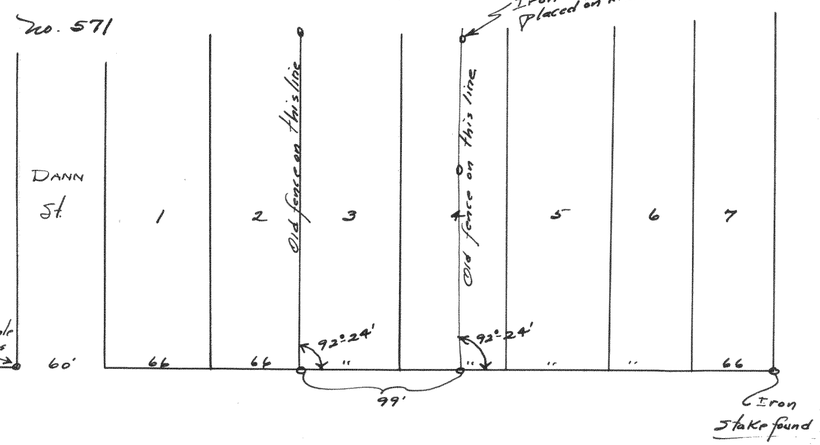

Survey of Lot 3 & 1/2 of Lot 4 of Etterly's Add. to the City of Whitewater, for Paula Stegeman Prieve.

Lloyd S. Jensen
Co. Sur.
Sept 29, 1934

NAMES OF SWORN ASSISTANTS

CHAINMEN	FLAGMEN	AXMEN


No. 572 NW 1/4 of Sec. 4, T4N, R18E

Millcite Subd.

Relocated the original corners of lots 15, 16, 17, 18, 19, 20, 21, 22, 23, 24, 25, 26 & 27 & 28 of the Millcite Subdivision.

Lloyd V. Jensen
Co Sur.

No. 573 Indian Hills Subd.
14-1-16

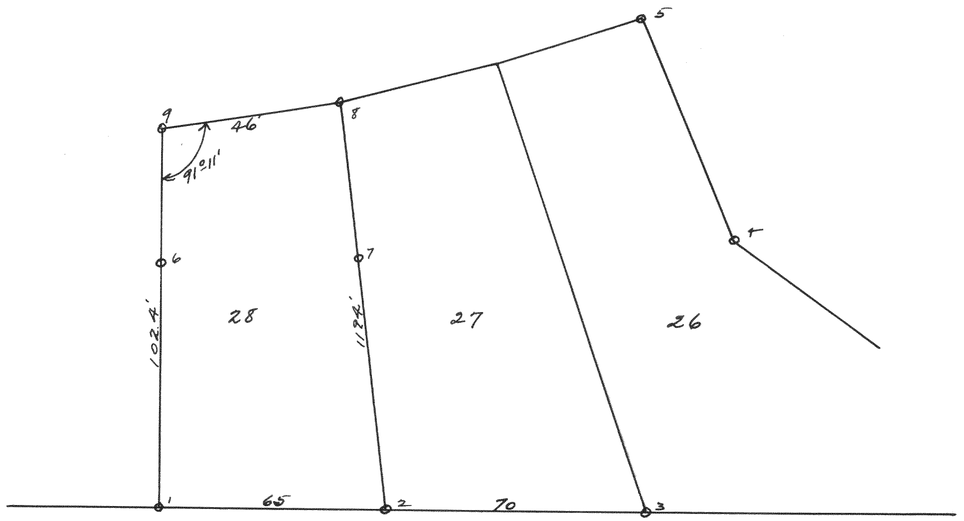


Survey of lot 28 of Block 1 of Indian Hills, located in sec. 14-1-16, Village of Fontana.
Iron pipes found at 1, 2, 3, 4 & 5.
" " set at 6, 7, 8 & 9

Lloyd V. Jensen
Co. Sur.
Oct. 16, 1934

No. 574

WHITEWATER CITY

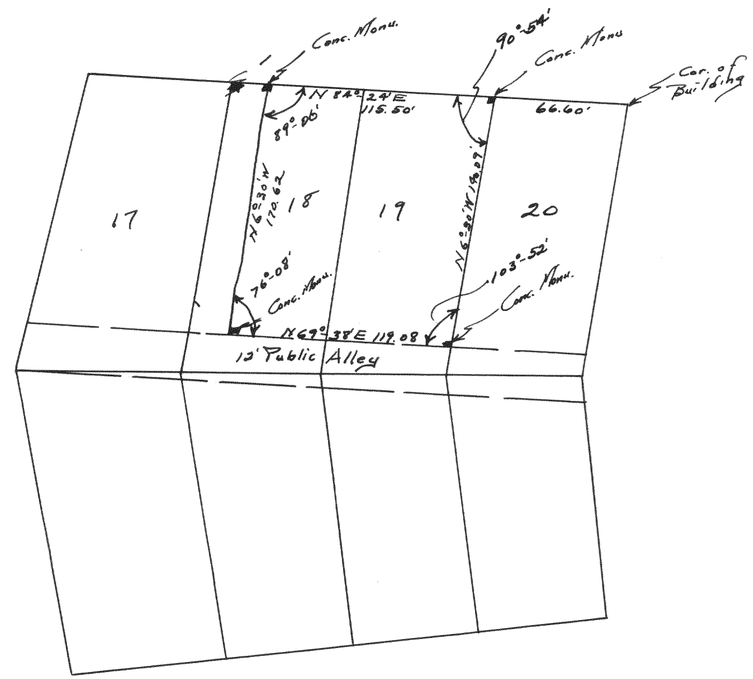

Plat of a survey of lot 19 & all of lot 18 except the West 16.5 feet of lot 18 of block 14 of the original City of Whitewater.
Survey for Postoffice site.

Lloyd V. Jensen
Co. Sur.
Oct. 1934